PROPOSED VIDEO DETECTION CAMERA

A

REVISION A

SHOP FORCES INSTALLED
VIDEO DETECTION FOR
I-95/I-495 OFF RAMP 10/24/2002

12" PROPOSED SIGNALS

1,2,3,
4,5

R
Y
G

3M TYPE HEADS

6,7,8

NEW
R
Y
G

TEMPORARY SIGN
W3-3 NEW
48" X 48"

PROPOSED SIGNS

9

YIELD

FIBER OPTIC
R1-2
36"

10

SHOULDER
USE OK

FIBER OPTIC BLANK OUT SIGN
FO-GM-1 REMOVED FROM MD 214

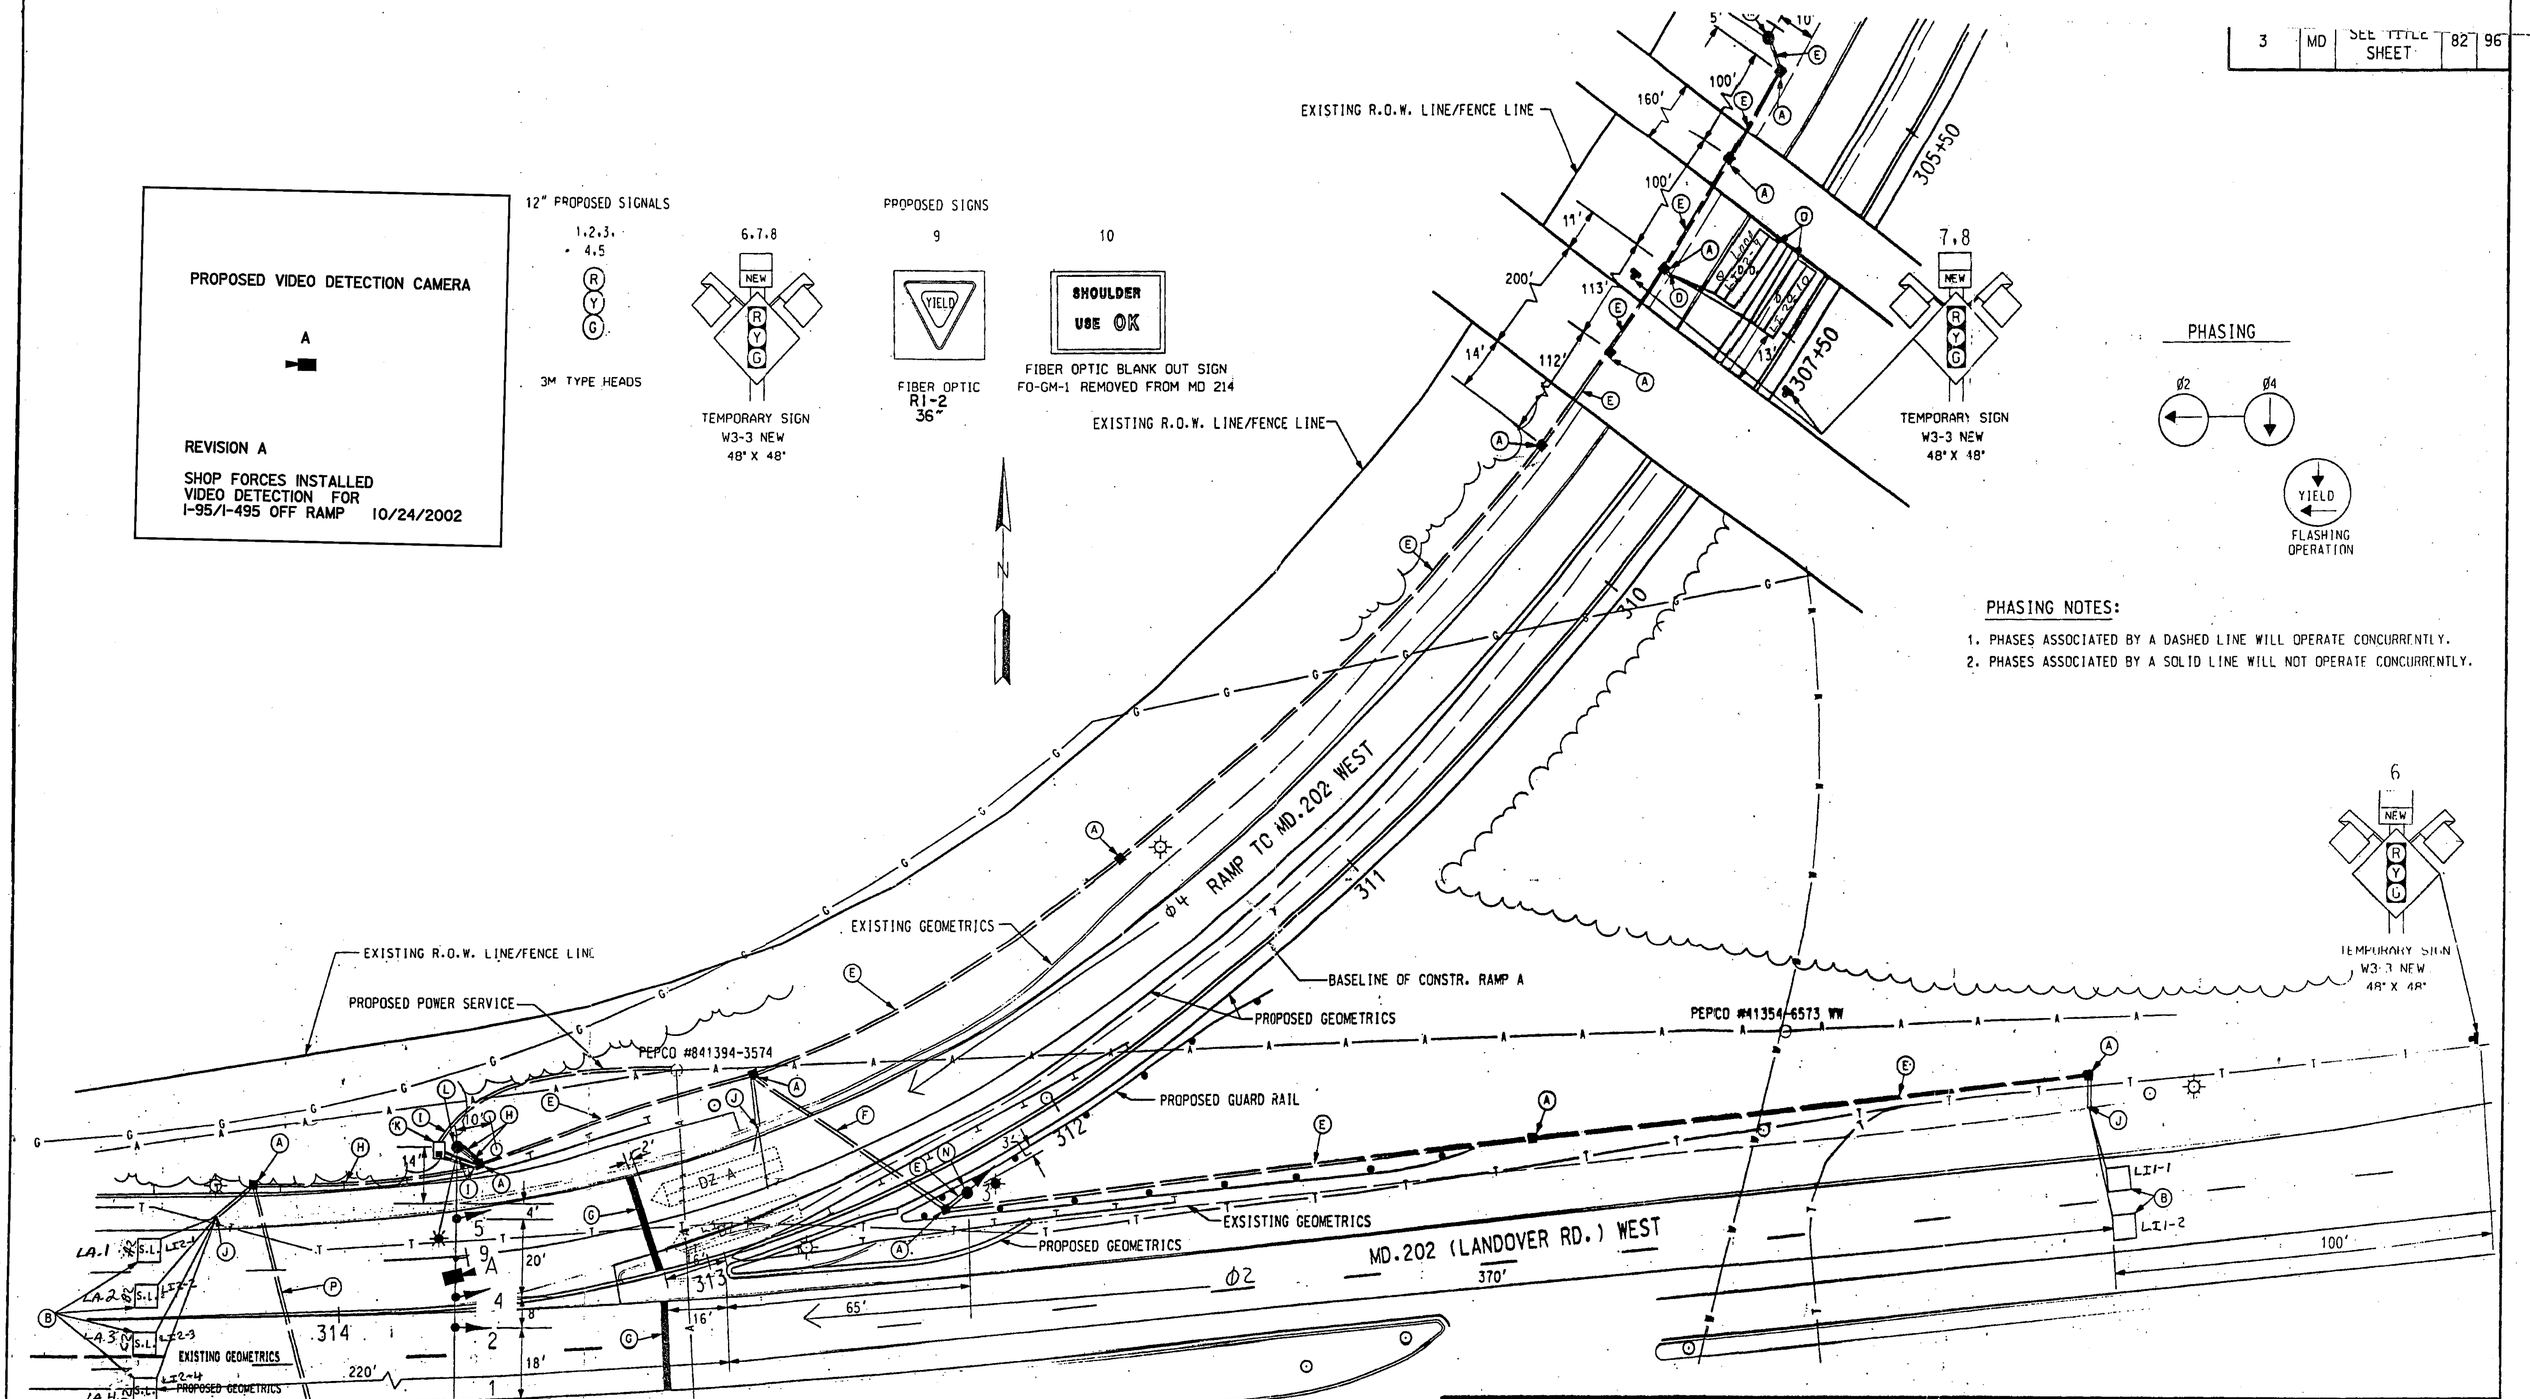

PHASING

PHASING NOTES:

1. PHASES ASSOCIATED BY A DASHED LINE WILL OPERATE CONCURRENTLY.
2. PHASES ASSOCIATED BY A SOLID LINE WILL NOT OPERATE CONCURRENTLY.

LEGEND OF UTILITIES

A	A	AERIAL
G	G	GAS MAIN
W	W	WATER MAIN
S	S	SEWER MAIN
E	E	ELECTRIC CABLES
T	T	TELEPHONE CABLES
C	C	CABLE TELEVISION

REVISIONS	APPROVALS	REVISIONS
A SHOP FORCES INSTALLED VIDEO DETECTION FOR I-495 OFF RAMP 10/2002	CHIEF, DESIGN SECTION 8/19/96 ASST. DISTRICT ENGINEER, TRAFFIC CHIEF, TRAFFIC ENGINEERING DESIGN DIVISION 8/19/96 DIRECTOR, TRAFFIC & SAFETY 9/2	

JOHNSON, MIRMIRAN & THOMPSON, P.A.
SPARKS, MARYLAND

MARYLAND DOT - STATE HIGHWAY ADMINISTRATION
Office of Traffic & Safety
TRAFFIC ENGINEERING DESIGN DIVISION

I-95 SB TO MD. 202 WB RAMP @ MD 202 WB
SIGNAL NO. 16020209.72

DRAWN BY: C.W.H.	F.A.P. NO.		TS NO.	SHEET NO.
CHK. BY: M.J.W.	S.H.A. NO.	P 189-Z-272	3623 A	1 OF 1
SCALE: 1"=20'	COUNTY	PRINCE GEORGE'S		
DATE: 7/17/96				