F H WA REGION NO	STATE	FED. AID PROJ. NO	SHT. NO.	TOTAL SHEETS
3	MD.			

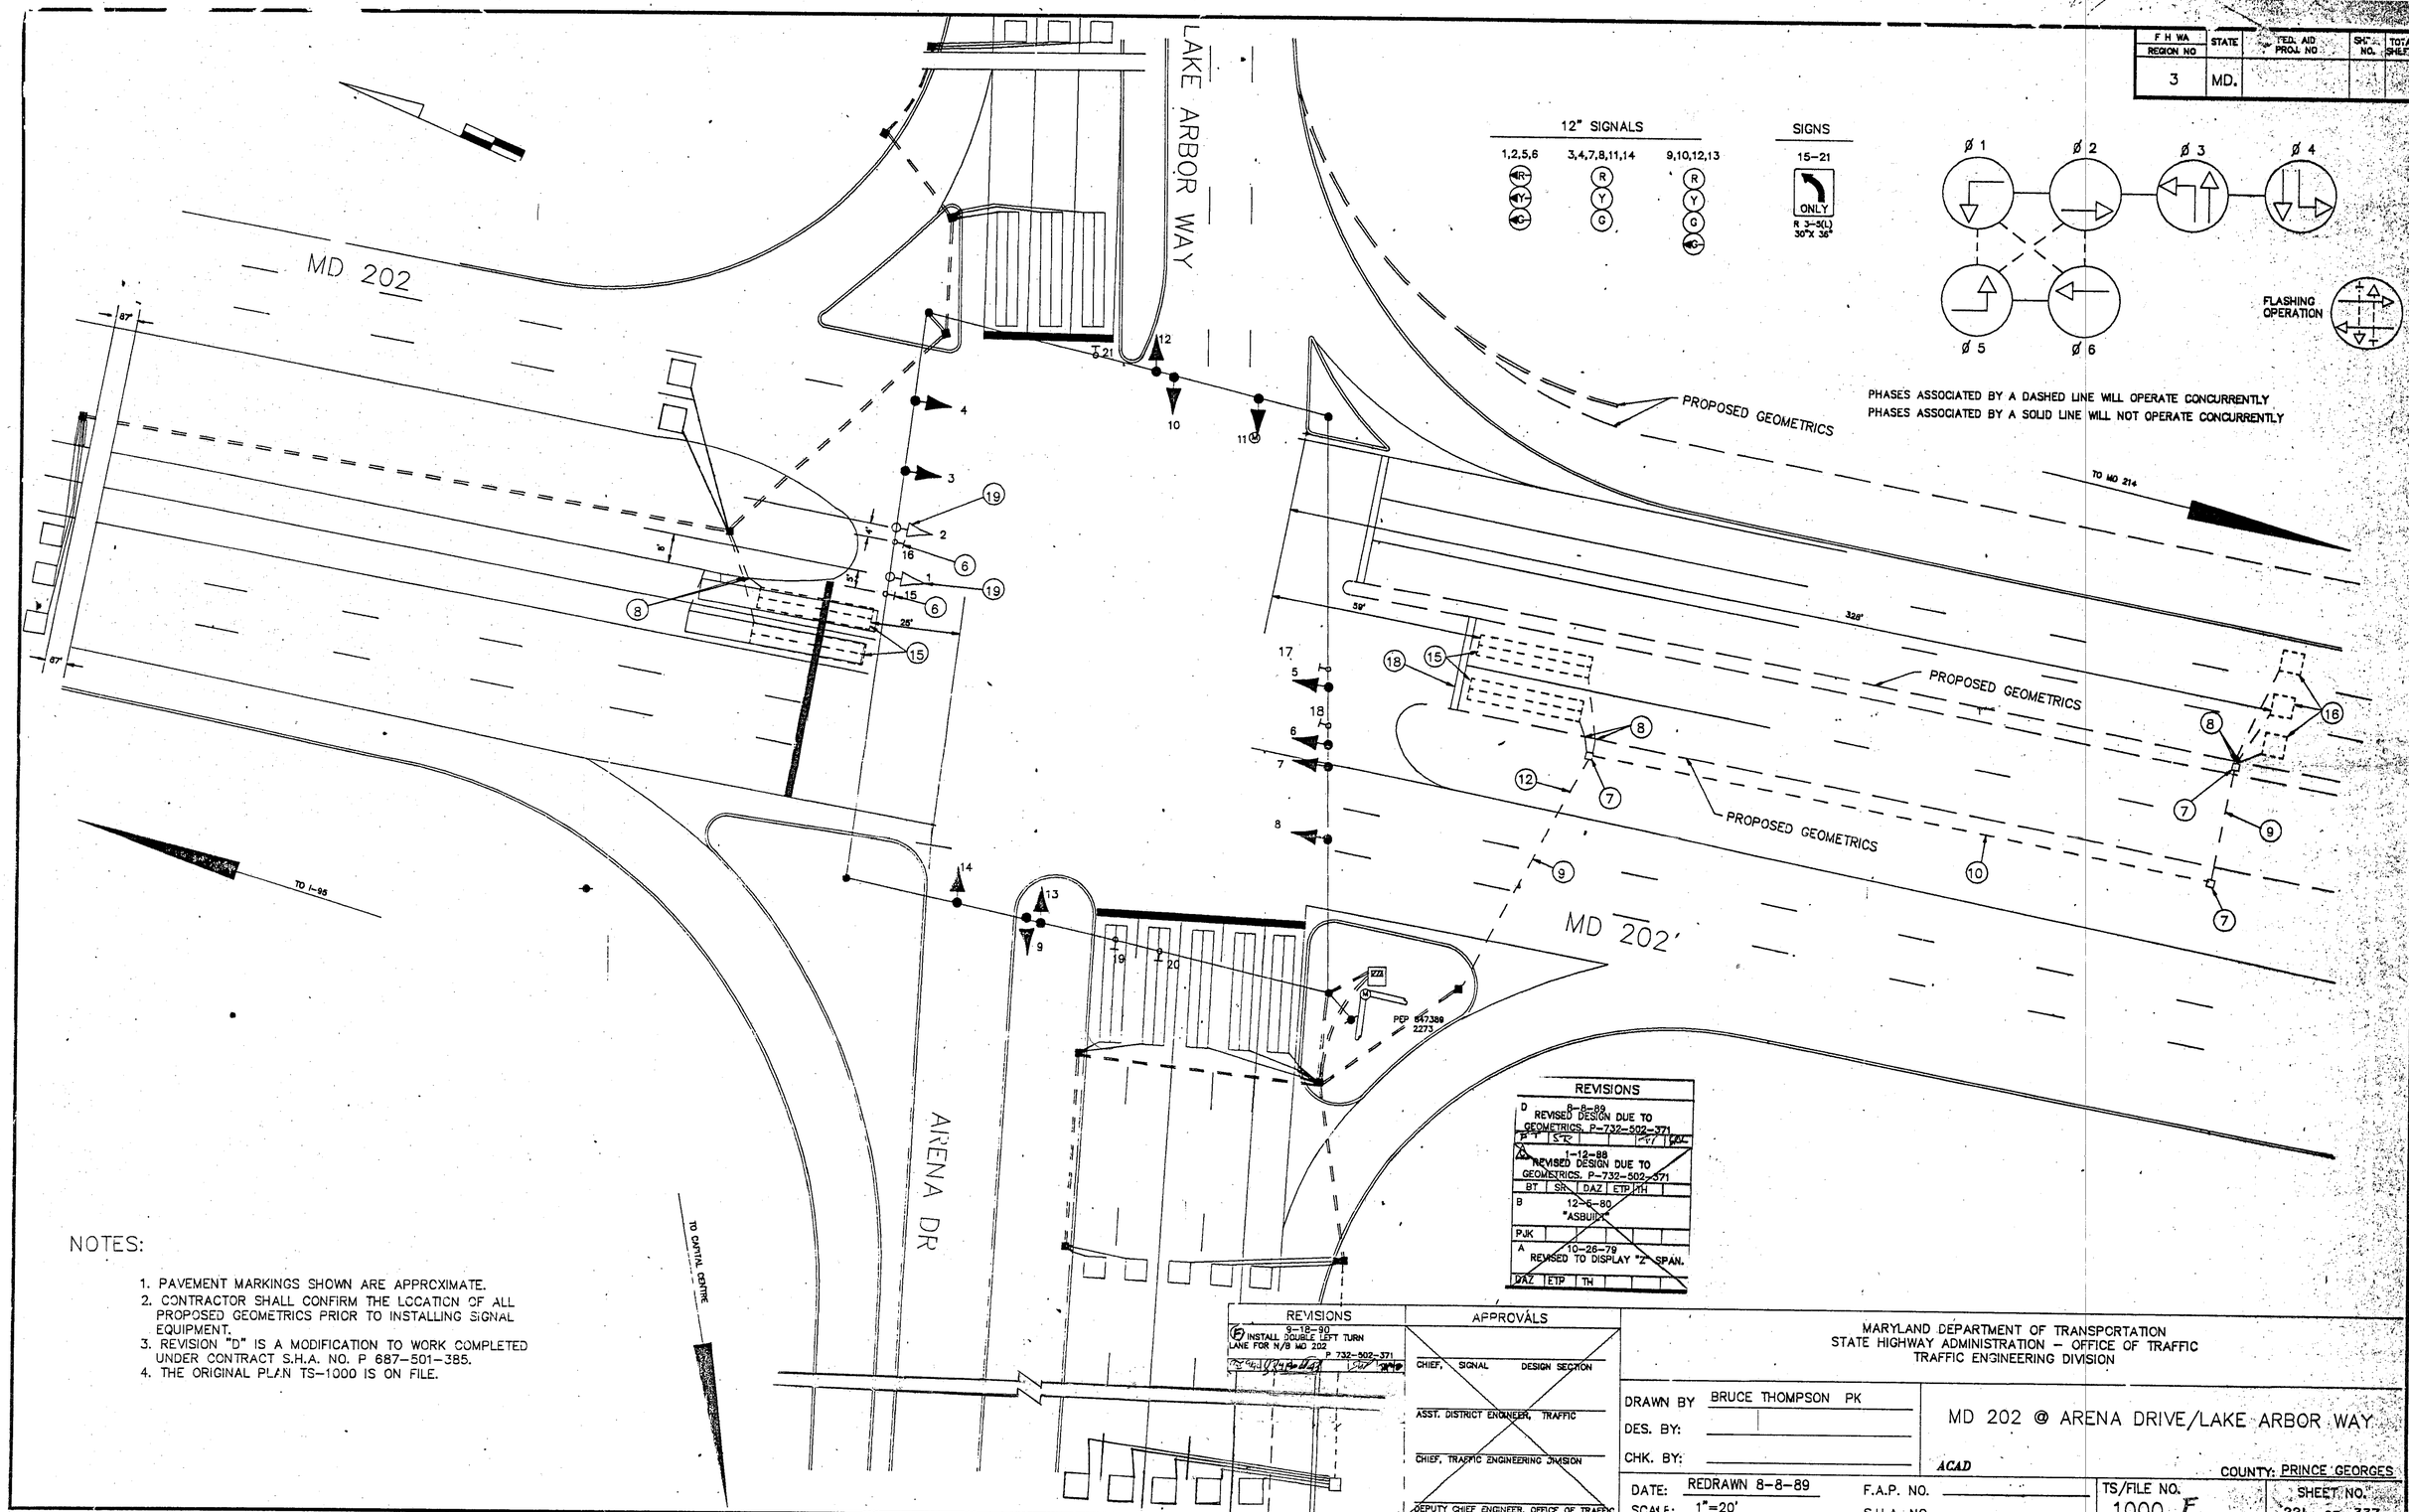

NOTES:

1. PAVEMENT MARKINGS SHOWN ARE APPROXIMATE.
2. CONTRACTOR SHALL CONFIRM THE LOCATION OF ALL PROPOSED GEOMETRICS PRIOR TO INSTALLING SIGNAL EQUIPMENT.
3. REVISION "D" IS A MODIFICATION TO WORK COMPLETED UNDER CONTRACT S.H.A. NO. P 687-501-385.
4. THE ORIGINAL PLAN TS-1000 IS ON FILE.

16020208.08