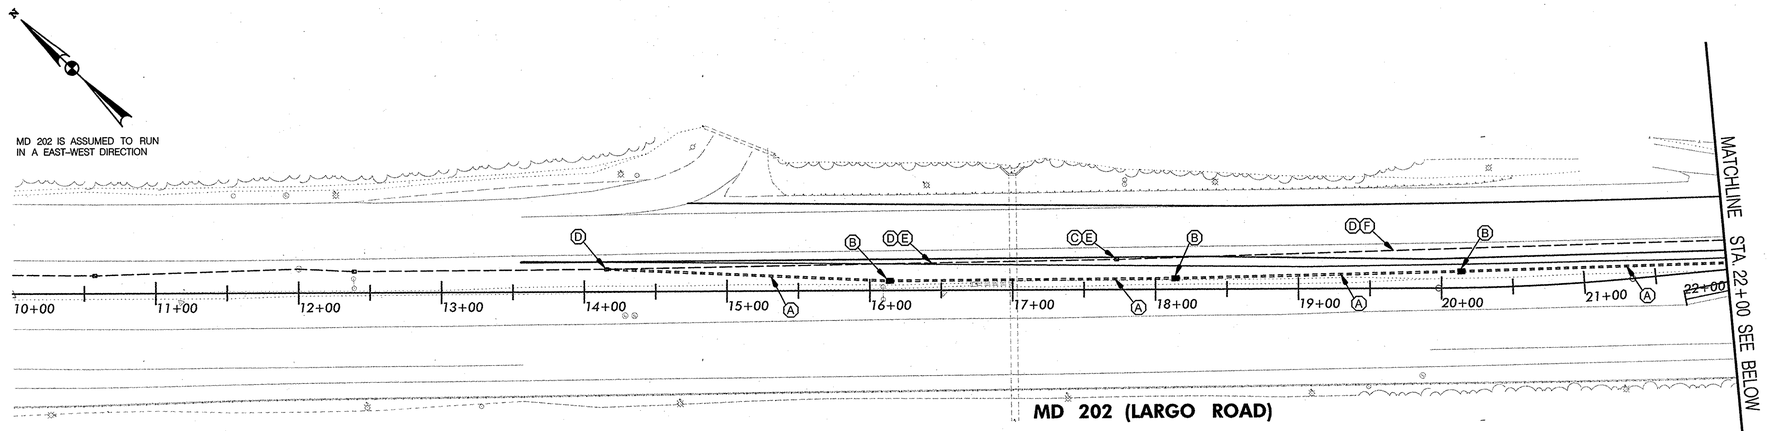

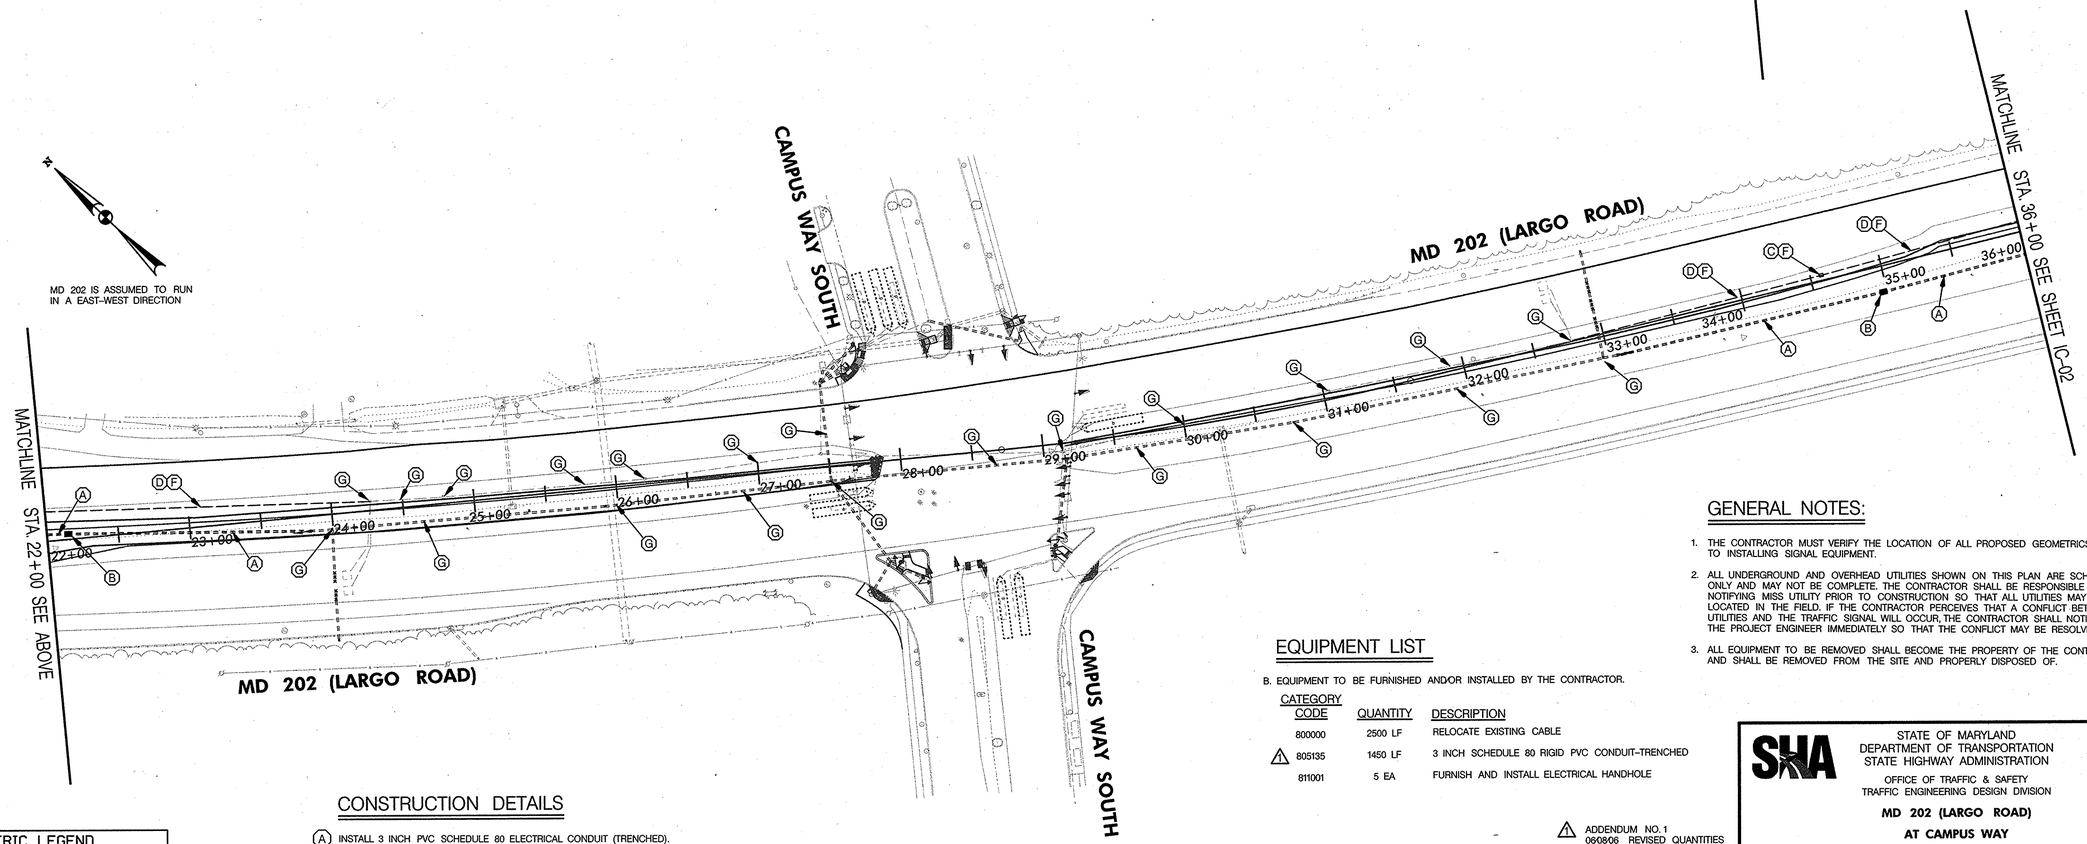

GENERAL NOTES:

1. THE CONTRACTOR MUST VERIFY THE LOCATION OF ALL PROPOSED GEOMETRICS PRIOR TO INSTALLING SIGNAL EQUIPMENT.
2. ALL UNDERGROUND AND OVERHEAD UTILITIES SHOWN ON THIS PLAN ARE SCHEMATIC ONLY AND MAY NOT BE COMPLETE. THE CONTRACTOR SHALL BE RESPONSIBLE FOR NOTIFYING MISS UTILITY PRIOR TO CONSTRUCTION SO THAT ALL UTILITIES MAY BE LOCATED IN THE FIELD. IF THE CONTRACTOR PERCEIVES THAT A CONFLICT BETWEEN UTILITIES AND THE TRAFFIC SIGNAL WILL OCCUR, THE CONTRACTOR SHALL NOTIFY THE PROJECT ENGINEER IMMEDIATELY SO THAT THE CONFLICT MAY BE RESOLVED.
3. ALL EQUIPMENT TO BE REMOVED SHALL BECOME THE PROPERTY OF THE CONTRACTOR AND SHALL BE REMOVED FROM THE SITE AND PROPERLY DISPOSED OF.

EQUIPMENT LIST

B. EQUIPMENT TO BE FURNISHED AND/OR INSTALLED BY THE CONTRACTOR.

CATEGORY CODE	QUANTITY	DESCRIPTION
800000	2500 LF	RELOCATE EXISTING CABLE
1 805135	1450 LF	3 INCH SCHEDULE 80 RIGID PVC CONDUIT-TRENCHED
811001	5 EA	FURNISH AND INSTALL ELECTRICAL HANDHOLE

1 ADDENDUM NO. 1
060806 REVISED QUANTITIES

CONSTRUCTION DETAILS

(A) INSTALL 3 INCH PVC SCHEDULE 80 ELECTRICAL CONDUIT (TRENCHED).

(B) INSTALL ELECTRICAL HANDHOLE.

(C) PULL BACK EXISTING INTERCONNECT CABLE FROM EXISTING HANDHOLE. PULL EXISTING INTERCONNECT CABLE THROUGH NEW HANDHOLE.

(D) PULL BACK EXISTING INTERCONNECT CABLE FROM EXISTING CONDUIT. PULL EXISTING INTERCONNECT CABLE THROUGH NEW CONDUIT.

(E) ABANDON EXISTING HANDHOLE/CONDUIT.

(F) REMOVAL OF EXISTING HANDHOLE/CONDUIT SHALL BE INCIDENTAL TO CLASS II EXCAVATION.

(G) SEE TRAFFIC SIGNAL PLANS.

GEOMETRIC LEGEND

EXISTING
PROPOSED

UTILITY LEGEND

—G—G—	GAS MAIN
—W—W—	WATER MAIN
—S—S—	SEWER MAIN
—E—E—	ELECTRIC CABLES
—A—A—	AERIAL CABLES
—T—T—	TELEPHONE CABLES

REVISION A CONSULTANT

WALLACE, MONTGOMERY & ASSOCIATES, LLP
CIVIL AND STRUCTURAL ENGINEERS
110 West Road, Suite 300
Towson, Maryland 21204
(410) 494-9093, (410) 825-5714 Fax
www.WallaceMontgomery.com

APPROVALS

TEAM LEADER
ASST. DIV. CHIEF
DIVISION CHIEF
OFFICE DIRECTOR

ORIGINAL PLAN ON FILE

REVISIONS

(A) RELOCATE EXISTING INTERCONNECT.
M.J.A. 6/30/06 MWD 6/30/06 JM 7/7/06

PLOTTED: Friday, June 09, 2006 AT 12:25 PM
FILE: M:\PROJ\199029.16\Cadd\pSG-C001_MD202.dgn

STATE OF MARYLAND
DEPARTMENT OF TRANSPORTATION
STATE HIGHWAY ADMINISTRATION
OFFICE OF TRAFFIC & SAFETY
TRAFFIC ENGINEERING DESIGN DIVISION

MD 202 (LARGO ROAD)
AT CAMPUS WAY

INTERCONNECT PLAN

SCALE 1" = 50' DATE 08/21/1990 CONTRACT NO.

DESIGNED BY R.R. ZACHERL
DRAWN BY S.R. BARANOWSKI
CHECKED BY D.C.
F.A.P. NO.
COUNTY PRINCE GEORGE'S
LOGMILE
T.I.M.S. NO. H594
TOD NO. 3077 XI

DRAWING NO. IC-01 OF IC-02
SHEET NO. OF

06/09/2006 12:25:52 PM M:\PROJ\199029.16\Cadd\pSG-C001 MD202.dgn