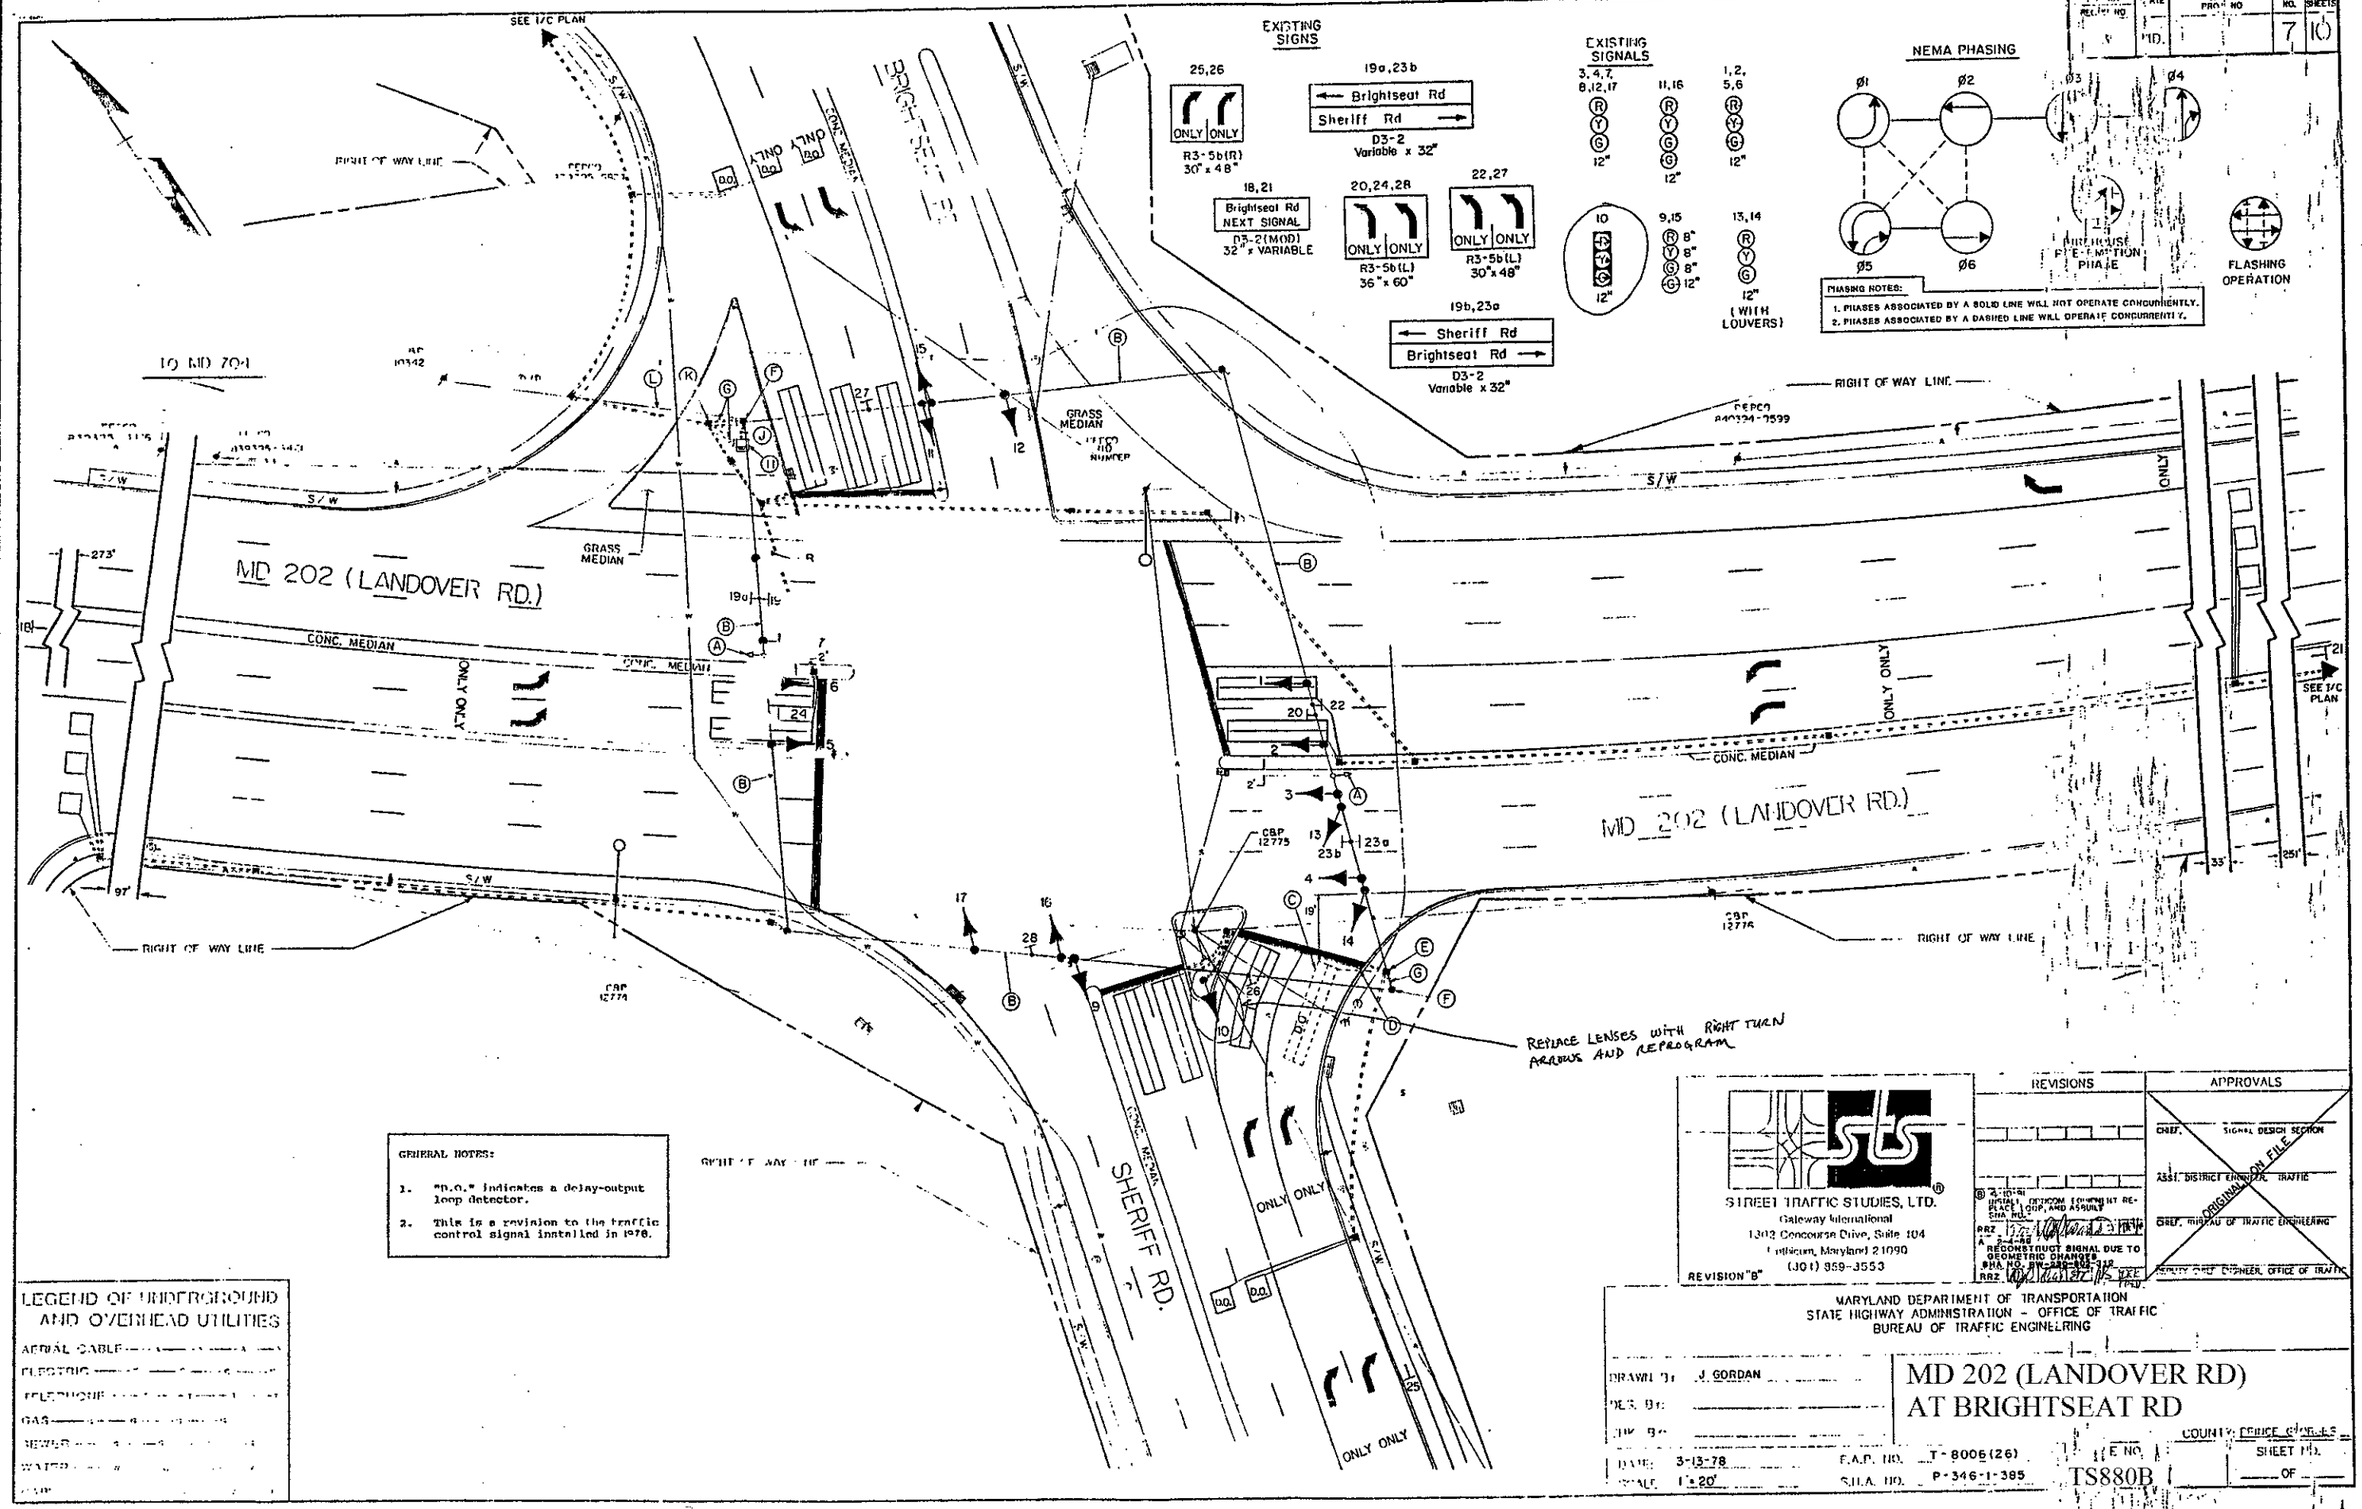

GENERAL NOTES:

1. "D.O." indicates a delay-output loop detector.
2. This is a revision to the traffic control signal installed in 1978.

LEGEND OF UNDERGROUND AND OVERHEAD UTILITIES

AERIAL CABLE
ELECTRIC
TELEPHONE
GAS
SEWER
WATER

STREET TRAFFIC STUDIES, LTD.
Gateway International
1302 Concourse Drive, Suite 104
Linthicum, Maryland 21090
(301) 859-3553
REVISION "B"

REVISIONS

APPROVALS

CHIEF, SIGNAL DESIGN SECTION
ASST. DISTRICT ENGINEER, TRAFFIC
CHIEF, BUREAU OF TRAFFIC ENGINEERING
DEPUTY CHIEF ENGINEER, OFFICE OF TRAFFIC

ORIGINAL ON FILE

MARYLAND DEPARTMENT OF TRANSPORTATION
STATE HIGHWAY ADMINISTRATION - OFFICE OF TRAFFIC
BUREAU OF TRAFFIC ENGINEERING

DRAWN BY: J. GORDAN
DES. BY:
CHK. BY:
DATE: 3-13-78
SCALE: 1" = 20'
F.A.P. NO. T-8006(26)
S.H.A. NO. P-346-1-385

MD 202 (LANDOVER RD) AT BRIGHTSEAT RD

COUNTY: PRINCE GEORGES
E NO. TS880B
SHEET NO. ___ OF ___

TIMS
B215