FED. ROAD DIV. NO.	STATE	FED. AID PROJ. NO.	SHEET NO.	TOTAL SHEETS
3	MD.	T-8006(26)	3	1

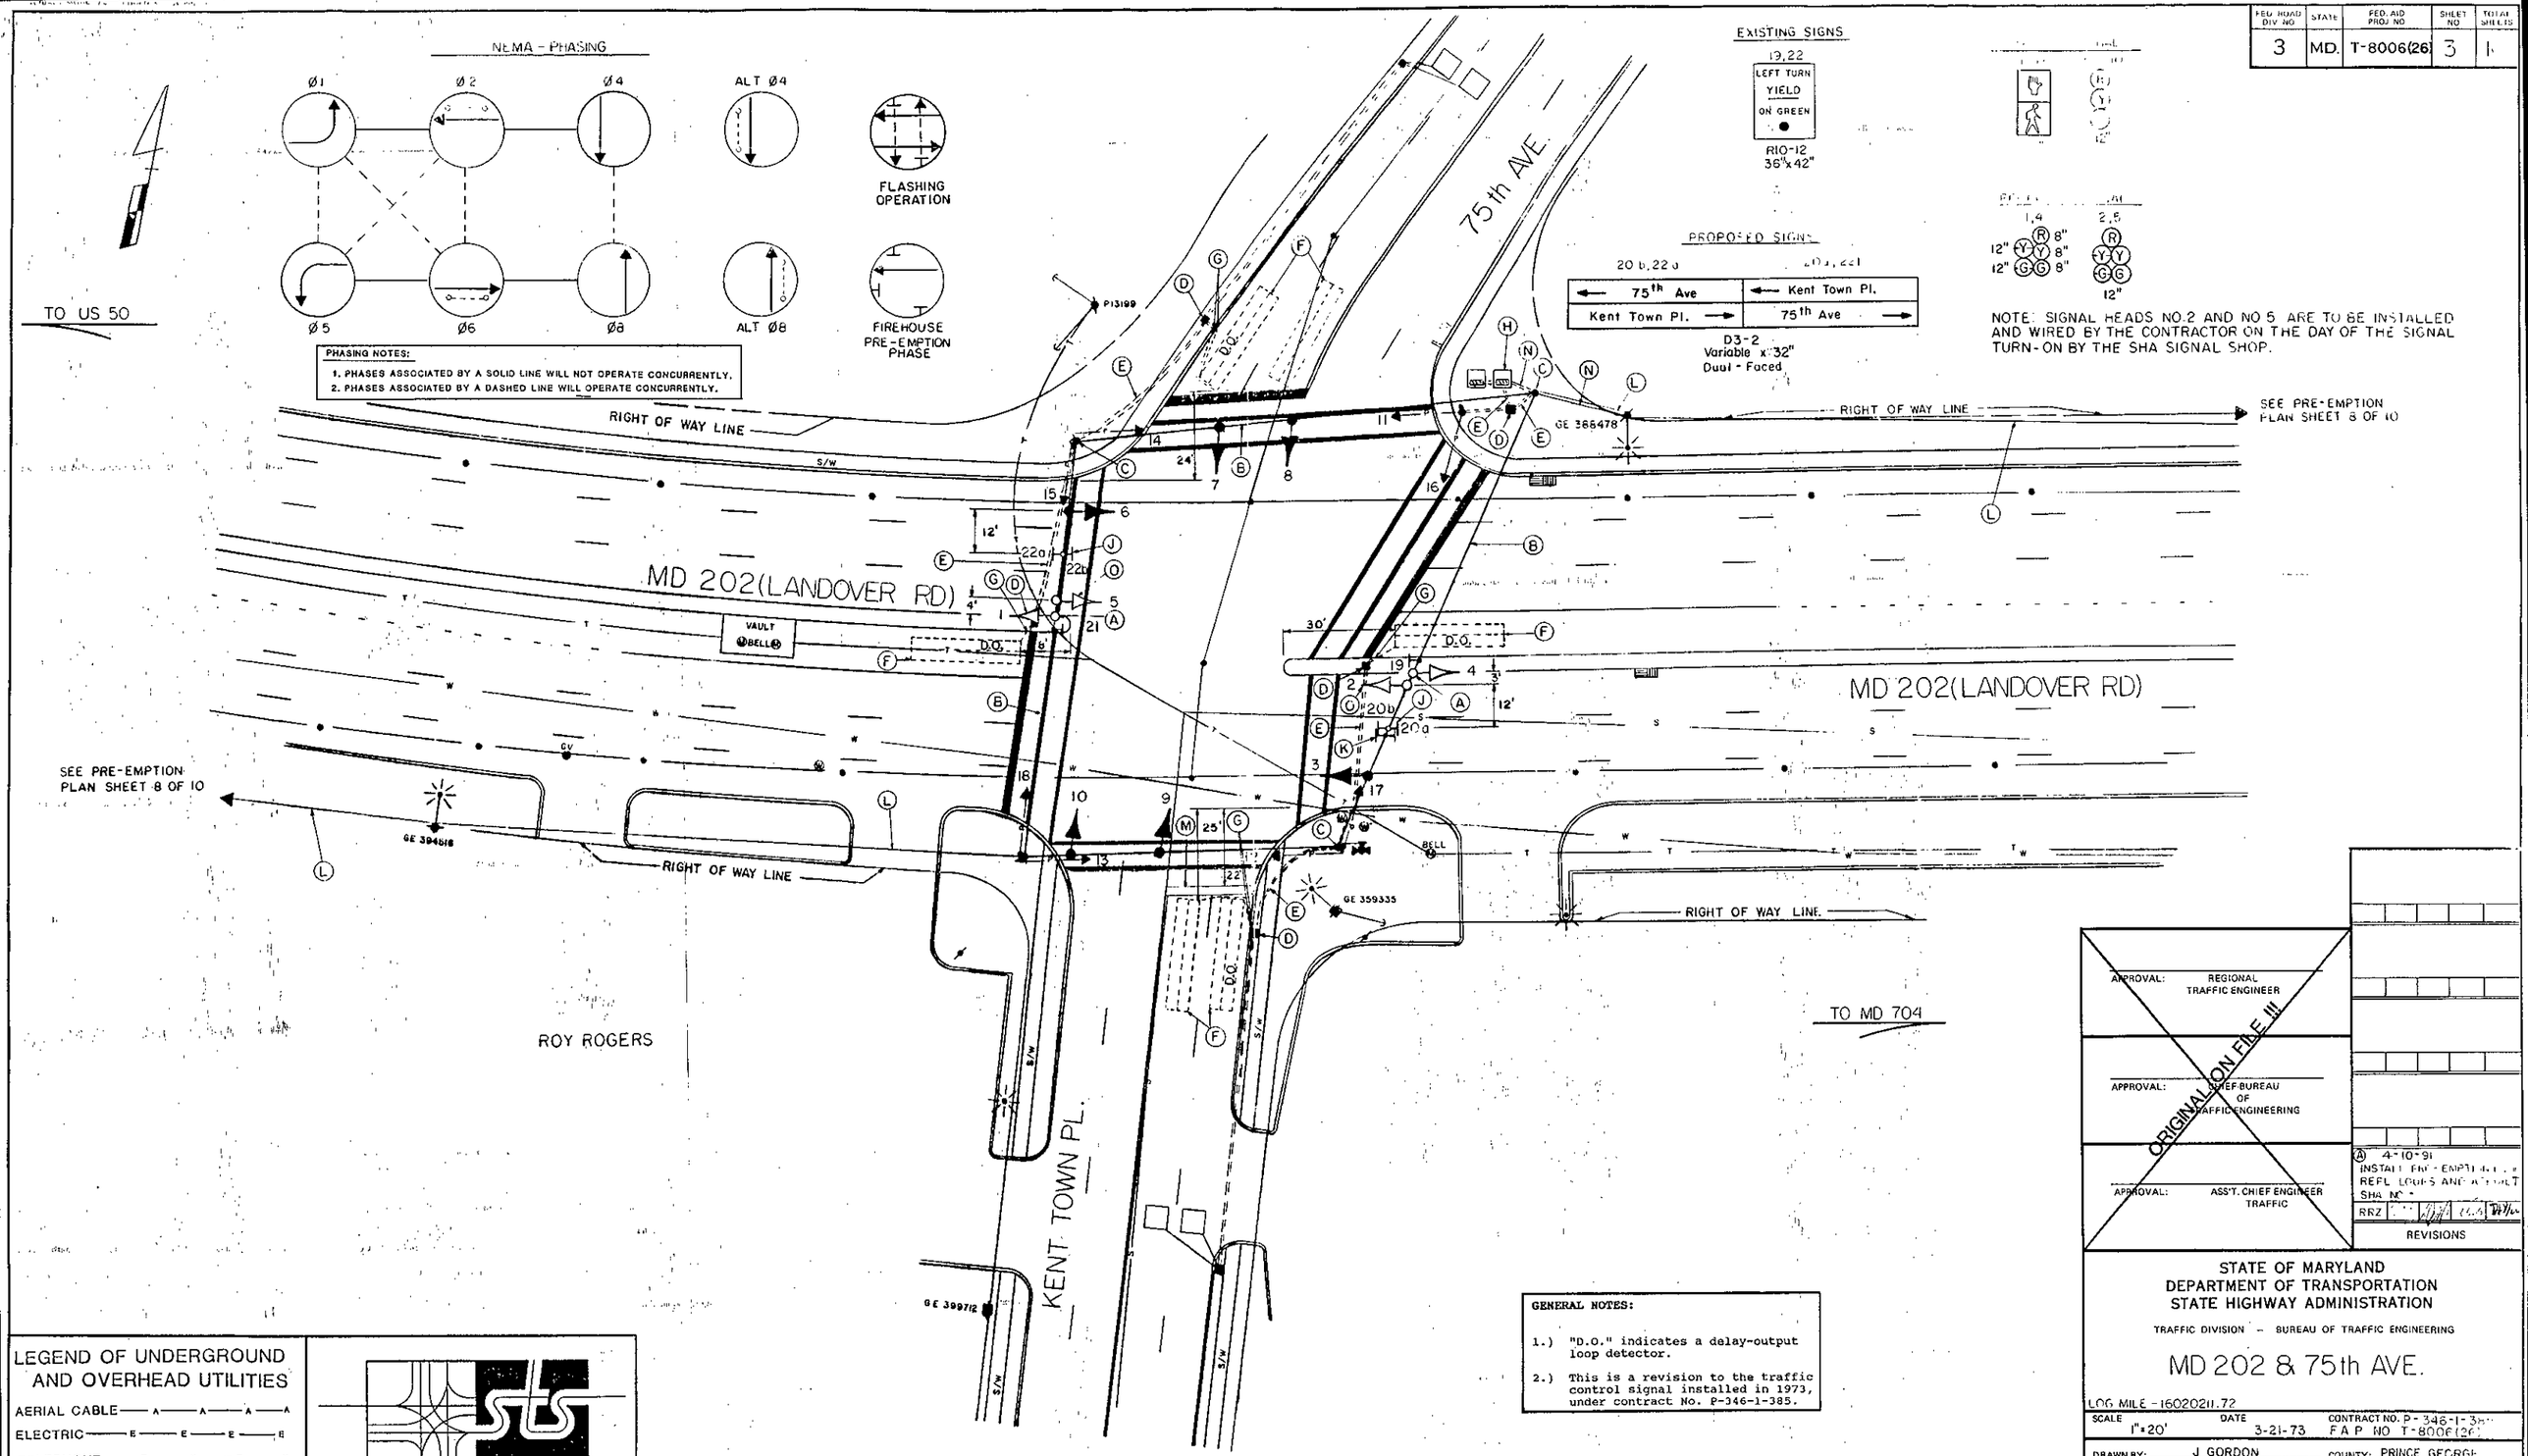

GENERAL NOTES:

1.) "D.O." indicates a delay-output loop detector.

2.) This is a revision to the traffic control signal installed in 1973, under contract No. P-346-1-385.

LEGEND OF UNDERGROUND AND OVERHEAD UTILITIES

AERIAL CABLE — A — A — A — A
ELECTRIC — E — E — E — E
TELEPHONE — T — T — T — T
GAS — G — G — G — G
SEWER — S — S — S — S
WATER — W — W — W — W
CABLE TV — TV — TV — TV — TV

STREET TRAFFIC STUDIES, LTD.
Gateway International
1302 Concourse Drive, Suite 104
Linthicum, Maryland 21090
(301) 859-3553

APPROVAL: REGIONAL TRAFFIC ENGINEER

APPROVAL: CHIEF BUREAU OF TRAFFIC ENGINEERING

APPROVAL: ASS'T. CHIEF ENGINEER TRAFFIC

ORIGINAL ON FILE !!!

Ⓐ 4-10-91
INSTALL PRE-EMPTION ... REFL LOOPS AND ... SHA NO. -
RRZ

REVISIONS

STATE OF MARYLAND
DEPARTMENT OF TRANSPORTATION
STATE HIGHWAY ADMINISTRATION

TRAFFIC DIVISION - BUREAU OF TRAFFIC ENGINEERING

MD 202 & 75th AVE.

LOG MILE - 16020211.72

SCALE 1"=20' DATE 3-21-73 CONTRACT NO. P-346-1-385 F.A.P. NO. T-8006(26)

DRAWN BY: J GORDON COUNTY: PRINCE GEORGE

DESIGNED BY: SIGNAL NO.:

CHECKED BY:

DRAWING NO. TS-639A

16020211.72