F.H.W.A. REGION NO.	STATE	FED. AID PROJ. NO.	SHEET NO.	TOTAL SHEETS
3	MD.			

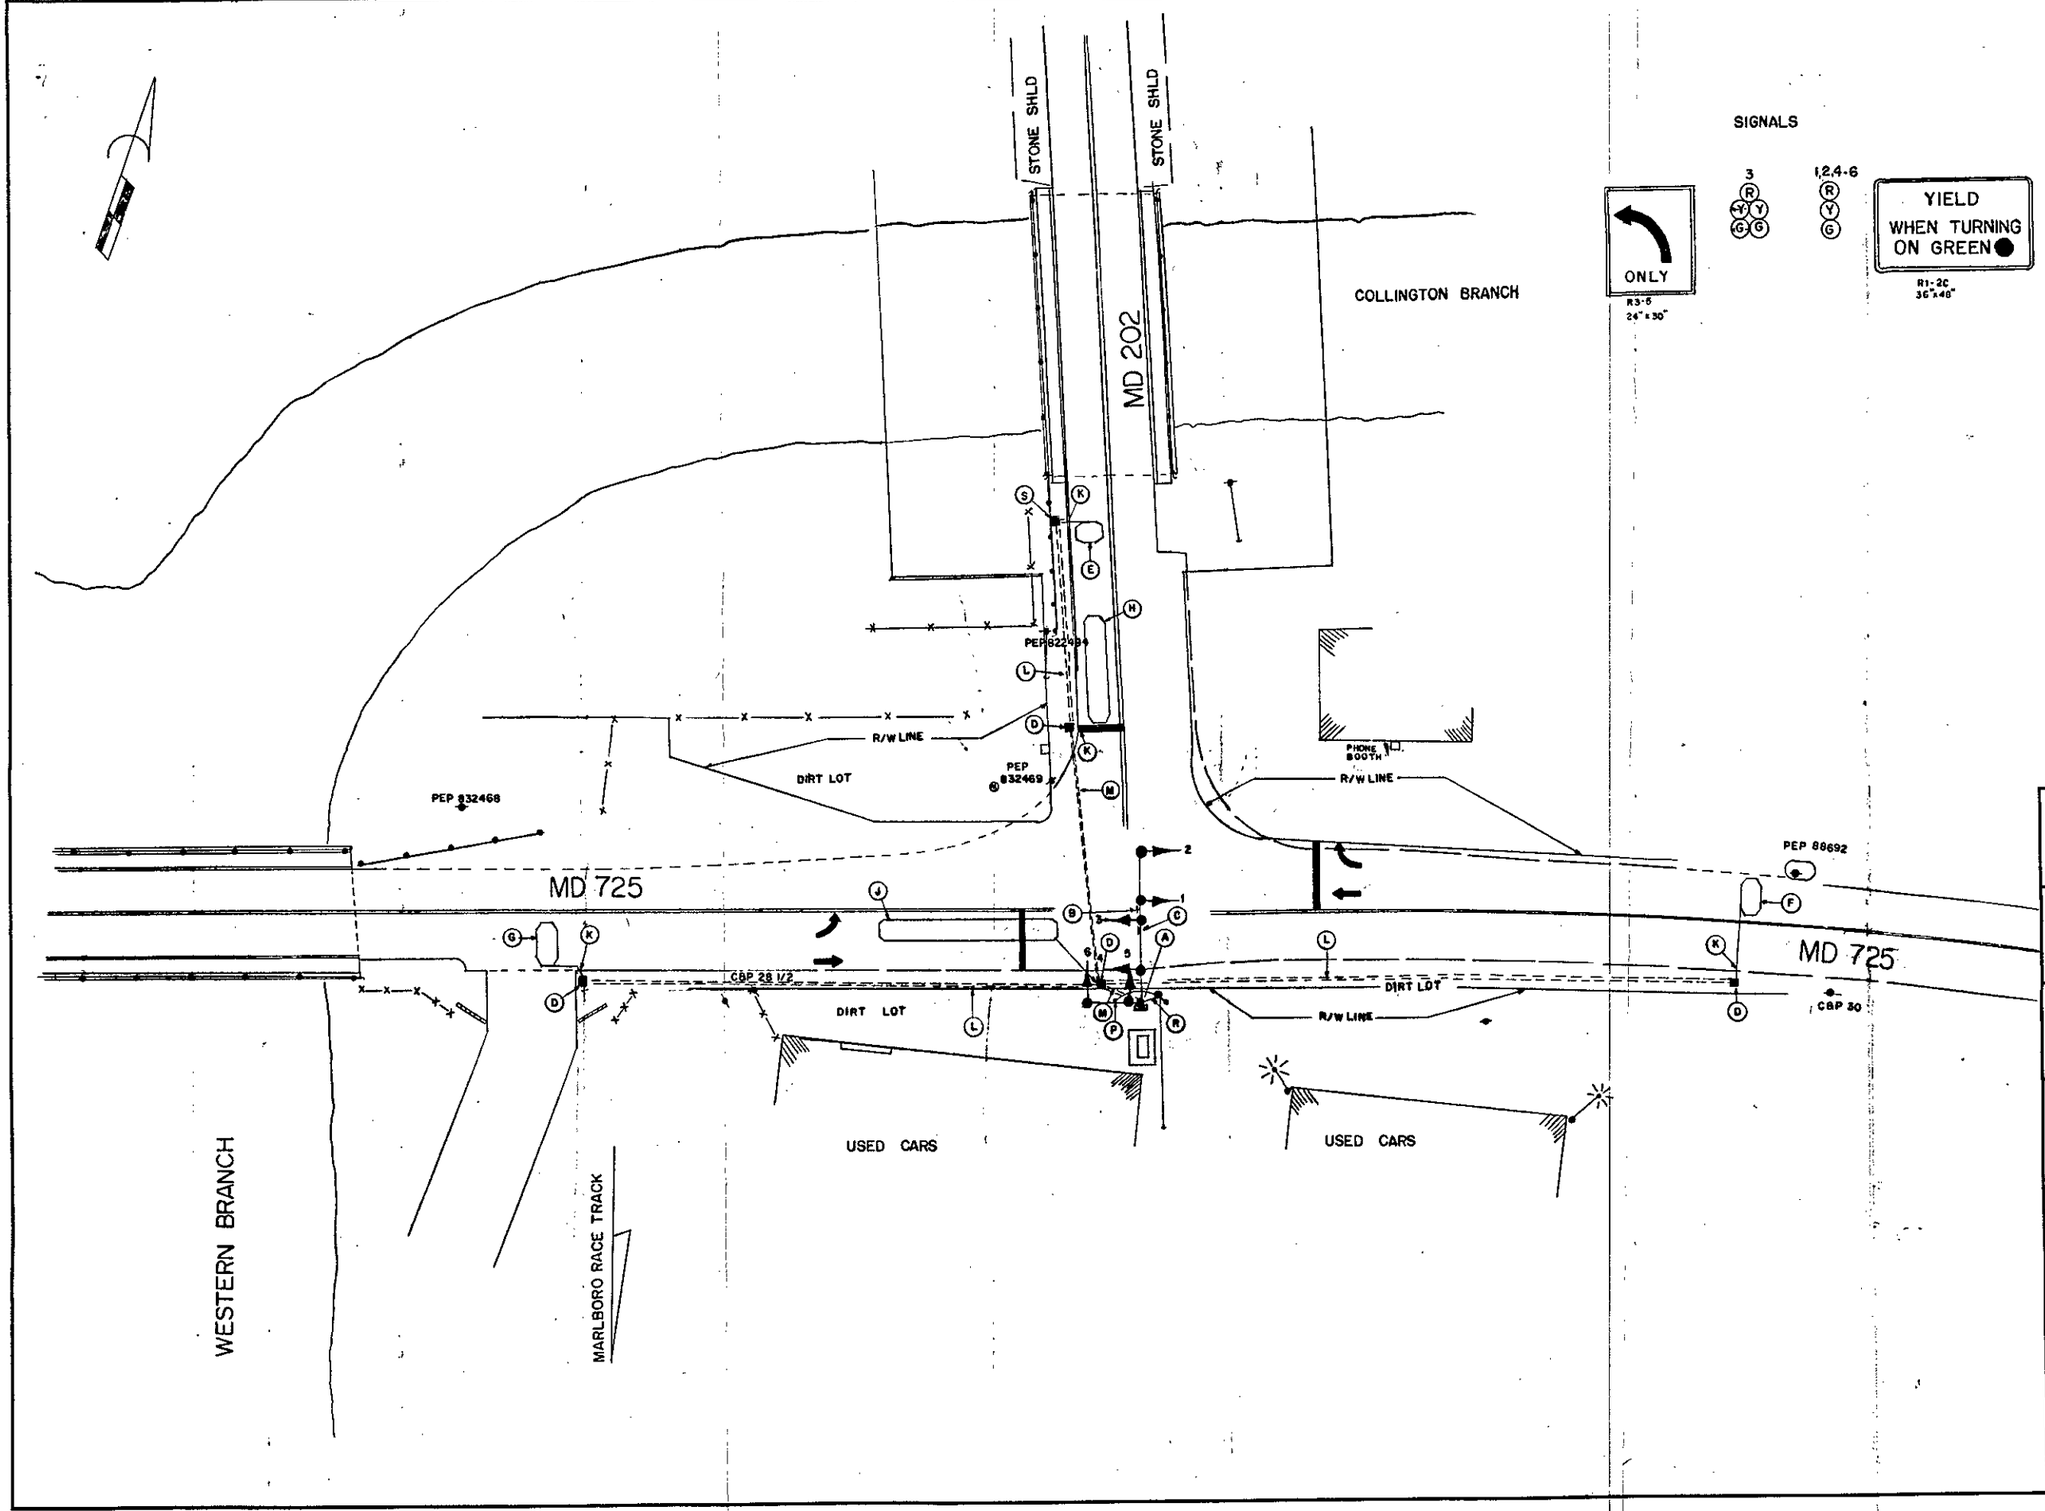

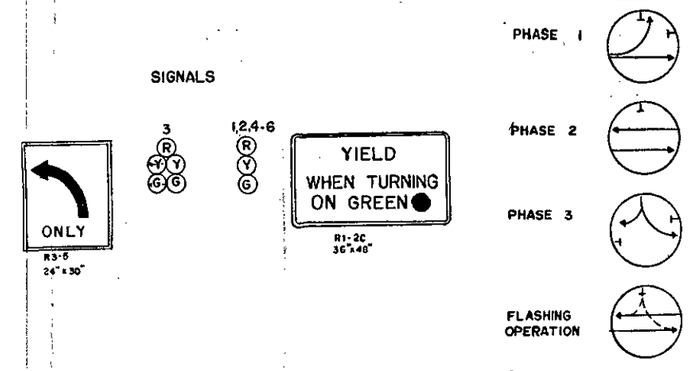

APPROVAL: CHIEF SIGNAL DESIGN SECTION

APPROVAL: REGIONAL TRAFFIC ENGINEER

EDWARD T. PAULIS JR. 11-23-76
APPROVAL: CHIEF-BUREAU OF TRAFFIC ENGINEERING

TOM HICKS 12-20-76
APPROVAL: ASS'T. CHIEF ENGINEER TRAFFIC

B 7-19-83
RE-DRAWN,
JBB

A 12-2-80
ASBUILT
P-559-501-385
JG

REVISIONS

STATE OF MARYLAND
DEPARTMENT OF TRANSPORTATION
STATE HIGHWAY ADMINISTRATION

TRAFFIC DIVISION – BUREAU OF TRAFFIC ENGINEERING

MD 202 & MD 725

SCALE 1"=20' DATE 7-26-71 CONTRACT NO. P559-501-385

DRAWN BY: LES TOWNSEND COUNTY: PRINCE GEORGE'S

DESIGNED BY: SIGNAL NO.: 16051

CHECKED BY:

DRAWING NO. TS-643B

16020200.00