FHWA REGION NO.	STATE	FED. AID PROJ. NO.	SHEET NO.	TOTAL SHEETS
3	MD.		2	5

NOTE: 1. PAVEMENT MARKINGS SHOWN ON DRAWING ARE PROPOSED AND WILL BE INSTALLED BY OTHERS

2. D.O. INDICATES DELAY-OUTPUT

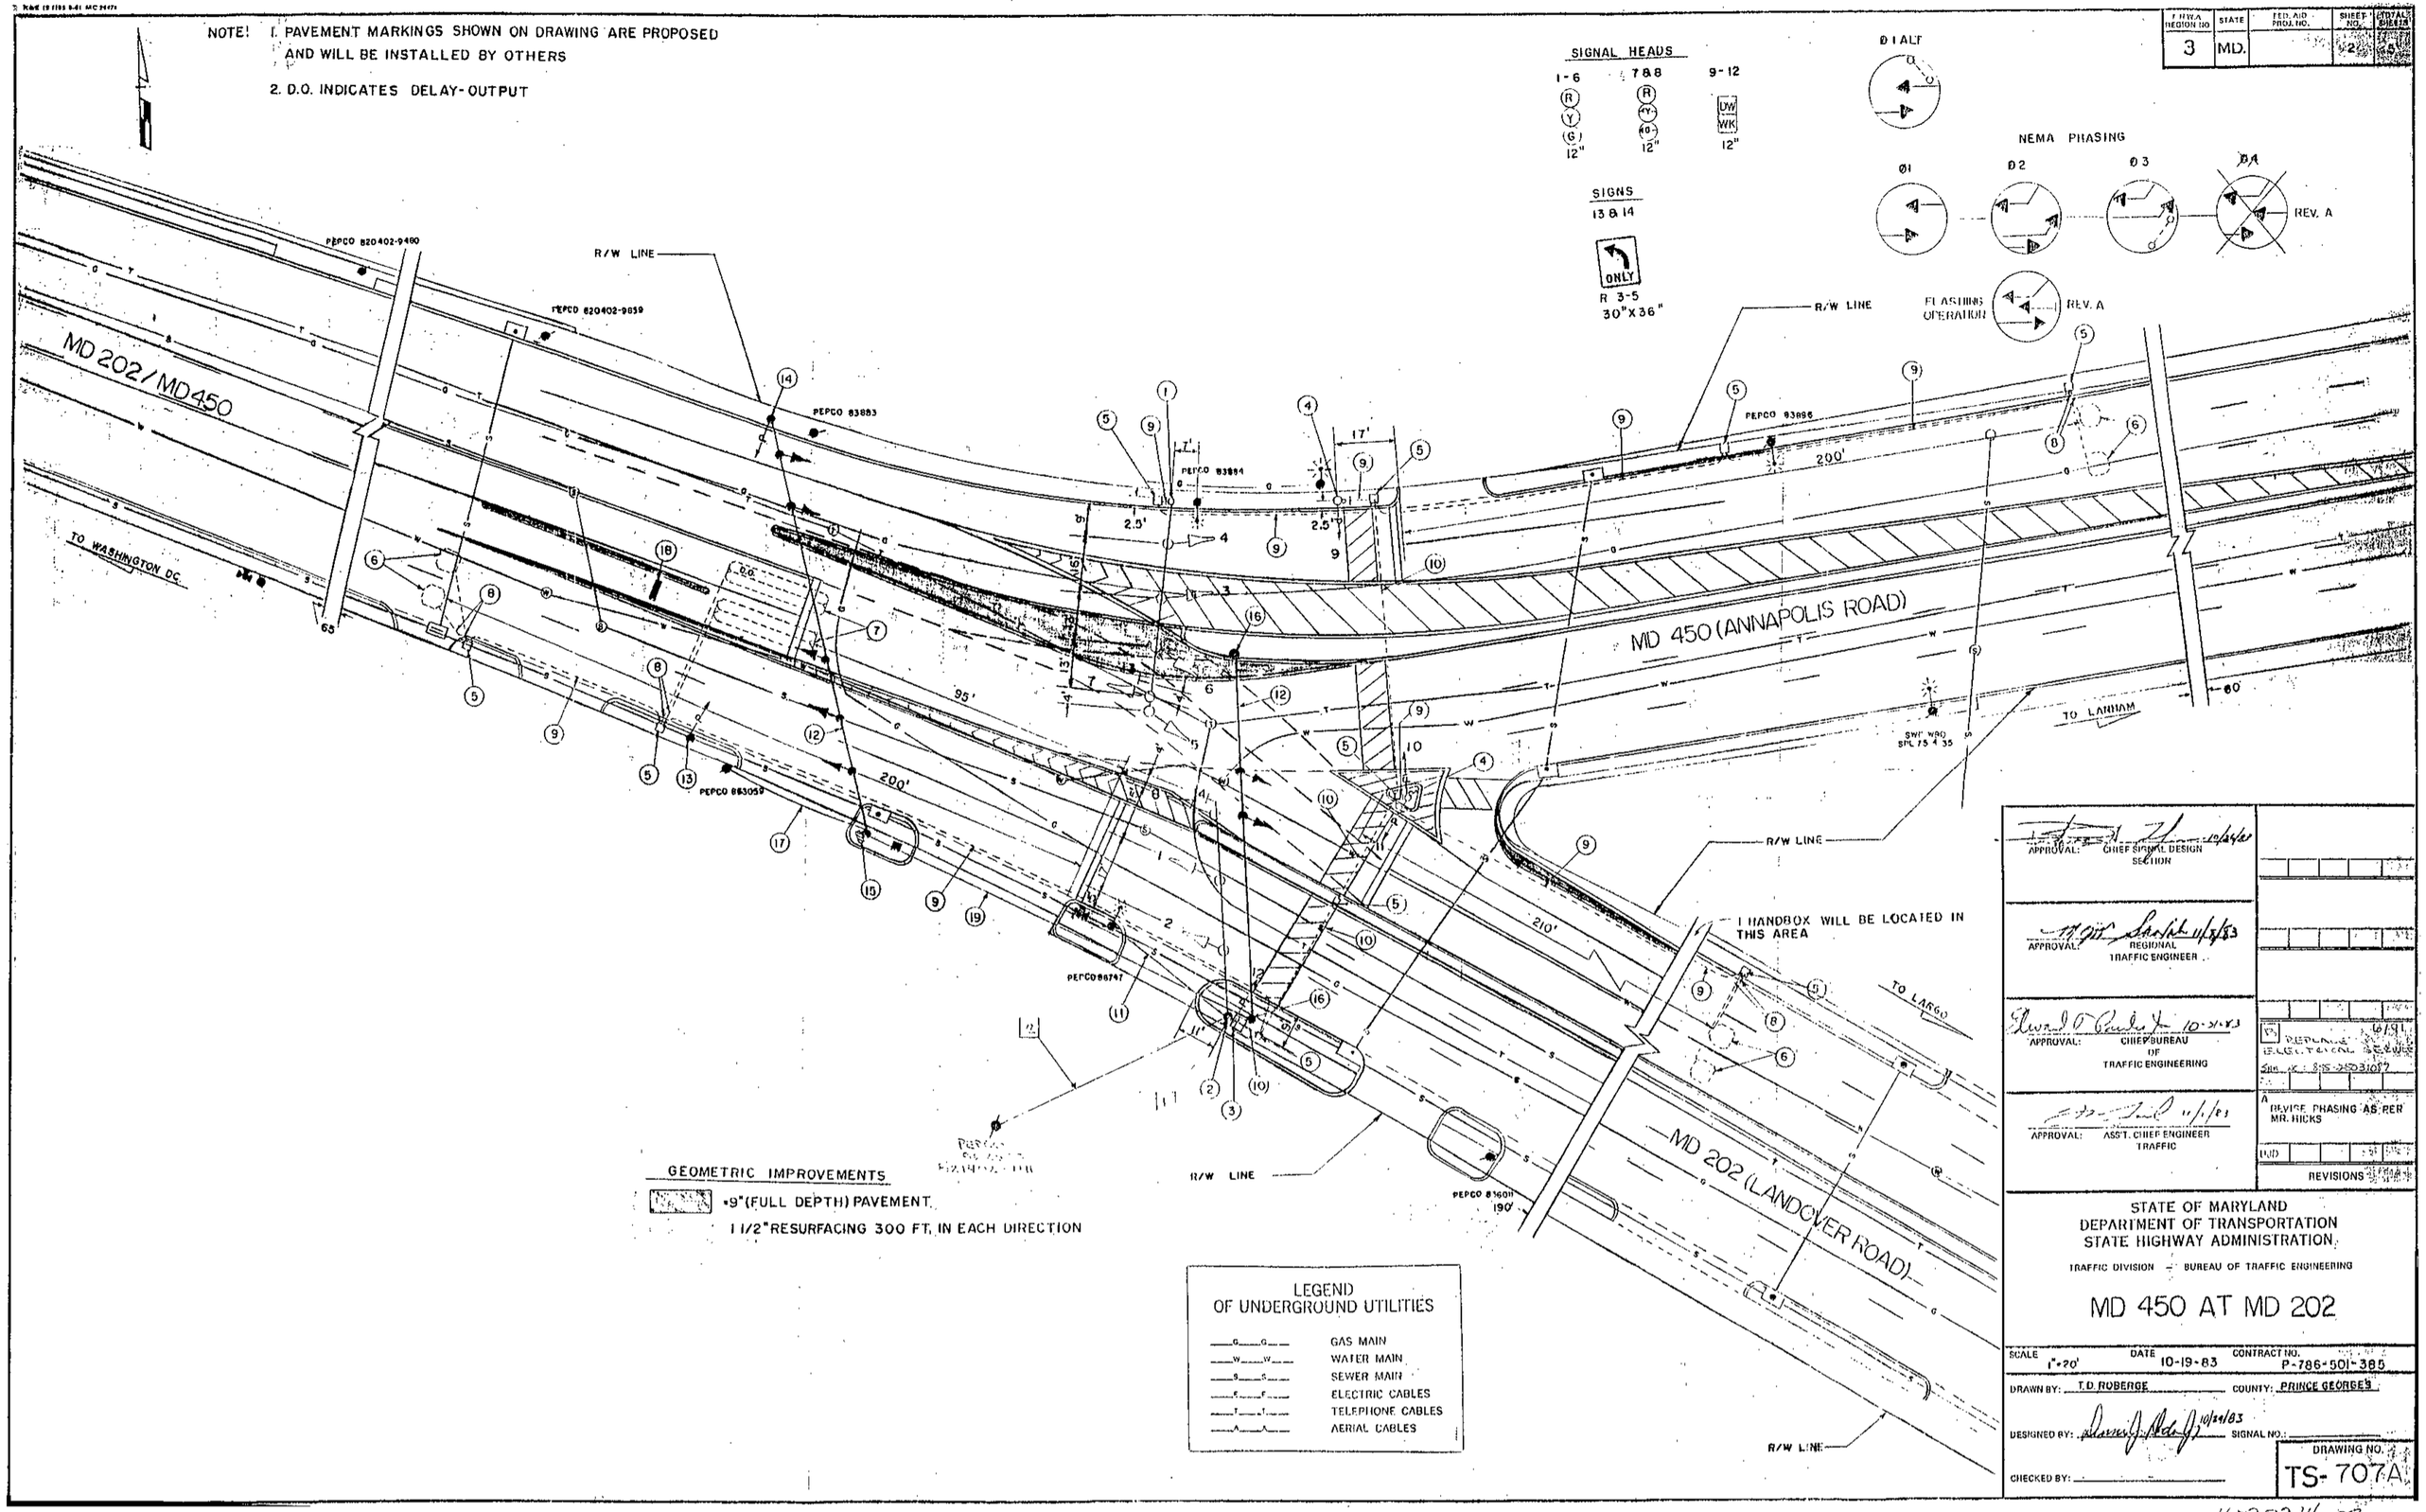

APPROVAL: CHIEF SIGNAL DESIGN SECTION 10/24/83

APPROVAL: REGIONAL TRAFFIC ENGINEER 11/8/83

APPROVAL: CHIEF BUREAU OF TRAFFIC ENGINEERING 10-31-83

APPROVAL: ASS'T. CHIEF ENGINEER TRAFFIC 11/1/83

REVISIONS

A REVISE PHASING AS PER MR. HICKS

STATE OF MARYLAND
DEPARTMENT OF TRANSPORTATION
STATE HIGHWAY ADMINISTRATION

TRAFFIC DIVISION — BUREAU OF TRAFFIC ENGINEERING

MD 450 AT MD 202

SCALE 1"=20' DATE 10-19-83 CONTRACT NO. P-786-501-385

DRAWN BY: T.D. ROBERGE COUNTY: PRINCE GEORGE'S

DESIGNED BY: 10/24/83 SIGNAL NO.:

CHECKED BY:

DRAWING NO. TS-707A

1602021 4.03