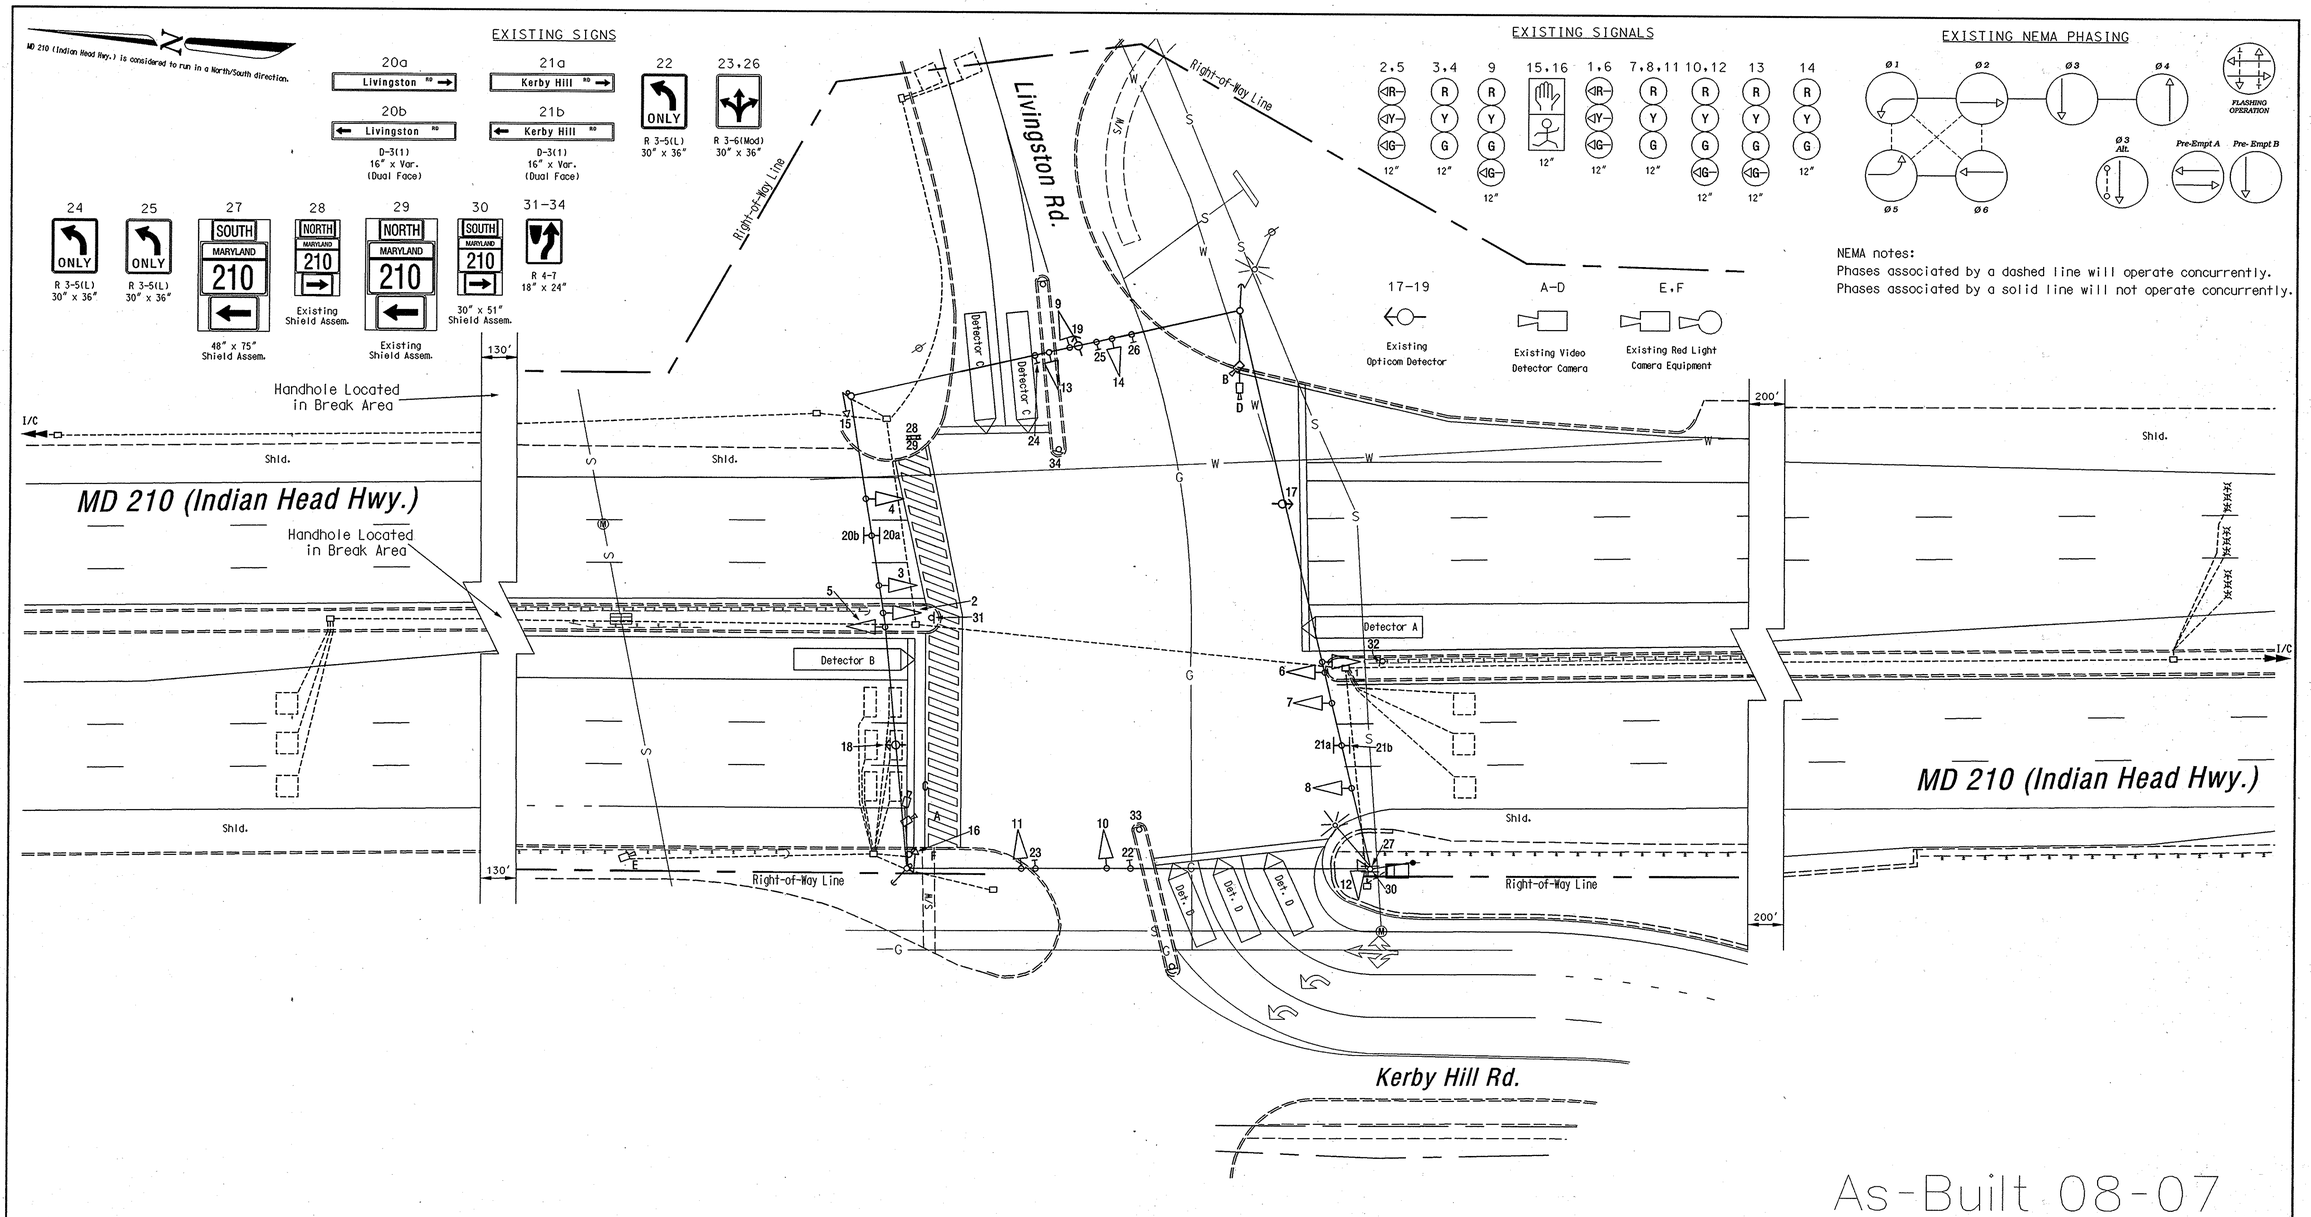

As-Built 08-07

GEOMETRIC LEGEND

EXISTING GEOMETRICS

PROPOSED GEOMETRICS

UTILITY LEGEND

GAS MAIN

WATER MAIN

SEWER MAIN

ELECTRIC CABLES

STORM DRAIN

AERIAL CABLES

TELEPHONE CABLES

The Traffic Group

The Traffic Group, Inc.
410-931-6600
Fax 410-931-6601

REVISIONS

K As-Built. S.H.A. No.:BW996M82					8/14/07
SED					
J Modify West leg for triple Left. S.H.A. No.:BW996M82					4/4/04
JES	DJD				BZK
I Change Signal heads. Add Video detection. S.H.A. No.: PG408A21					10/02
JFL	WM	MAR	DAZ		BRK
H As-Built S.H.A. No.: PG408A21					5/02
CW	DP	EV	FM	WC	

APPROVALS

ORIGINAL ON FILE

TEAM LEADER, TRAFFIC ENGINEERING DESIGN DIVISION

ASST. CHIEF TRAFFIC ENGINEERING DESIGN DIVISION

CHIEF, TRAFFIC ENGINEERING DESIGN DIVISION

DIRECTOR, TRAFFIC & SAFETY

MARYLAND DOT - STATE HIGHWAY ADMINISTRATION

Office of Traffic & Safety

TRAFFIC ENGINEERING DESIGN DIVISION

(Traffic Signal Plan)

MD 210 (Indian Head Hwy.) at Kerby Hill Rd./ Livingston Rd.

DRAWN BY:		F.A.P. NO.	N/A	TS NO.	SHEET NO.
CHECKED BY:		S.H.A. NO.	P-387-001-385	729XK	
SCALE:	1" - 20'	COUNTY:	Prince George's	T.I.M.S. NO.	
DATE:	8/72	LOG MILE:	16021011.54	G437	1 OF 1

f:\2000\2000-071\as built.dgn 8/22/2007