F.H.W.A. REGION NO.	STATE	FED. AID PROJ. NO.	SHEET NO	TOTAL SHEETS
3	MD.	U 263-1(3)	10	17

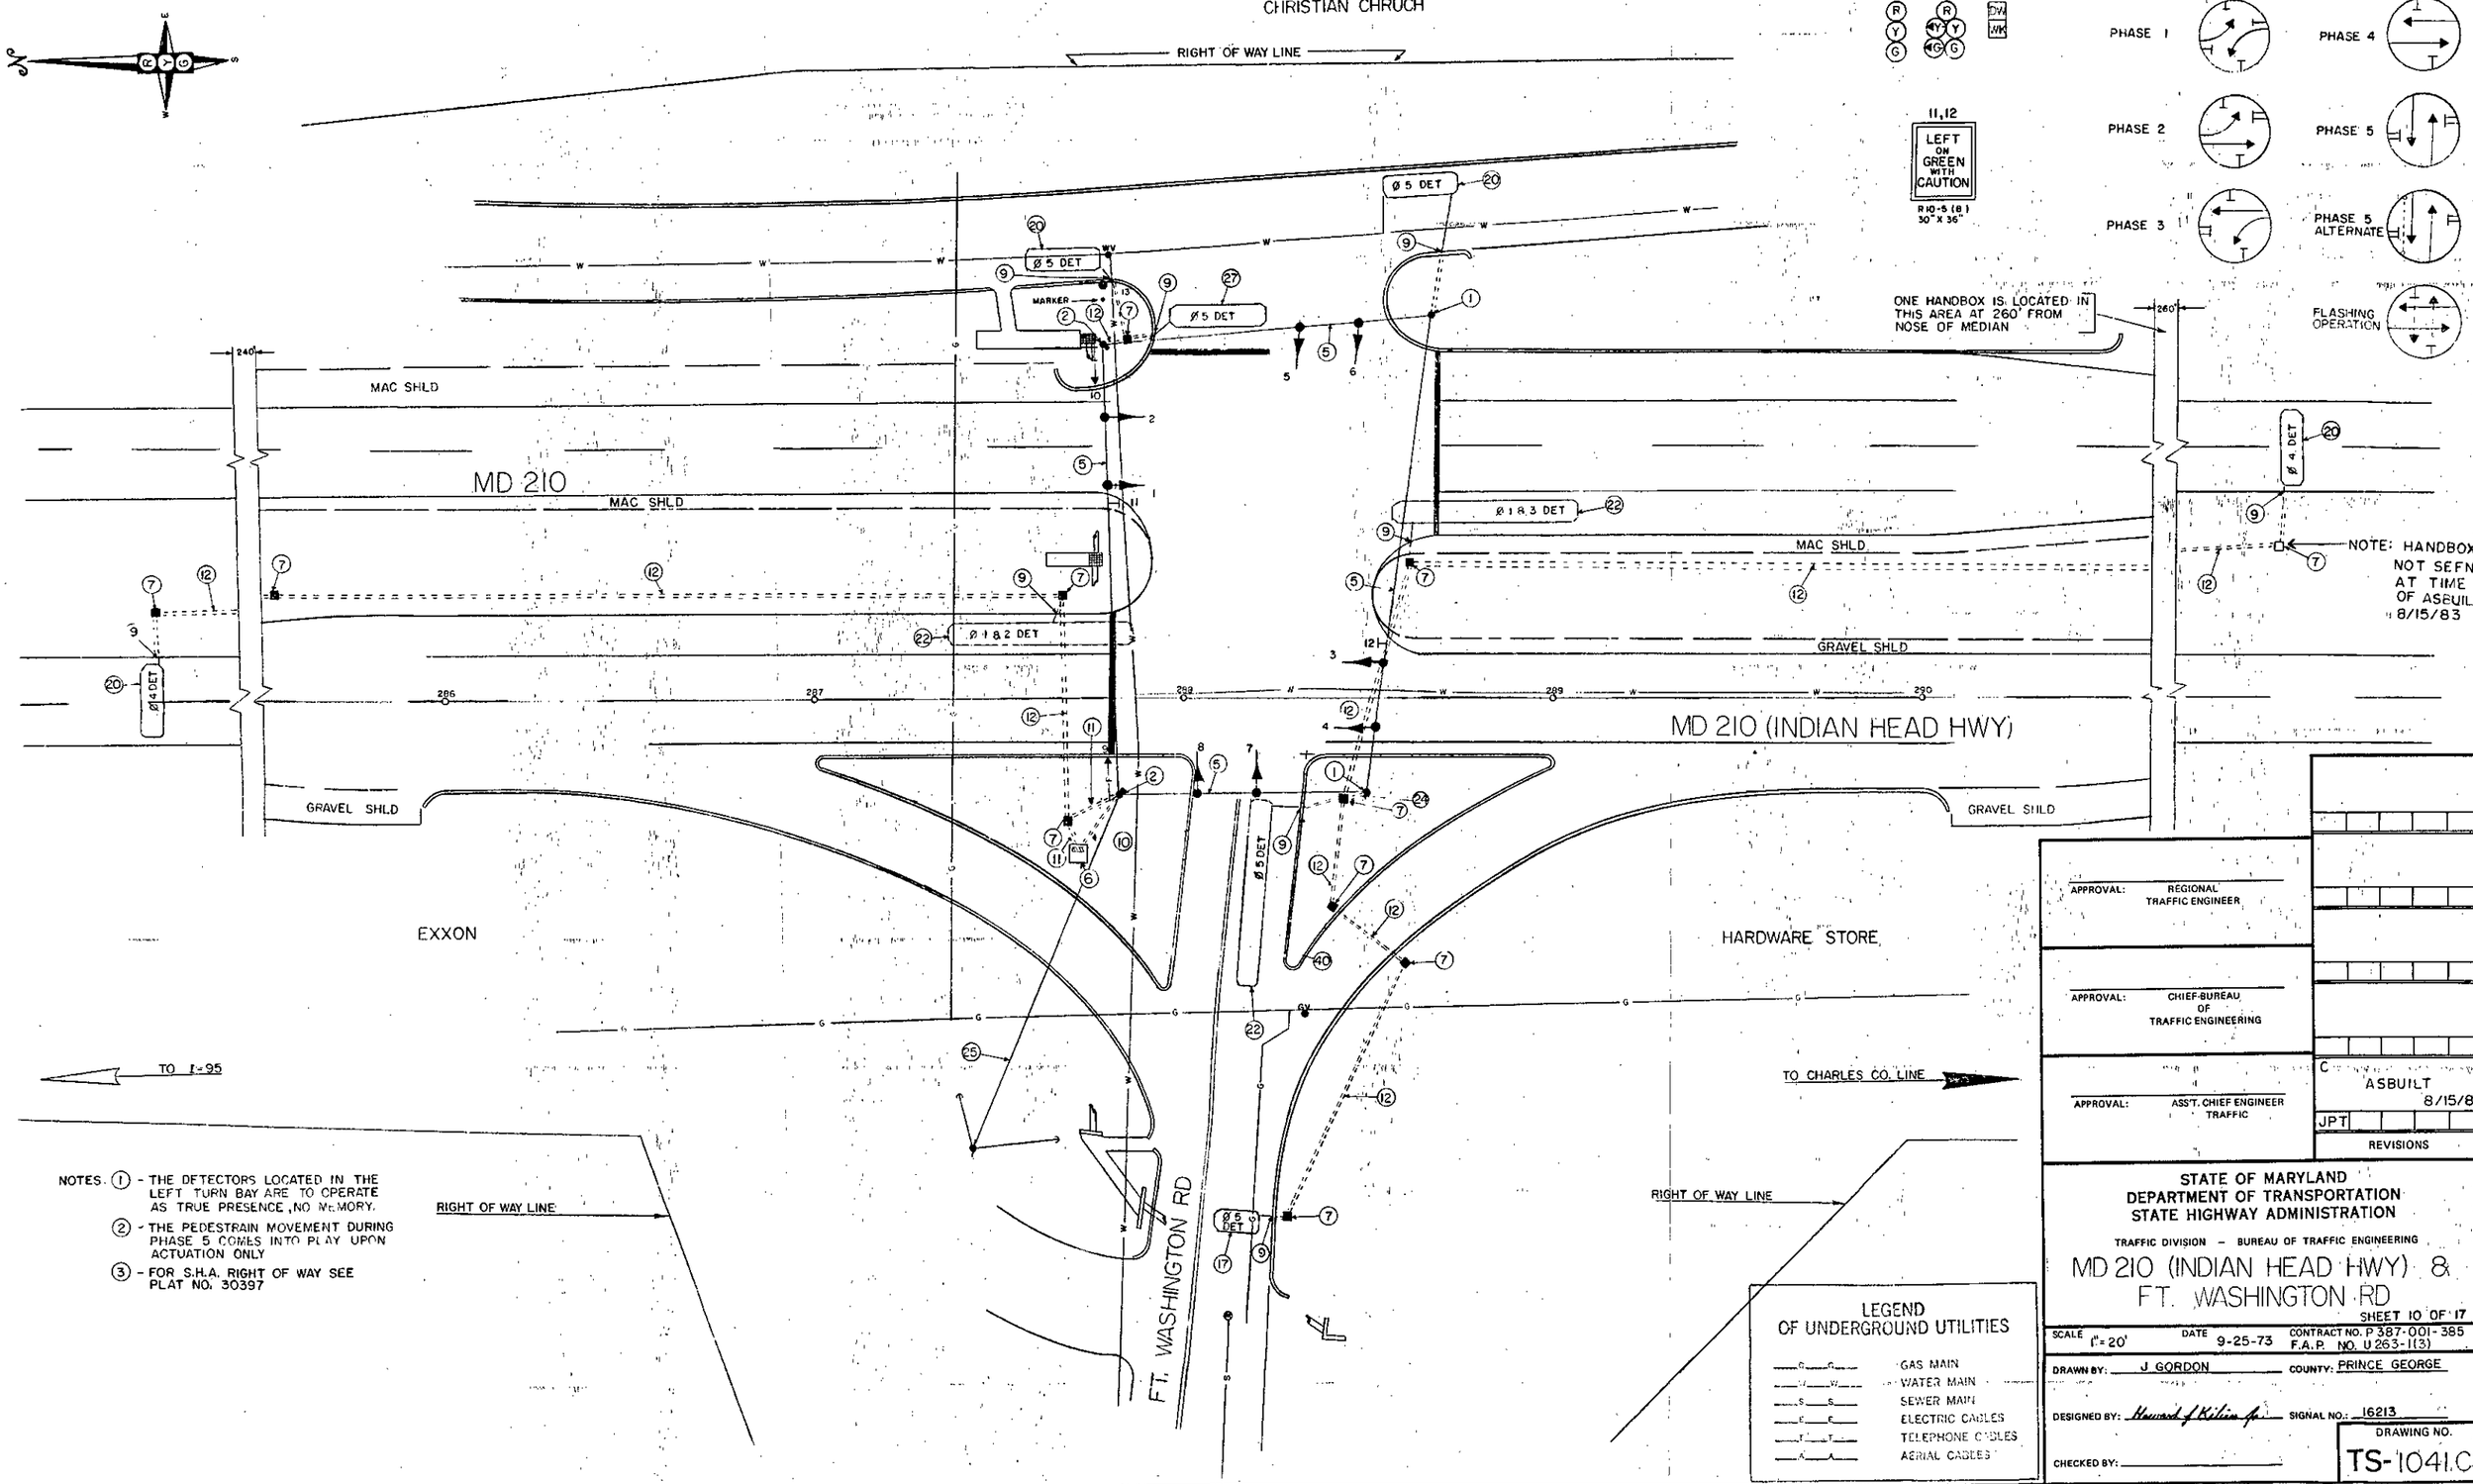

16021008.97