
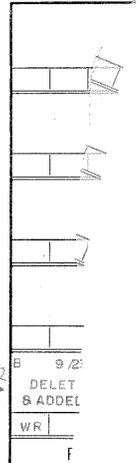


NOTE:
ALL WIRING, PLACING OF CONDUIT & CONSTRUCTION OF FOUNDATION IS TO BE DONE BY PEPCO. TRAFFIC MAINTENANCE IS TO DO ALL WIRING INSIDE THE CABINET. THEY ARE ALSO TO INSTALL THE CABINET.

TS# 831 B
16021000.00

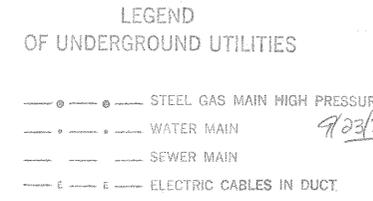

APPROVAL: CHIEF - BUREAU OF TRAFFIC ENGINEERING

MARYLAND STATE ROADS COMMISSION
DIVISION OF TRAFFIC SAFETY
BUREAU OF TRAFFIC ENGINEERING

APPROVAL: ASST CHIEF ENGINEER TRAFFIC SAFETY

(CITY) D.C.
MD 210 & SOUTHERN AVE
F.A.P. NO. T8006(3)
DATE 5-23-72 CONTRACT NO. P303-376
SCALE 1"=20' COUNTY PRINCE GEORGES
DRAWN BY: J. GORDON CHECKED BY:

831
TS