F H W A REGION NO.	STATE	FED. AID PROJ. NO.	SHEET NO.	TOTAL SHEETS
3	MD			

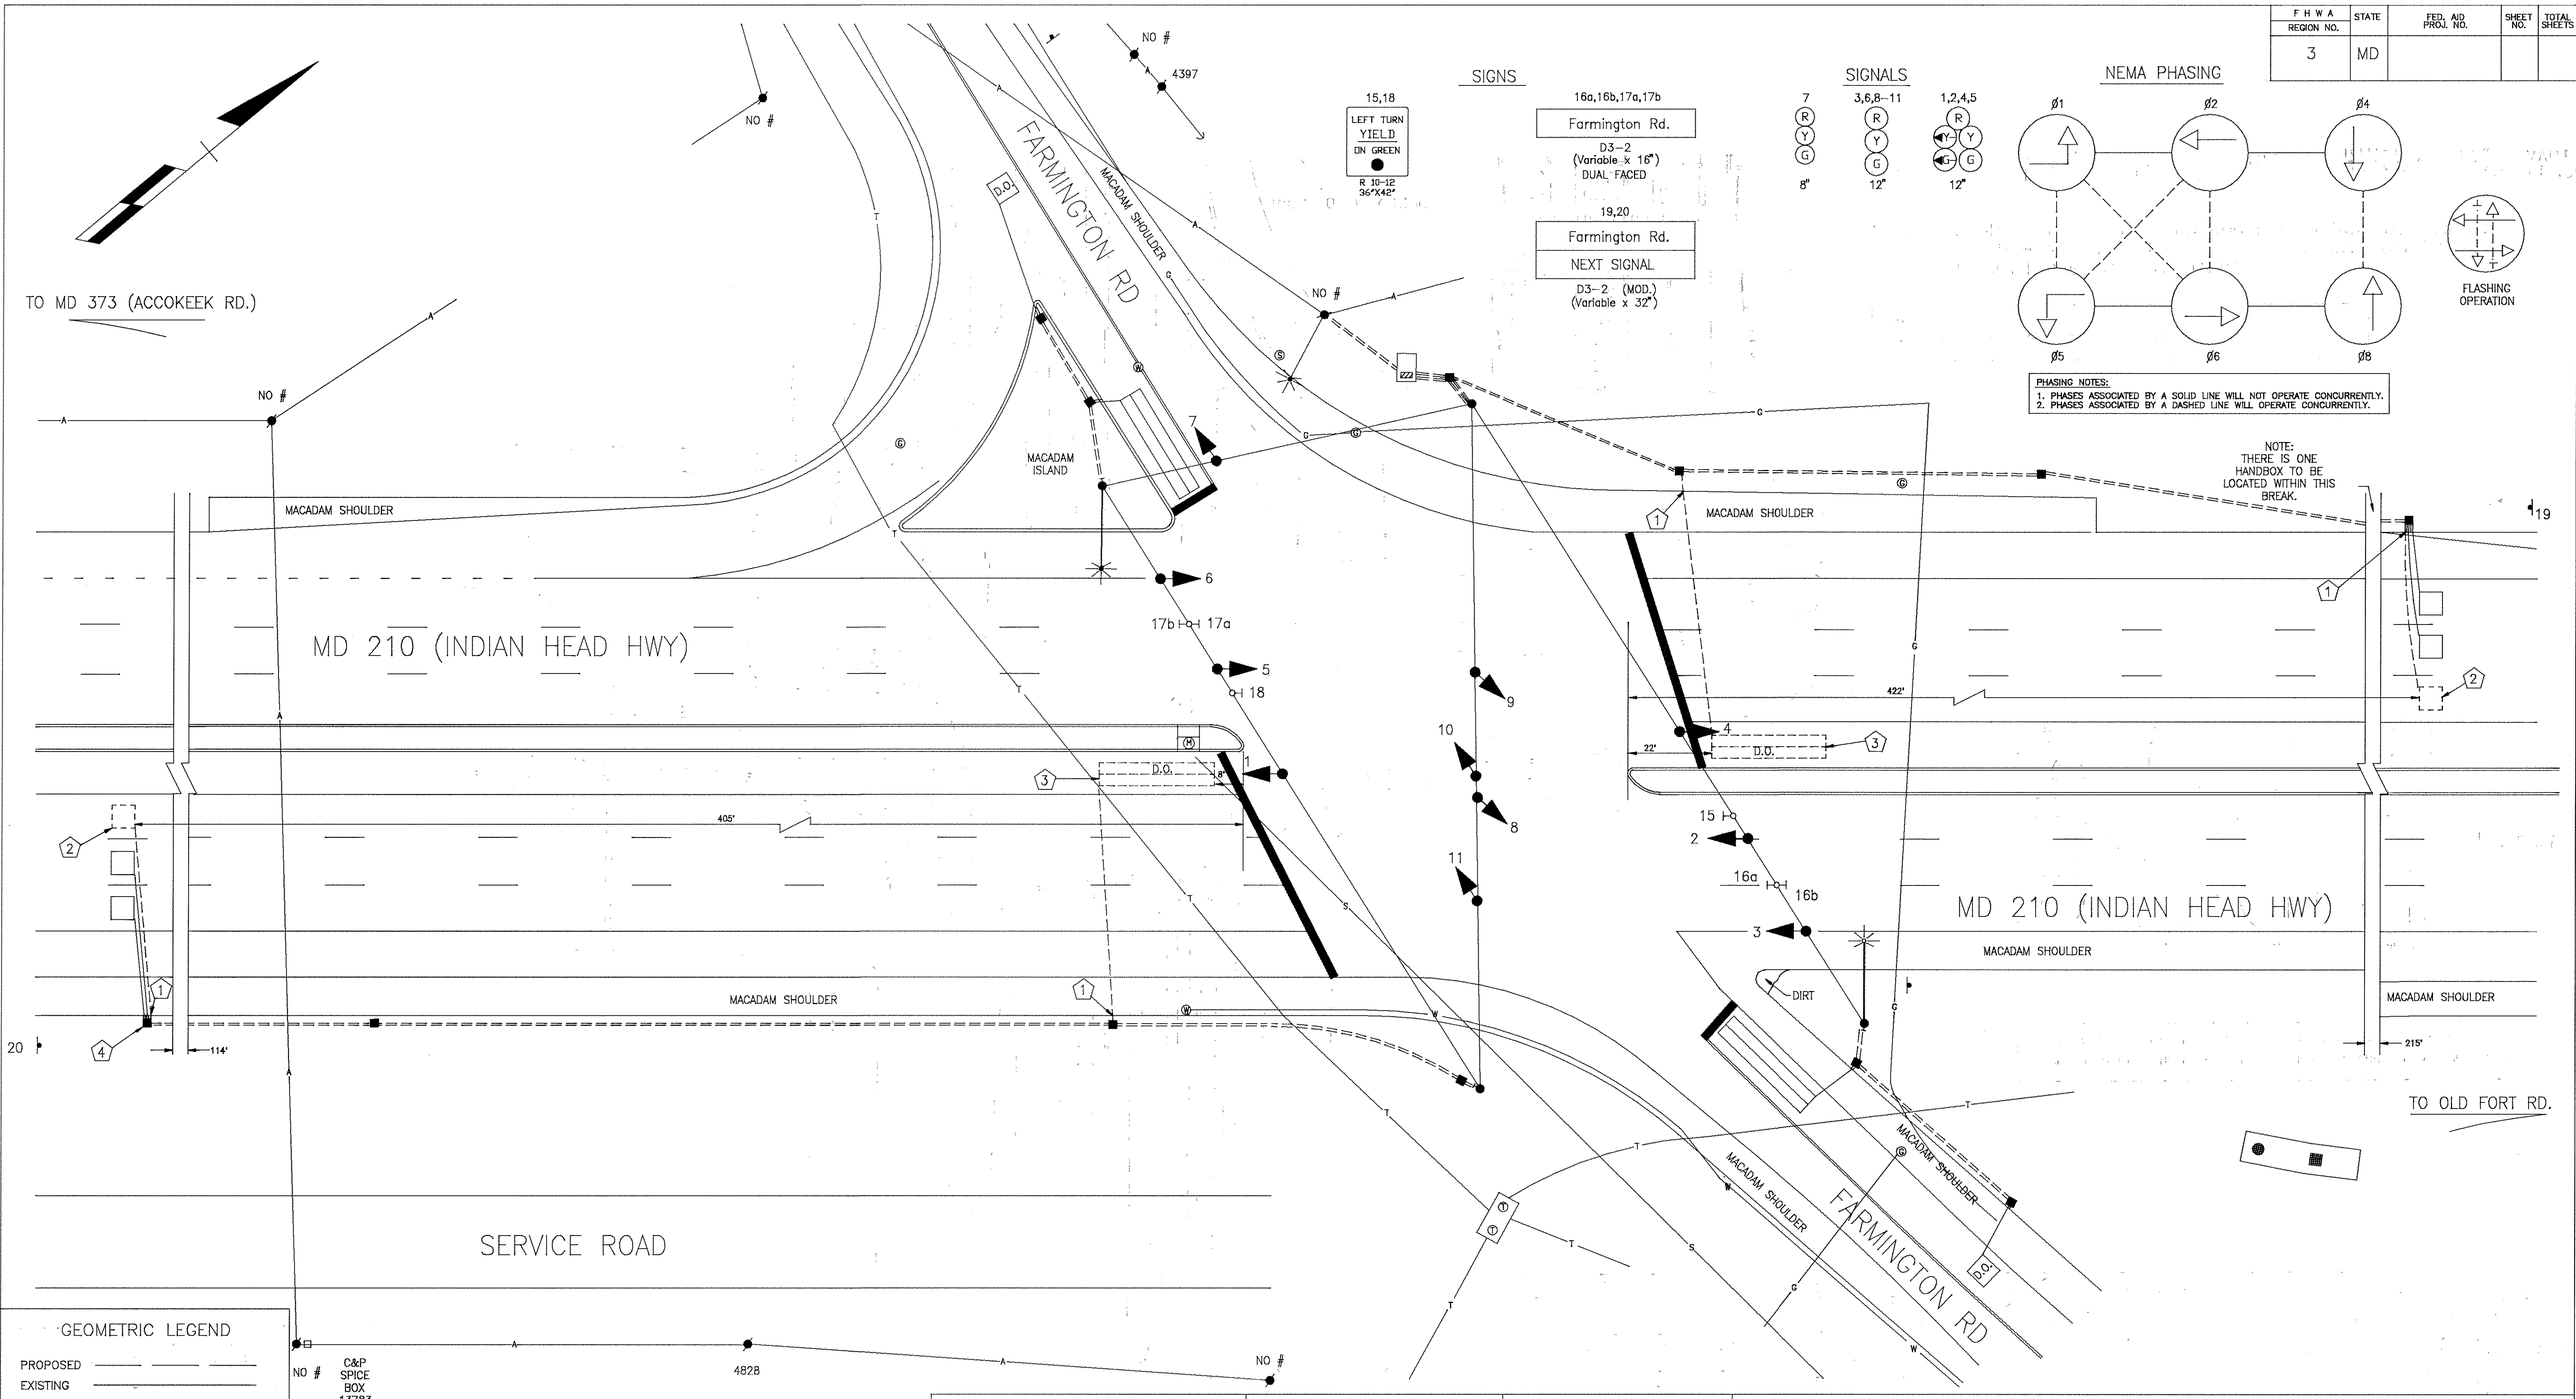

GEOMETRIC LEGEND

PROPOSED
EXISTING

LEGEND OF UNDERGROUND AND OVERHEAD UTILITIES

AERIAL CABLE	A	A	A
ELECTRIC	E	E	E
TELEPHONE	T	T	T
GAS	G	G	G
SEWER	S	S	S
WATER	W	W	W
CABLE TV	TV	TV	TV

STREET TRAFFIC STUDIES, LTD.
Gateway International
1302 Concourse Drive, Suite 104
Linthicum, Maryland 21090
(410) 859-3553

2407

REVISIONS

A ASBUILT 11/94
REVISE MAIN LINE DETECTION DUE TO GEOMETRIC IMPROVEMENTS. P-119-501-370

APPROVALS

CHIEF, SIGNAL DESIGN SECTION
ASST. DISTRICT ENGINEER TRAFFIC
CHIEF, TRAFFIC ENGINEERING DESIGN DIVISION
DIRECTOR, OFFICE OF TRAFFIC AND SAFETY

THIS IS A REVISION TO THE PROJECT CONSTRUCTED UNDER STA. NO. AW-453-501-385. THE ORIGINAL PLAN IS ON FILE

MDOT – STATE HIGHWAY ADMINISTRATION

Office of Traffic and Safety

TRAFFIC ENGINEERING DESIGN DIVISION

SIGNAL NUMBER:
LOG MILE: 16021004.81

DRAWN BY: W J NIES (FOR STS)
DES. BY: R R ZACHERL (FOR STS)
CHK. BY: STEVE RENZI

MD 210 (INDIAN HEAD HWY) AND FARMINGTON RD
COUNTY PRINCE GEORGE'S

DATE: 9-22-93
SCALE: 1"= 20'
F.A.P. NO.
S.H.A. NO. AW-453-501-385
TS/STD. NO. 3355 A
SHEET NO. 1 OF 1