F.H.W.A. REGION NO.	STATE	FED. AID PROJ. NO.	SHEET NO.	TOTAL SHEETS
3	MD.			

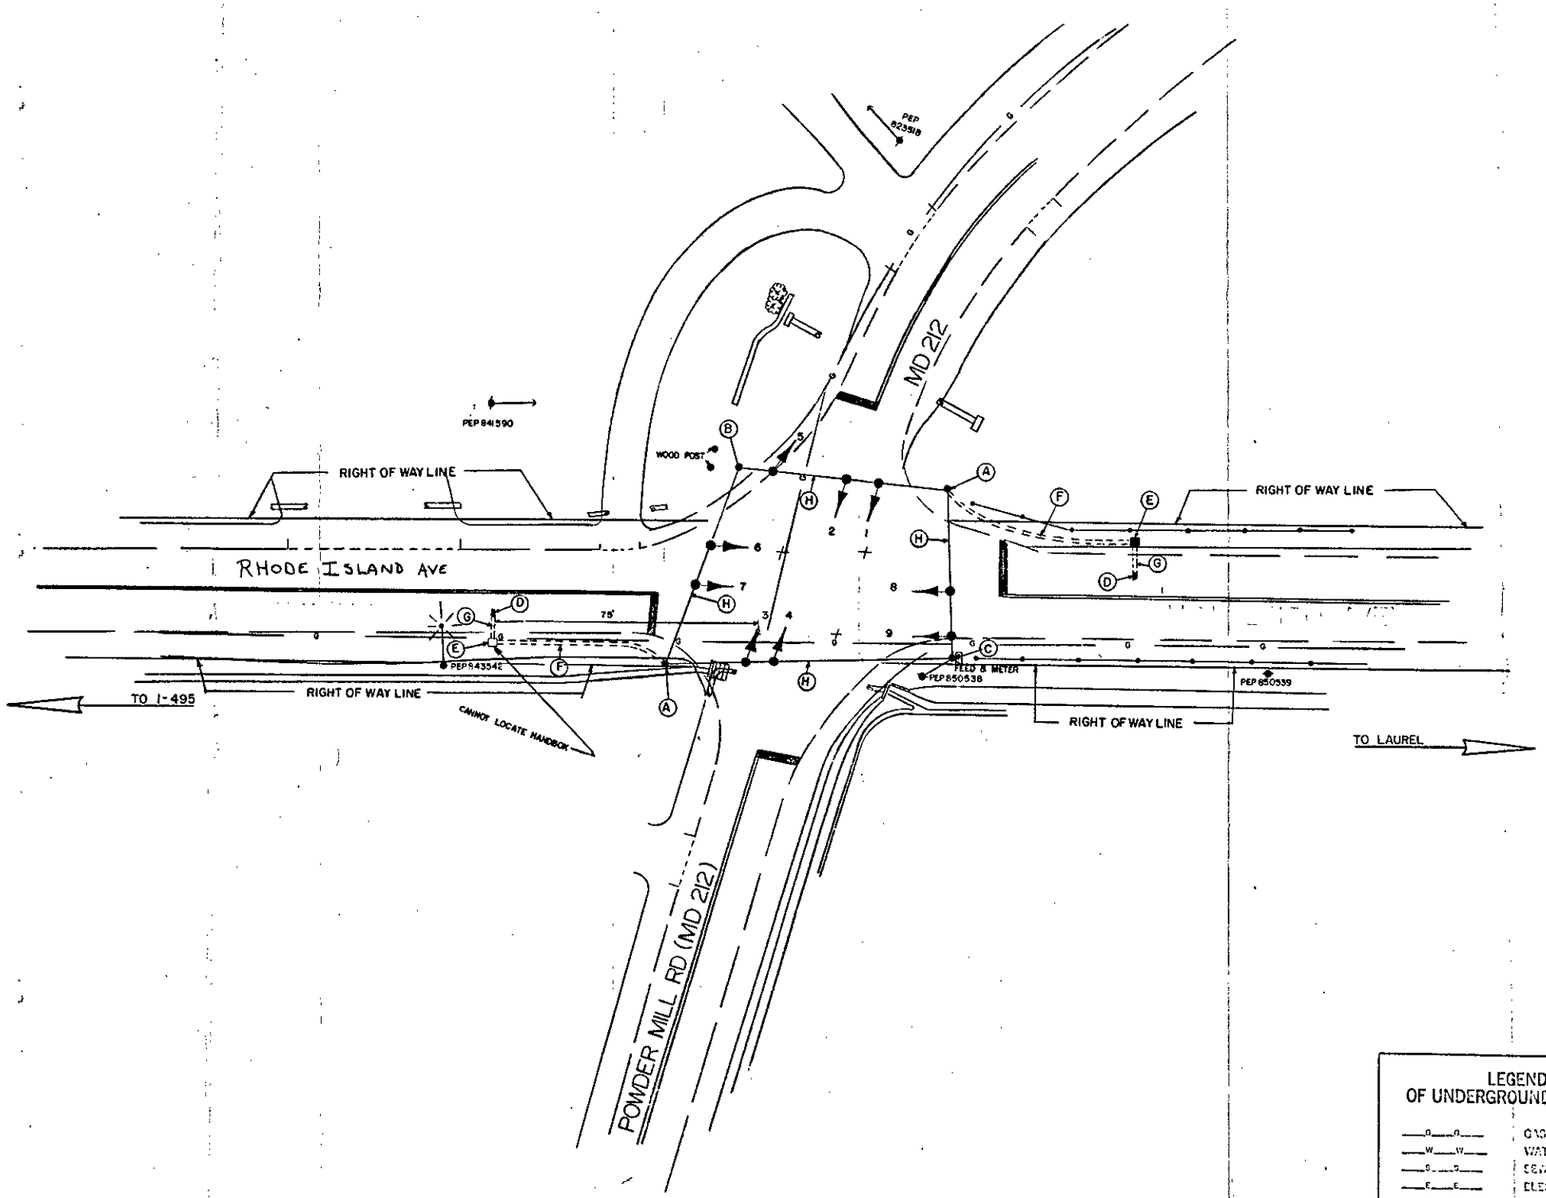

LEGEND OF UNDERGROUND UTILITIES

—G—G—	GAS MAIN
—W—W—	WATER MAIN
—S—S—	SEWER MAIN
—E—E—	ELECTRIC CABLES
—T—T—	TELEPHONE CABLES
—A—A—	AERIAL CABLES

APPROVAL: REGIONAL TRAFFIC ENGINEER

APPROVAL: CHIEF-BUREAU OF TRAFFIC ENGINEERING

APPROVAL: ASS'T. CHIEF ENGINEER TRAFFIC

B	1-14-74 REDRAWN P-159X-375
BT	
A	6-6-70 ASBUILT
LT	

REVISIONS

STATE OF MARYLAND
DEPARTMENT OF TRANSPORTATION
STATE HIGHWAY ADMINISTRATION

TRAFFIC DIVISION – BUREAU OF TRAFFIC ENGINEERING

~~US1~~ & MD 212 (POWDER MILL RD)
Rhode Island AVE

SCALE 1"=20' DATE 3-20-70 CONTRACT NO.

DRAWN BY: LES TOWNSEND COUNTY: PRINCE GEORGES

DESIGNED BY: SIGNAL NO.:

CHECKED BY:

DRAWING NO. TS-62B

16021209.79

BRUNING 44-511 19927