F.H.W.A. REGION NO.	STATE	FED. AID PROJ. NO.	SHEET NO.	TOTAL SHEETS
3	MD.	M5030(1)	2	5

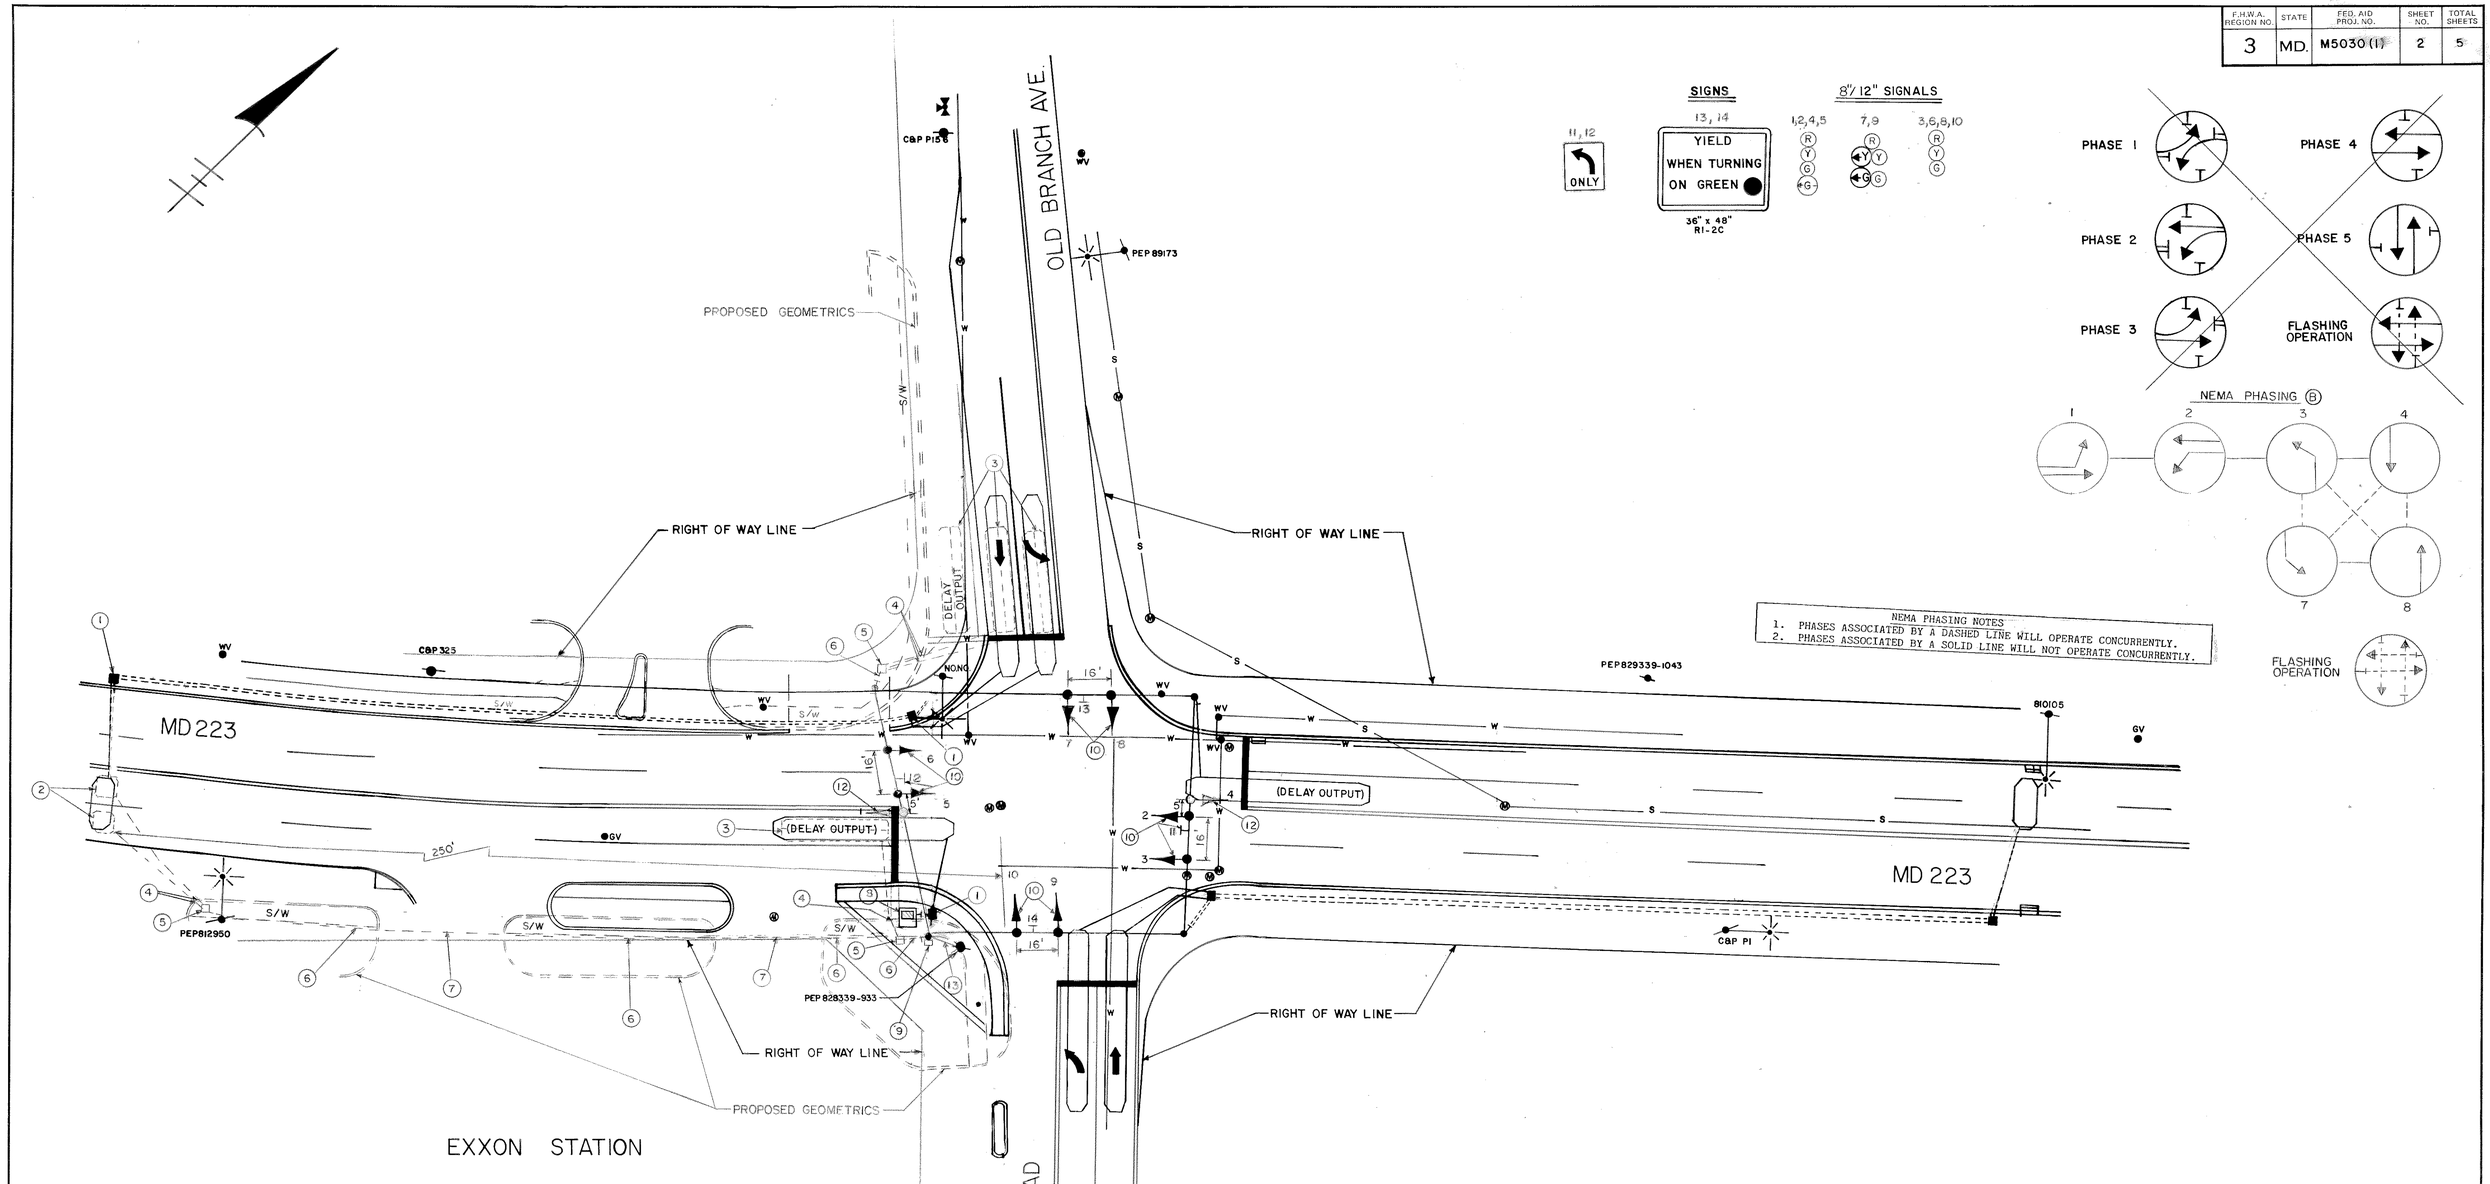

APPROVAL: CHIEF SIGNAL DESIGN SECTION

APPROVAL: DISTRICT TRAFFIC ENGINEER

APPROVAL: CHIEF - BUREAU OF TRAFFIC ENGINEERING

APPROVAL: DEPUTY CHIEF ENGINEER, OFFICE OF TRAFFIC

REVISIONS

(B) 2/20/86
RELOCATED EQUIPMENT & Ø'ing DUE TO GEOMETRICS
S.H.A. No 855-25006
DLA | RC | WM | ZPP | TS | RHS

REDRAWN - ORIGINAL ON FILE 6-20-85

DZ

STATE OF MARYLAND
DEPARTMENT OF TRANSPORTATION
STATE HIGHWAY ADMINISTRATION
BUREAU OF TRAFFIC ENGINEERING
OFFICE OF TRAFFIC

MD 223 & OLD BRANCH AVENUE - BRANDY WINE ROAD

SURVEY BOOK 15902

SCALE 1"=20' | DATE 10-6-77 | CONTRACT NO. P585-501-385 F.A.P. NO. M-5030(1)

DRAWN BY: N/A | COUNTY: PRINCE GEORGES'

DESIGNED BY: N/A | SIGNAL NO.:

CHECKED BY: N/A

DRAWING NO. TS-1543B