FED. ROAD DIV. NO.	STATE	FED. AID PROJ. NO	SHEET NO.	TOTAL SHEETS
3	MD.		2	5

Revision "B"
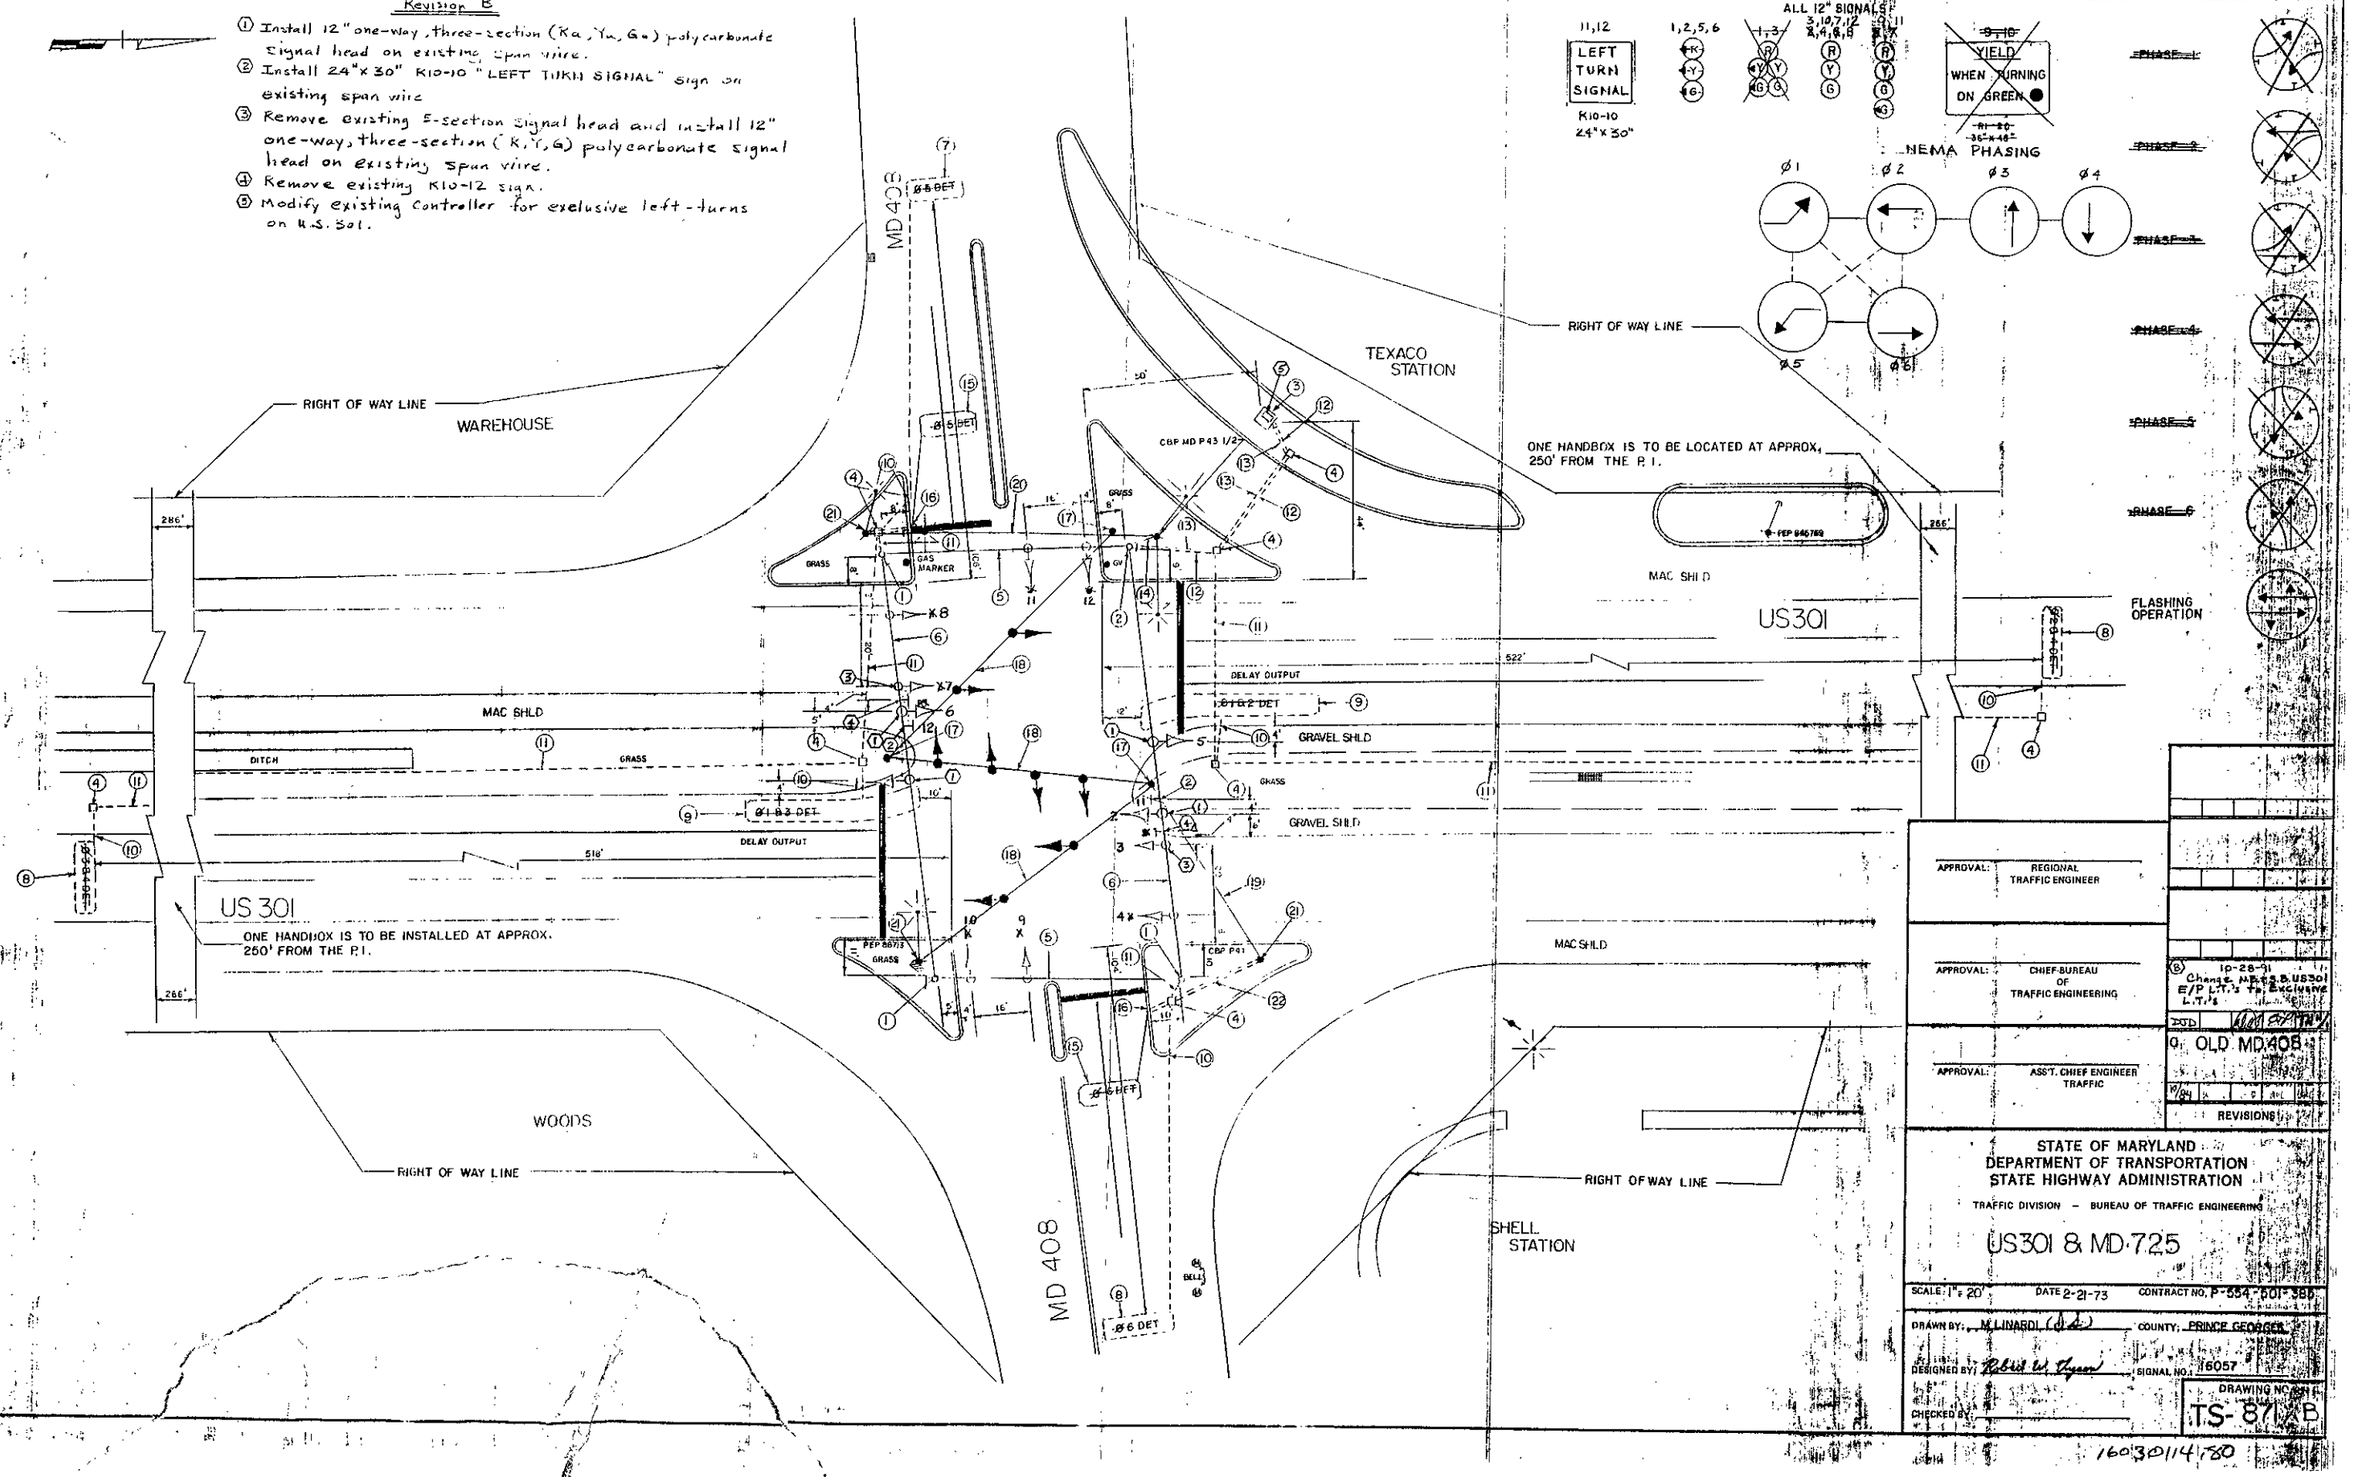
1. Install 12" one-way, three-section (Ra, Ya, Ga) polycarbonate signal head on existing span wire.
2. Install 24"x30" K10-10 "LEFT TURN SIGNAL" sign on existing span wire
3. Remove existing 5-section signal head and install 12" one-way, three-section (R, Y, G) polycarbonate signal head on existing span wire.
4. Remove existing K10-12 sign.
5. Modify existing controller for exclusive left-turns on U.S. 301.