K&E BALTIMORE 17 0153 PHOENIX 10-75 MC 4156.

F.H.W.A. REGION NO.	STATE	FED. AID PROJ. NO.	SHEET NO.	TOTAL SHEETS
3	MD.	MG-5104(1)	2	19.

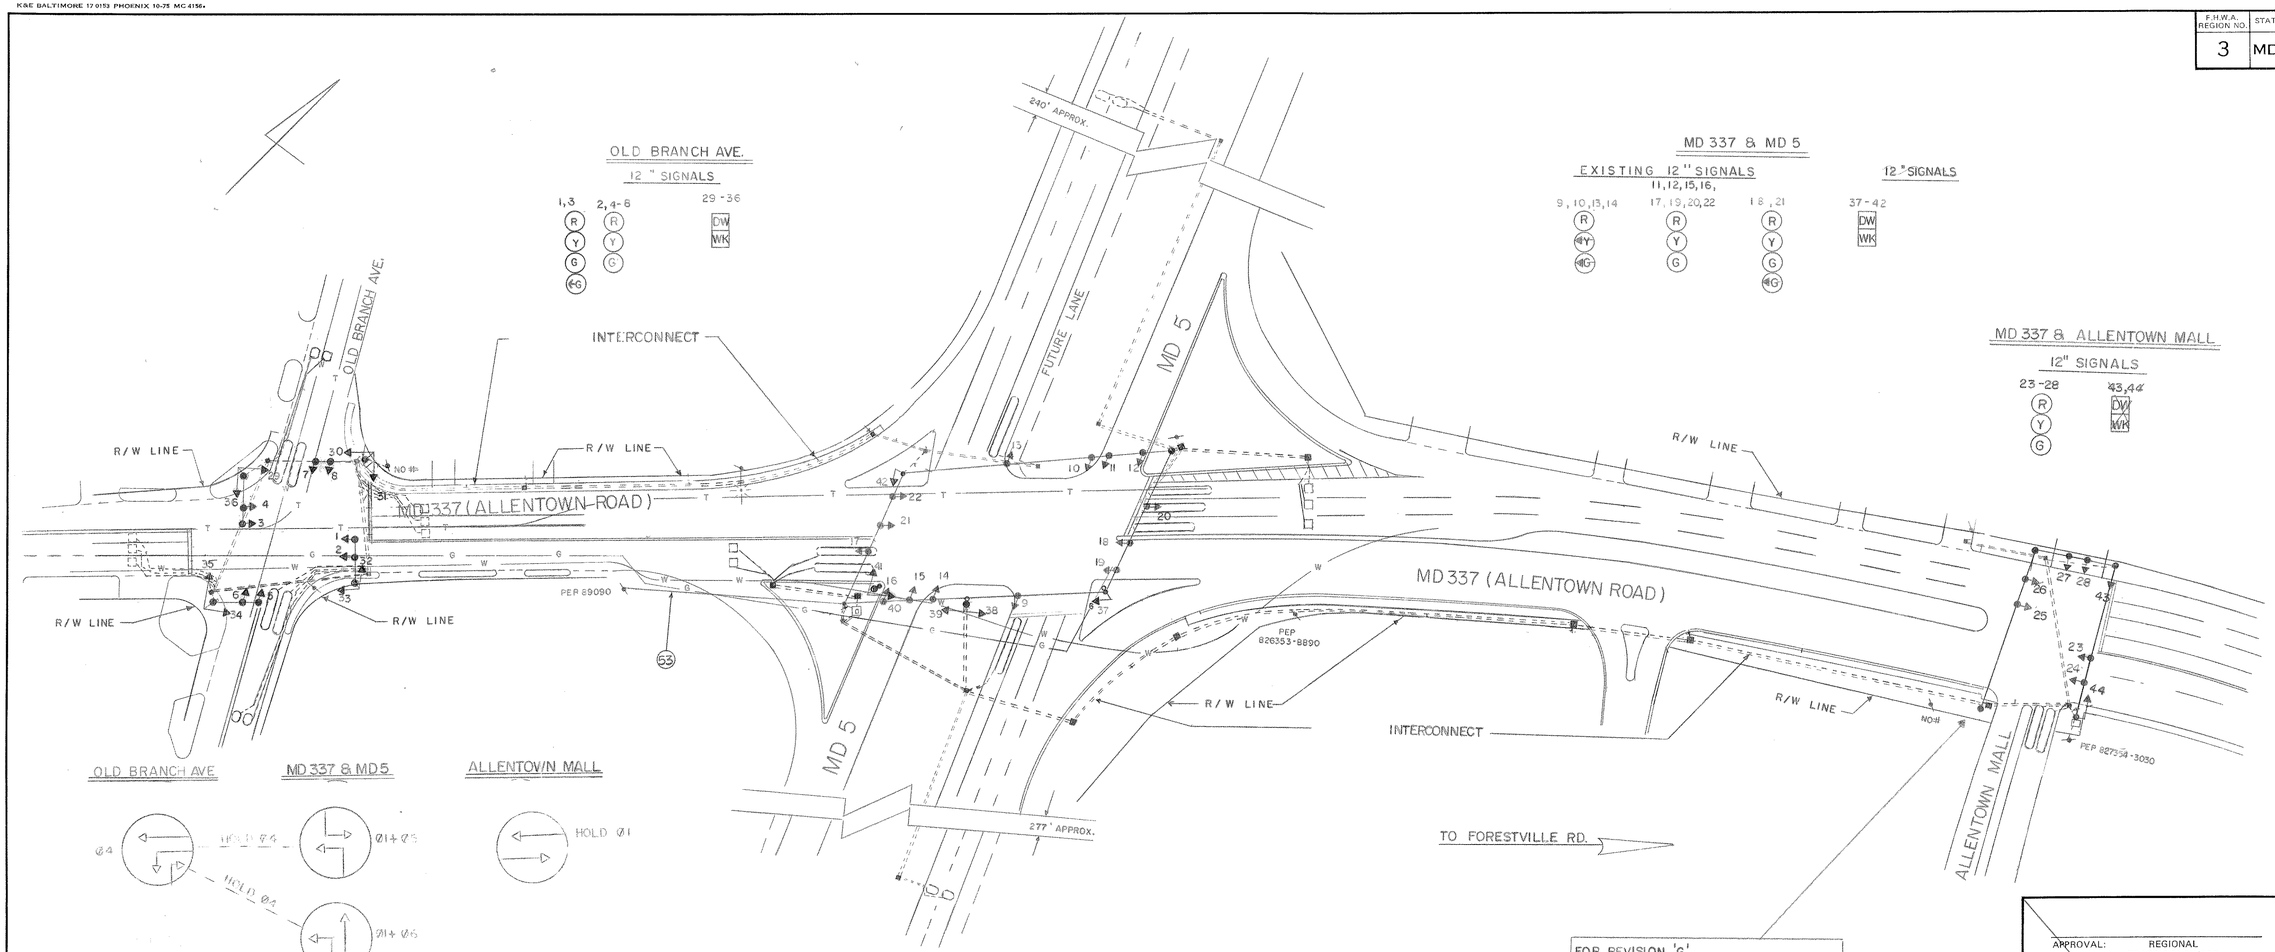

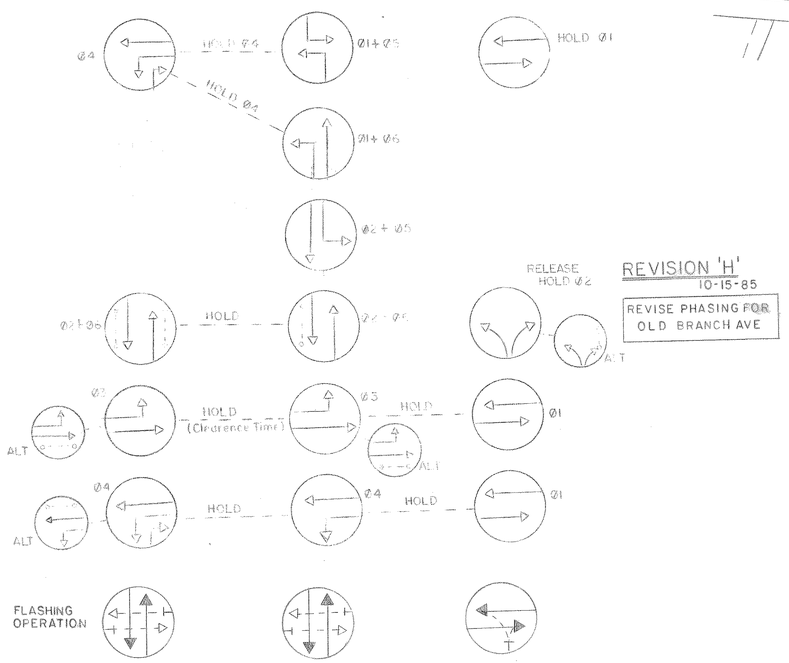

FOR REVISION 'G'
ALLENTOWN MALL SEE SHEET NO. 5
TS-1205

NOTES:

1. FOR DETAIL OF ALLENTOWN MALL SEE TS-1206
2. FOR DETAIL OF OLD BRANCH AVE. SEE TS-1208
3. FOR DETAIL OF MD 5 SEE TS-1204.
4. FOR R/W SEE PLAT NO. 44070

REVISION 'H'
10-15-85
REVISE PHASING FOR OLD BRANCH AVE

REVISION 'A'
NOTE NO. 5

THE RELEASE AT OLD BRANCH AVE WILL BE REMOVED ON SOUTHBOUND GREEN MD 5 AND THE RELEASE AT ALLENTOWN MALL WILL BE REMOVED ON NORTHBOUND GREEN MD 5. MD 5 WILL BE ON RECALL

LEGEND OF UNDERGROUND UTILITIES

—G—G—	GAS MAIN
—W—W—	WATER MAIN
—S—S—	SEWER MAIN
—E—E—	ELECTRIC CABLES
—T—T—	TELEPHONE CABLES
—A—A—	AERIAL CABLES

APPROVAL: REGIONAL TRAFFIC ENGINEER

APPROVAL: CHIEF-BUREAU OF TRAFFIC ENGINEERING

APPROVAL: ASS'T. CHIEF ENGINEER TRAFFIC

H	10-15-85	REVISE PHASING FOR OLD BRANCH AVE SHA NO. 855-25006
JJD		
G	REVISION 2-83	USE EXT. BOX SPAN BUT INSTALL LOOPS AND CAB P-407-501-385
EMM	SR	
A	10/16/81	REVISE PHASING AND NOTE NO. 5
SR		

REVISIONS

STATE OF MARYLAND
DEPARTMENT OF TRANSPORTATION
STATE HIGHWAY ADMINISTRATION

TRAFFIC DIVISION — BUREAU OF TRAFFIC ENGINEERING

INTERCONNECT AT MD 337, OLD BRANCH, MD 5 & ALLENTOWN MALL

SCALE 1" = 50' DATE 4/29/78 CONTRACT NO. P-407-501-385

DRAWN BY: STEVE RENZI COUNTY: PRINCE GEORGES

DESIGNED BY: SIGNAL NO.: 16152, 16151, 16325

CHECKED BY:

DRAWING NO. TS-1389H