K&E BALTIMORE 17 0153 PHOENIX 10-75 MC 4156.

F.H.W.A. REGION NO.	STATE	FED. AID PROJ. NO.	SHEET NO.	TOTAL SHEETS
3	MD.	MG-5104(1)	11	19

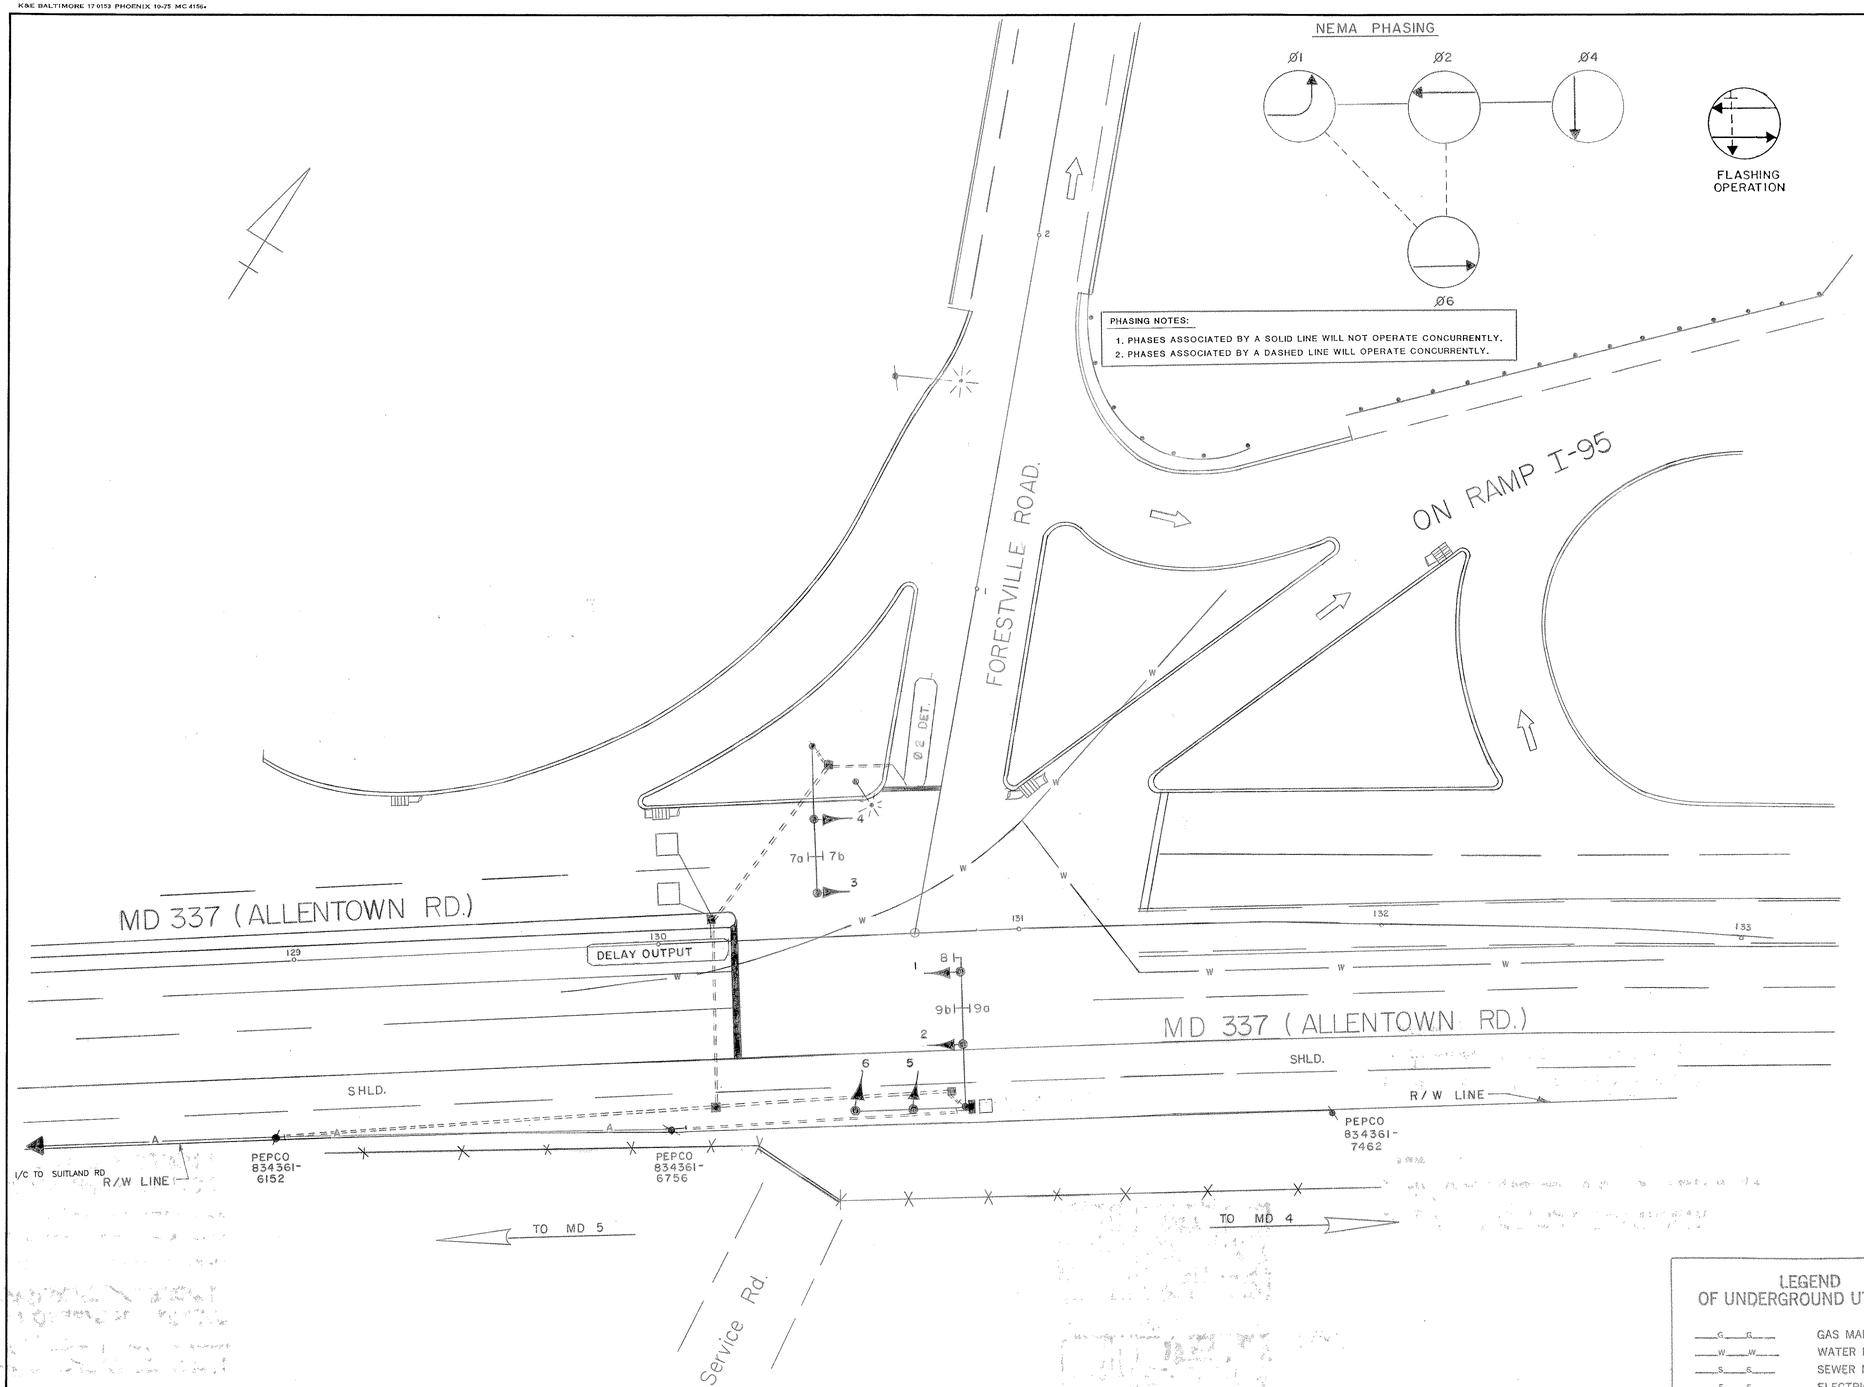

12" SIGNALS

1: R, Y, G

2-6: R, Y, G

SIGNS

8: LEFT TURN YIELD ON GREEN

R10-12 36"x42"

7a, 9b — ← Forestville Rd

7b, 9a — Forestville Rd →

D3-2 VARIABLE X 16"

APPROVAL: REGIONAL TRAFFIC ENGINEER

APPROVAL: CHIEF-BUREAU OF TRAFFIC ENGINEERING

APPROVAL: ASS'T. CHIEF ENGINEER TRAFFIC

Ⓐ 1-17-92 ASBUILT

RRZ

REVISIONS

STATE OF MARYLAND
DEPARTMENT OF TRANSPORTATION
STATE HIGHWAY ADMINISTRATION

TRAFFIC DIVISION — BUREAU OF TRAFFIC ENGINEERING

MD 337 (ALLENTOWN RD.) & FORESTVILLE ROAD.

SCALE 1" = 20' DATE 6/27/78 CONTRACT NO. P-407-501-385

DRAWN BY: STEVE RENZI COUNTY: PRINCE GEORGES

DESIGNED BY: SIGNAL NO.: 16459

CHECKED BY:

DRAWING NO. TS-395 A