K&E BALTIMORE 17 0153 PHOENIX 10-75 MC 4156

F.H.W.A. REGION NO.	STATE	FED. AID PROJ. NO.	SHEET NO.	TOTAL SHEETS
3	MD.	MG-5104(1)	[illegible]	[illegible]

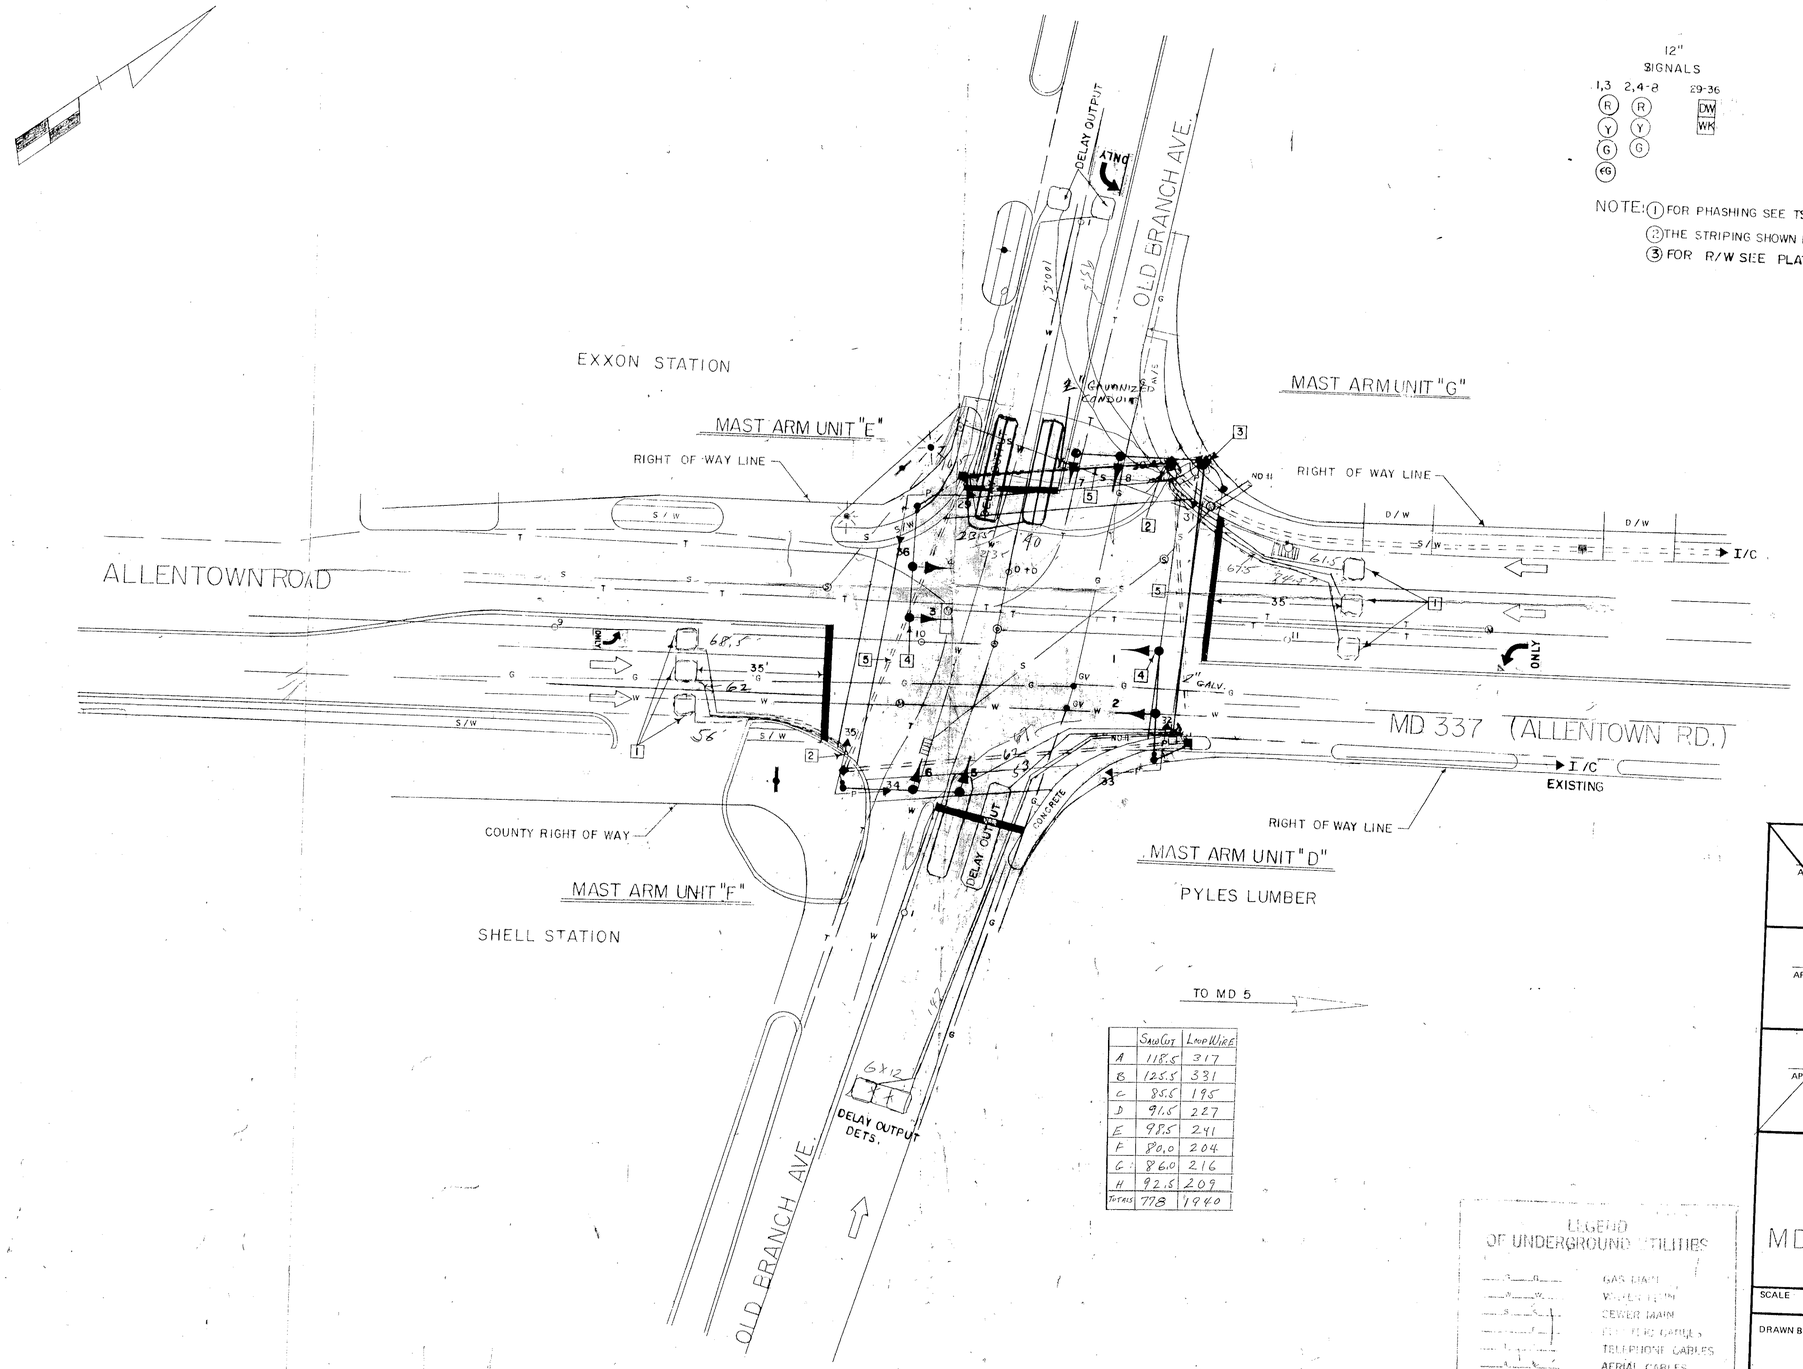

	Saw Cut	Loop Wire
A	118.5	317
B	125.5	331
C	85.5	195
D	91.5	227
E	98.5	241
F	80.0	204
G	86.0	216
H	92.5	209
Totals	778	1940

LEGEND OF UNDERGROUND UTILITIES

GAS MAIN
WATER MAIN
SEWER MAIN
ELECTRIC CABLES
TELEPHONE CABLES
AERIAL CABLES

16033700.00

APPROVAL: REGIONAL TRAFFIC ENGINEER

APPROVAL: CHIEF-BUREAU OF TRAFFIC ENGINEERING

APPROVAL: ASS'T. CHIEF ENGINEER TRAFFIC

AS BUILT 6-30-86
BTO# L-214
Hawkins Electric Company, Inc.
TRAFFIC CONTROLS DIVISION

A 10-15-85
REVISE PHASING, NEW LOOPS, SIGNAL NOS. 1-3
SHA NO. 855-25006
JJD

REVISIONS

STATE OF MARYLAND
DEPARTMENT OF TRANSPORTATION
STATE HIGHWAY ADMINISTRATION

TRAFFIC DIVISION – BUREAU OF TRAFFIC ENGINEERING

MD 337 (ALLENTOWN ROAD) & OLD BRANCH AVENUE

SCALE 1" = 20' DATE 7/26/77 CONTRACT NO. P-407-501-385

DRAWN BY: STEVE RENZI COUNTY: PRINCE GEORGES

DESIGNED BY: SIGNAL NO.: 16152

CHECKED BY:

DRAWING NO.