| F.H.W.A. REGION NO. | STATE | FED. AID PROJ. NO. | SHEET NO. | TOTAL SHEETS |
|---|---|---|---|---|
| 3 | MD. | MG-5104(1) | 11 | 19 |

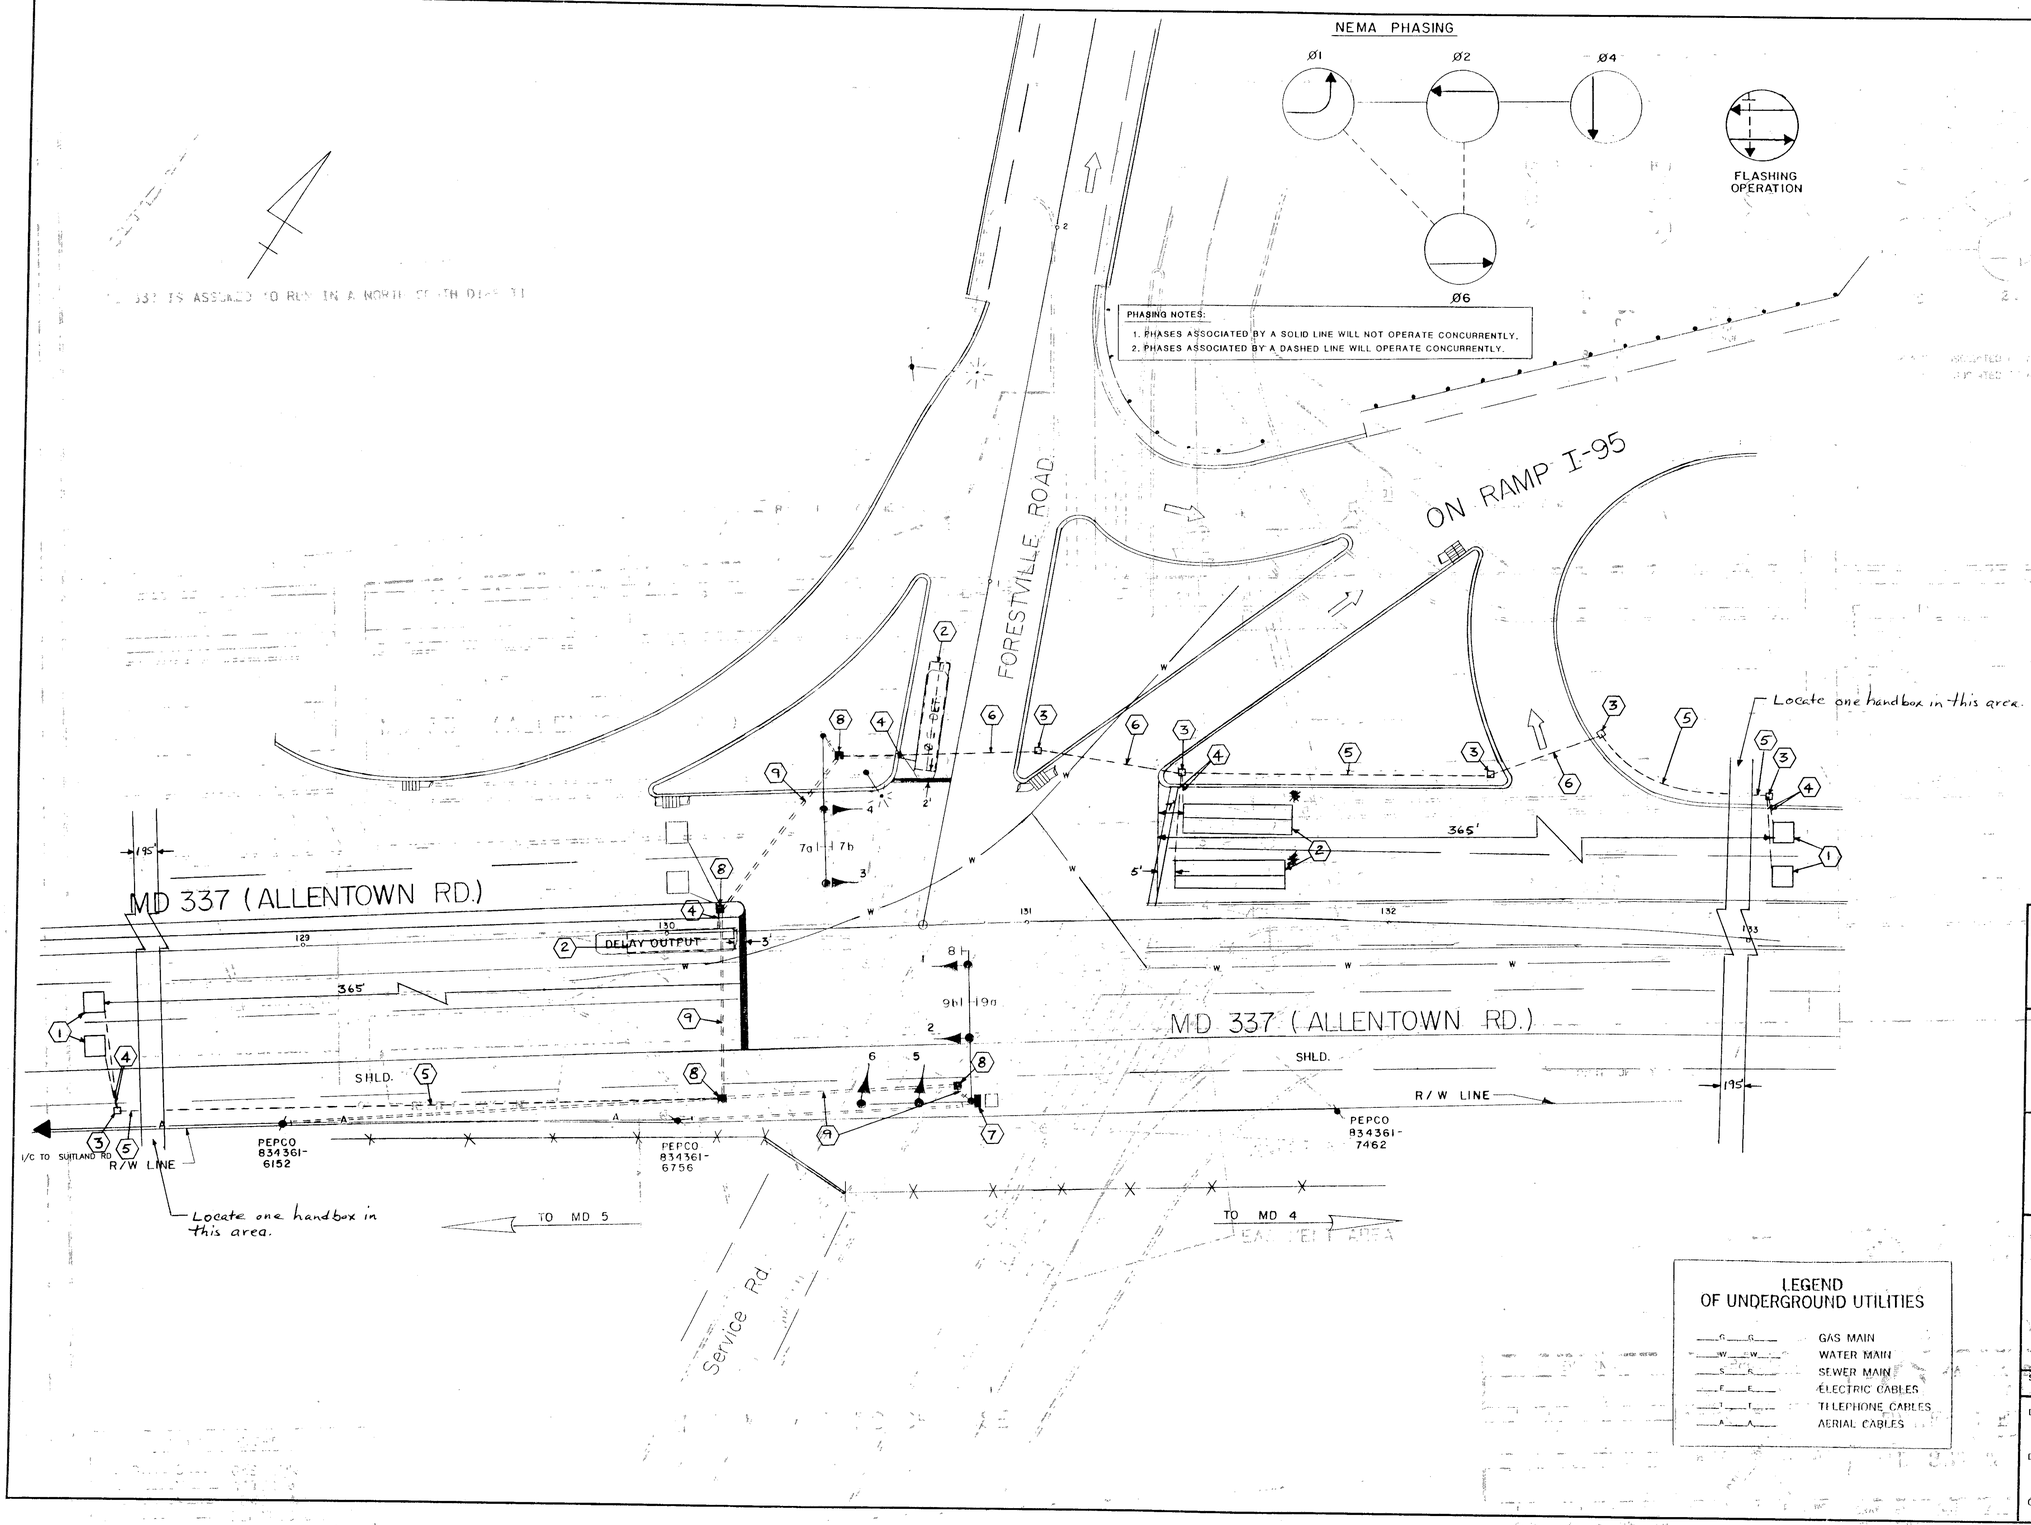


APPROVAL: REGIONAL TRAFFIC ENGINEER

APPROVAL: CHIEF-BUREAU OF TRAFFIC ENGINEERING

APPROVAL: ASS'T. CHIEF ENGINEER TRAFFIC

(B) 7-15-93 Upgrade existing loops + install loops for full-traffic actuation

(A) 1-17-92 ASBUILD

RRZ

REVISIONS

STATE OF MARYLAND
DEPARTMENT OF TRANSPORTATION
STATE HIGHWAY ADMINISTRATION

TRAFFIC DIVISION – BUREAU OF TRAFFIC ENGINEERING

# MD 337 (ALLENTOWN RD.) & FORESTVILLE ROAD

SCALE 1" = 20' DATE 6/27/78 CONTRACT NO. P-407-501-385

DRAWN BY: STEVE RENZI COUNTY: PRINCE GEORGES

DESIGNED BY: SIGNAL NO.: 16459

CHECKED BY:

DRAWING NO. TS-395 B

16033702.21

F#50