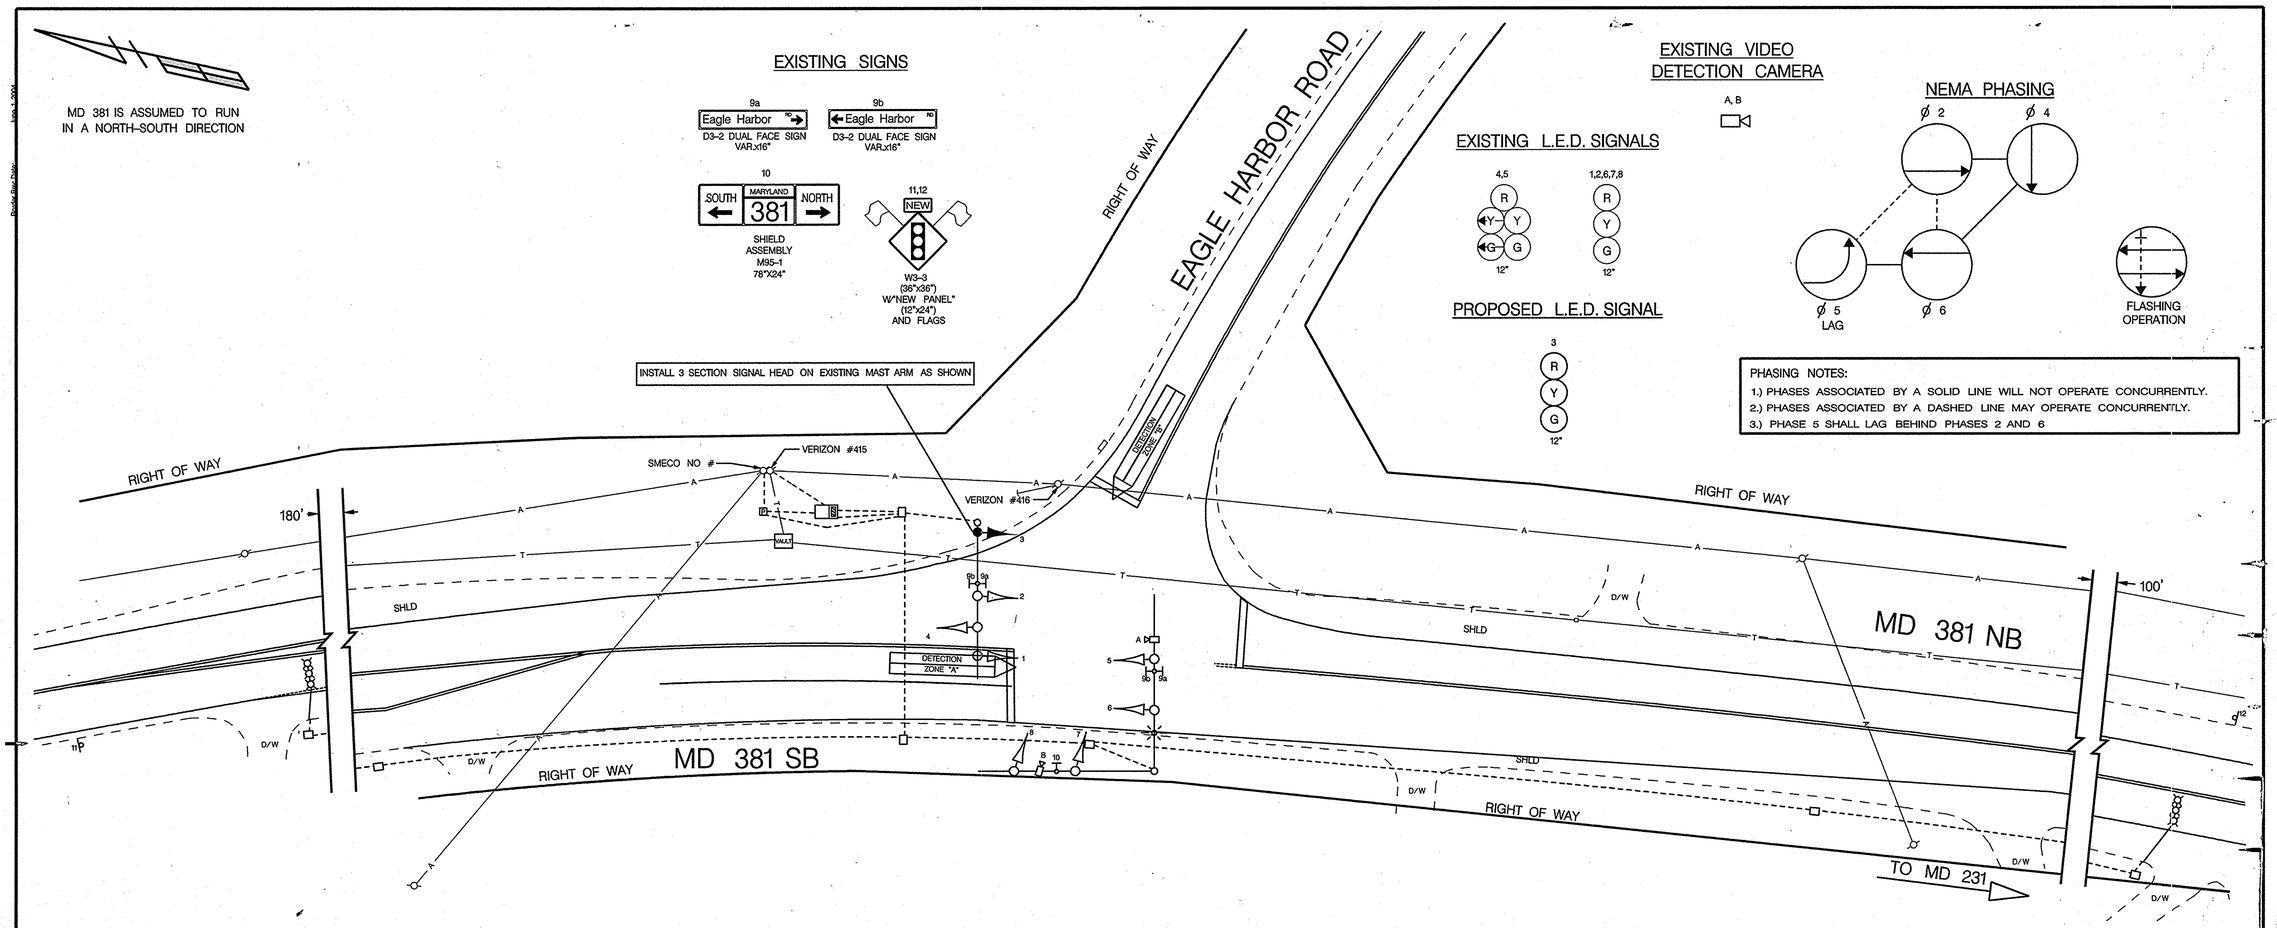

LEGEND OF UNDERGROUND AND OVERHEAD UTILITIES

AERIAL CABLE	A
ELECTRICAL	E
TELEPHONE	T
GAS	G
SEWER	S
WATER	W
CABLE TV	TV

TRAFFIC CONCEPTS, INC.
325 Gambrills Road
Suite E
Gambrills, MD 21054
(410) 923-7101
FAX: (410) 923-6473
EMAIL: TRAFFIC@TRAFFIC-CONCEPTS.COM

APPROVALS

TEAM LEADER

ASST. DIV. CHIEF

DIVISION CHIEF

OFFICE DIRECTOR

REVISIONS

A INSTALL N/B MD 381 NEAR SIGNAL HEAD
10-21-08
SR CJS T.H.

SHA
STATE OF MARYLAND
DEPARTMENT OF TRANSPORTATION
STATE HIGHWAY ADMINISTRATION
OFFICE OF TRAFFIC & SAFETY
TRAFFIC ENGINEERING DESIGN DIVISION

TRAFFIC SIGNAL PLAN

MD 381 AND EAGLE HARBOR ROAD (AQUASCO, MD)

SCALE 1"=20' DATE 3-11-08 CONTRACT NO. BW996M82

DESIGNED BY	T. ZAYDEL	COUNTY	PRINCE GEORGE'S
DRAWN BY	M. ROSEN	LOGMILE	16038101.75
CHECKED BY	S. RENZI	T.I.M.S. NO.	I-909
F.A.P. NO.	N/A	TOD NO.	

DRAWING NO. TS- 4636 A SHEET NO. 1 OF 2