F.H.W.A. REGION NO.	STATE	FED. AID PROJ. NO.	SHEET NO.	TOTAL SHEETS
3	MD.			

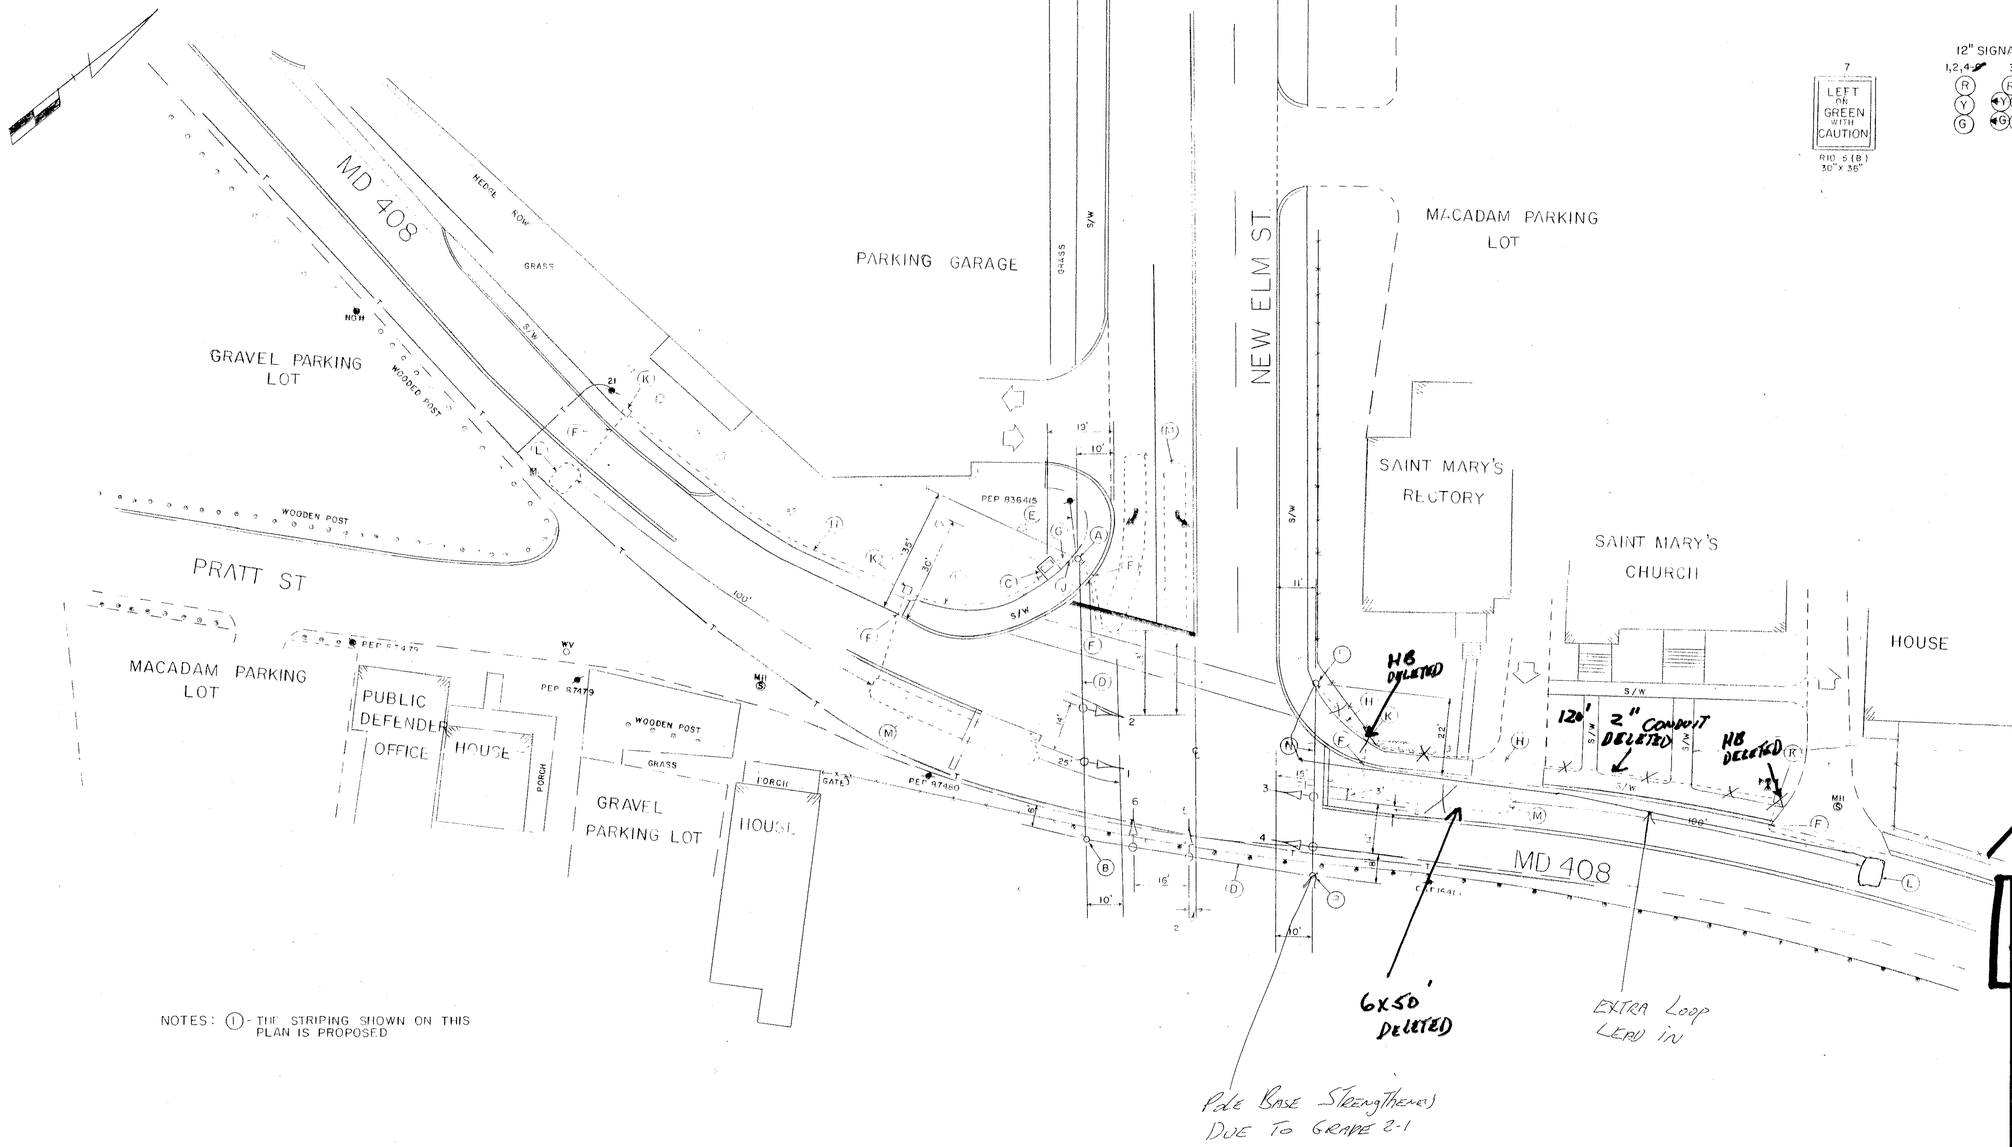

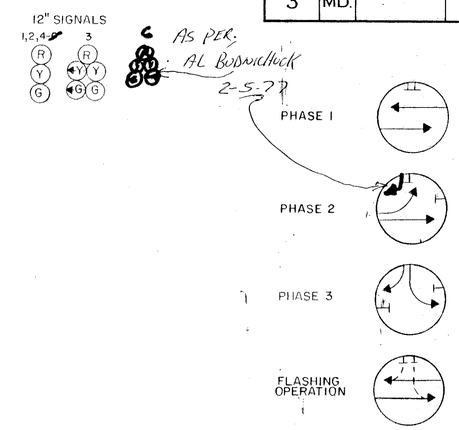

NOTES: (1) - THE STRIPING SHOWN ON THIS PLAN IS PROPOSED

16052
AS BUILT
3-11-77

APPROVAL: REGIONAL TRAFFIC ENGINEER

APPROVAL: CHIEF-BUREAU OF TRAFFIC ENGINEERING

ASBUILT 3-9-77
BCP

APPROVAL: ASS'T. CHIEF ENGINEER TRAFFIC 8/19/76

REVISIONS

STATE OF MARYLAND
DEPARTMENT OF TRANSPORTATION
STATE HIGHWAY ADMINISTRATION

TRAFFIC DIVISION – BUREAU OF TRAFFIC ENGINEERING

MD 408 & ~~NEW ELM ST.~~ GOV. ODEN BOWIE DR.

SCALE 1" = 20 | DATE 6-22-76 | CONTRACT NO. P 502X-000-385

DRAWN BY: J SERIO | COUNTY: PRINCE GEORGE'S

DESIGNED BY: | SIGNAL NO. 16052

CHECKED BY: 8/10/76 | DRAWING NO. TS-1422

16040800.00

BRUNING 44-511 19927