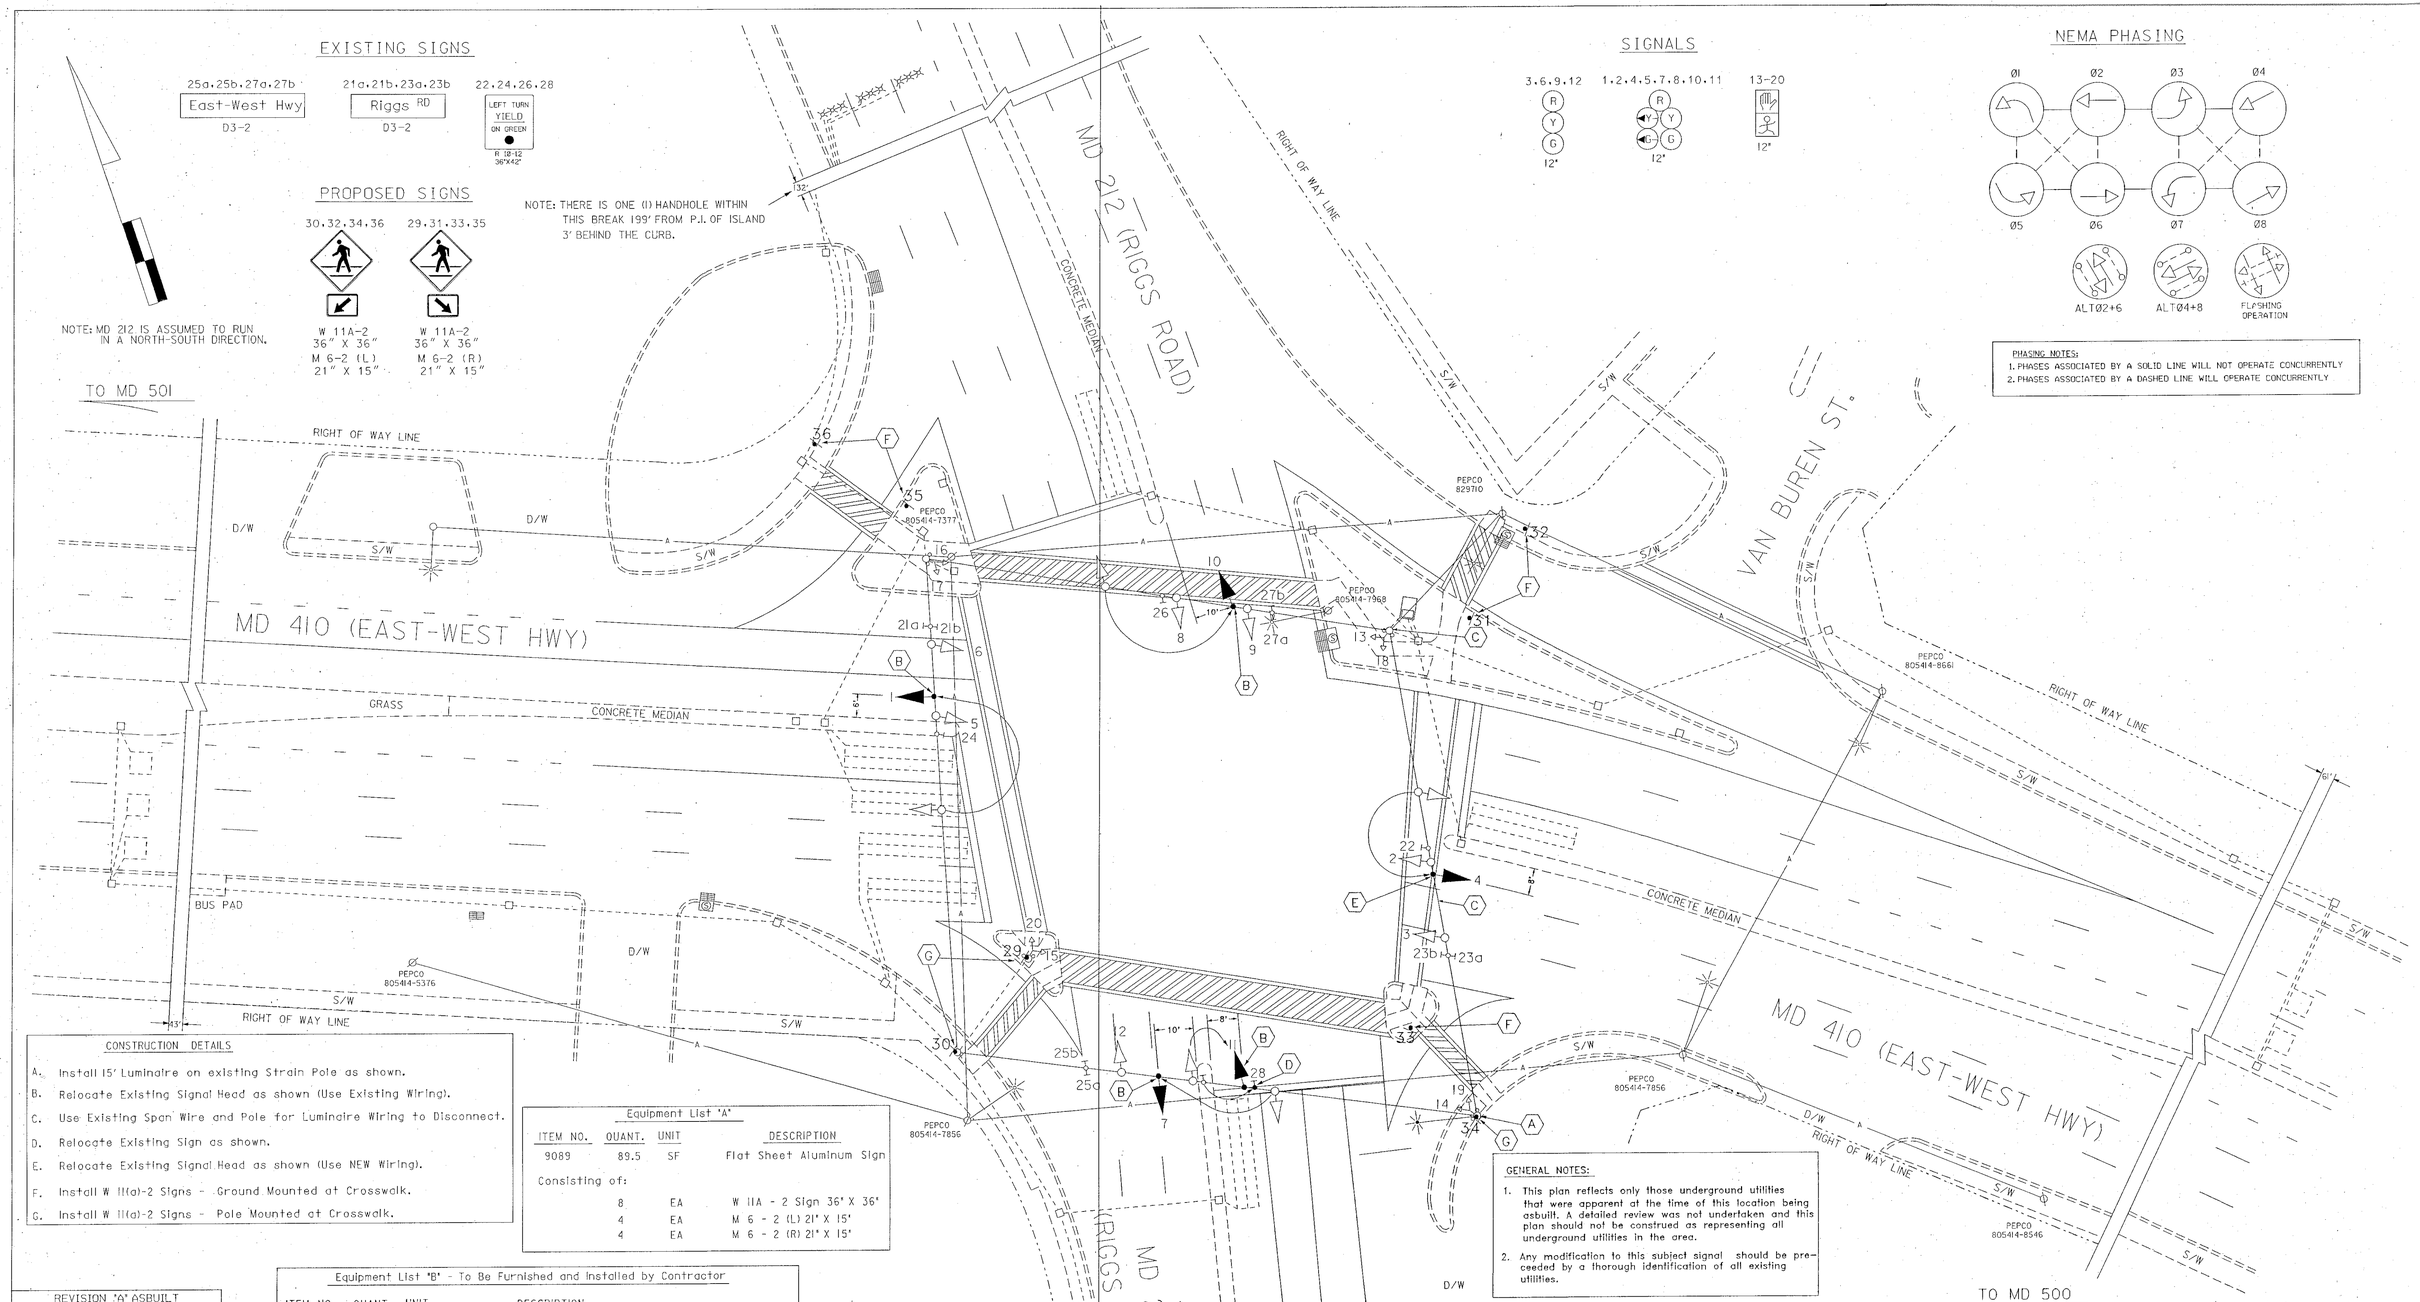

CONSTRUCTION DETAILS

A. Install 15' Luminaire on existing Strain Pole as shown.
B. Relocate Existing Signal Head as shown (Use Existing Wiring).
C. Use Existing Span Wire and Pole for Luminaire Wiring to Disconnect.
D. Relocate Existing Sign as shown.
E. Relocate Existing Signal Head as shown (Use NEW Wiring).
F. Install W 11(a)-2 Signs - Ground Mounted at Crosswalk.
G. Install W 11(a)-2 Signs - Pole Mounted at Crosswalk.

Equipment List 'A'

ITEM NO.	QUANT.	UNIT	DESCRIPTION
9089	89.5	SF	Flat Sheet Aluminum Sign
Consisting of:			
	8	EA	W 11A - 2 Sign 36" X 36"
	4	EA	M 6 - 2 (L) 21" X 15"
	4	EA	M 6 - 2 (R) 21" X 15"

Equipment List 'B' - To Be Furnished and Installed by Contractor

ITEM NO.	QUANT.	UNIT	DESCRIPTION
1001	1	Each	MAINTENANCE of TRAFFIC
8044	120	LF	7 Conductor Electrical Cable (No. 14 AWG)
NEG.	200	LF	2 Conductor Electrical Cable (No. 12 AWG) - Type TC
NEG.	1	Each	15' Luminaire arm w/ 250W HPS Luminaire
NEG.	5	Each	Relocate Signal Head
NEG.	1	Each	Relocate Sign
NEG.	56	SF	Install Ground Mounted Sign
NEG.	33.5	SF	Install Pole Mounted Sign

GENERAL NOTES:

1. This plan reflects only those underground utilities that were apparent at the time of this location being asbuilt. A detailed review was not undertaken and this plan should not be construed as representing all underground utilities in the area.
2. Any modification to this subject signal should be preceded by a thorough identification of all existing utilities.

REVISION 'A' ASBUILT

STREET TRAFFIC STUDIES, LTD.
Gateway International
1302 Concourse Drive, Suite 104
Linthicum, Maryland 21090
Ph. (410) 859-3553
Fax (410) 859-3579
3470A.DGN

UTILITY LEGEND

G	GAS MAIN
W	WATER MAIN
S	SEWER MAIN
E	ELECTRIC CABLES
A	AERIAL CABLES
T	TELEPHONE CABLES

REVISIONS

(B) 3/00
Adjust Signal Heads Add Luminaire
SHA NO.: OT 1999-9
C.J.
(A) 10-23-98
ASBUILT
SHA NO.: FQ1805171
R.R.Z.

APPROVALS

ASST. CHIEF TEDD SECTION
ASST. DISTRICT ENGINEER, TRAFFIC
CHIEF, TRAFFIC ENGINEERING DESIGN DIVISION
DIRECTOR, TRAFFIC & SAFETY
ORIGINAL ON FILE

MARYLAND DOT - STATE HIGHWAY ADMINISTRATION
Office of Traffic & Safety
TRAFFIC ENGINEERING DESIGN DIVISION
MD 410 (EAST-WEST HWY) & MD 212 (RIGGS ROAD)

DRAWN BY: R.E.WATSON	COUNTY: PRINCE GEORGE'S	TS NO. 1778 B	SHEET NO. ___ OF ___
CHECK BY: H.J.K.	LOG MILE: 16.021201.26		
DATE: 5-30-80	F.A.P. NO. ~~U000-51-7-5-0123~~	T.I.M.S. NO. D 486	
SCALE: 1" = 20'	S.H.A. NO. ~~P.G. 800-501-383~~		