K&E BALTIMORE 17 0153 PHOENIX 10-75 MC 4156.
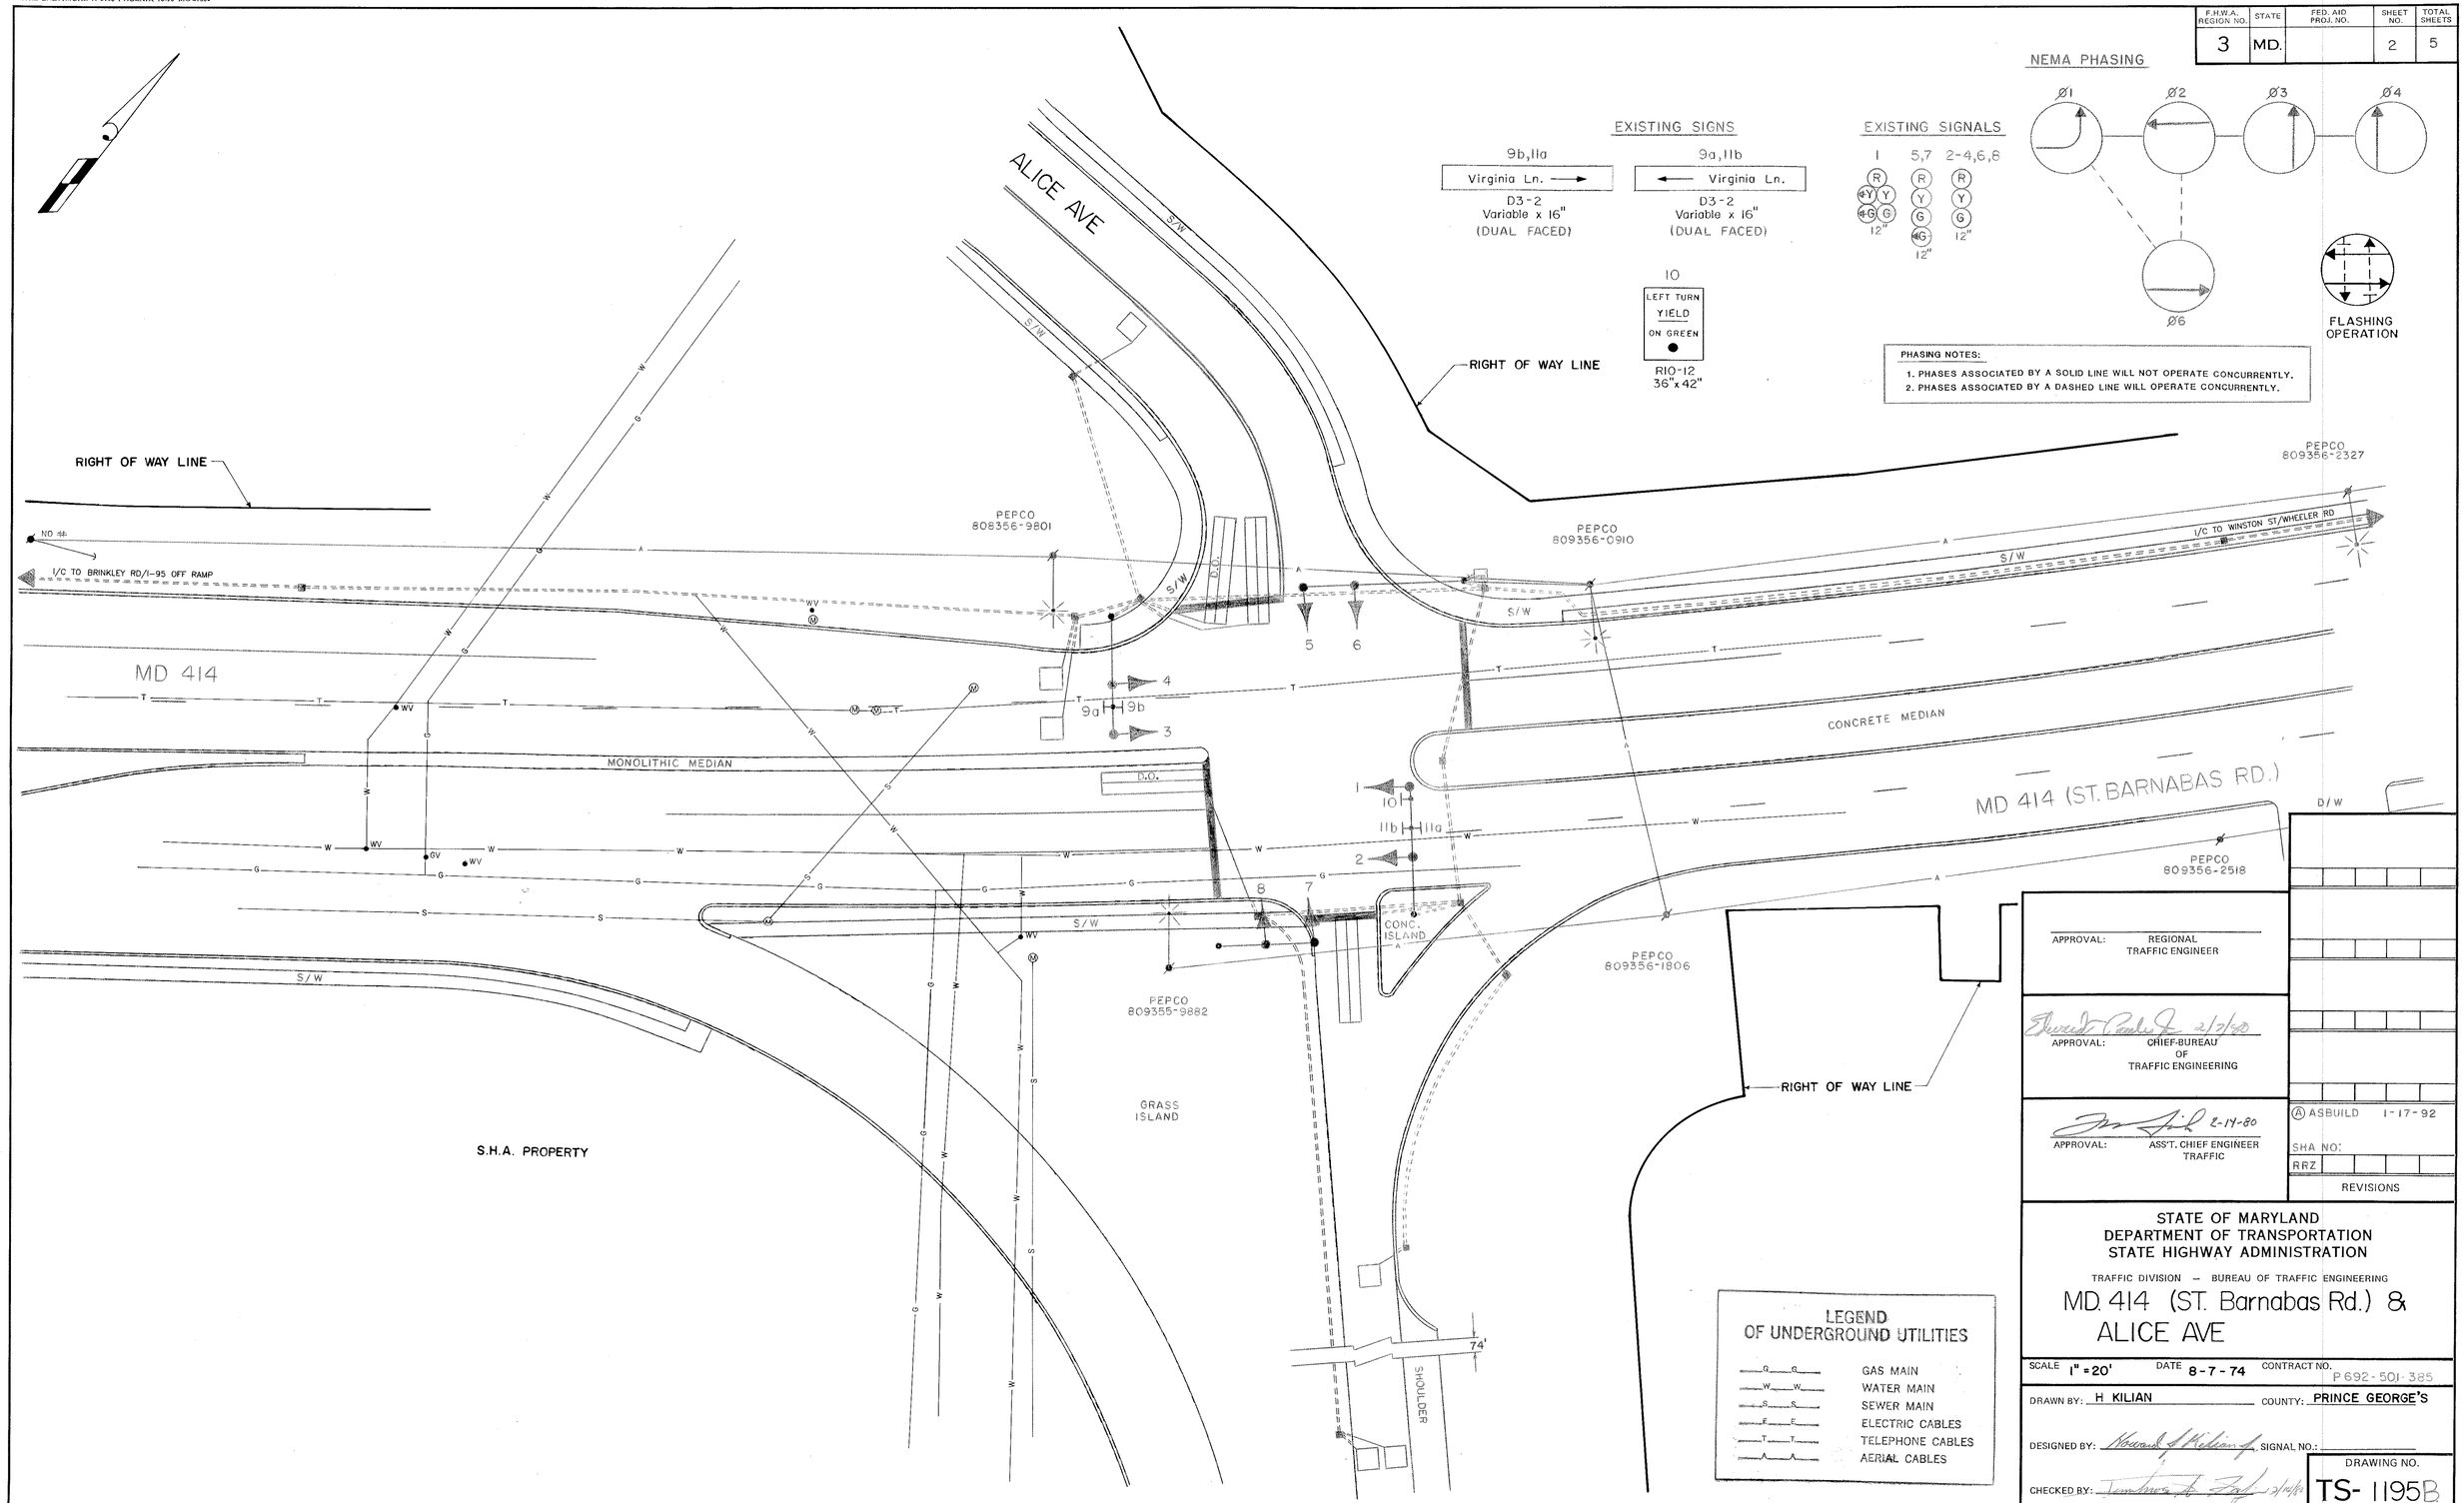
F.H.W.A. REGION NO.	STATE	FED. AID PROJ. NO.	SHEET NO.	TOTAL SHEETS
3	MD.		2	5