F H W A REGION NO.	STATE	FED. AID PROJ. NO.	SHEET NO.	TOTAL SHEETS
3	MD			

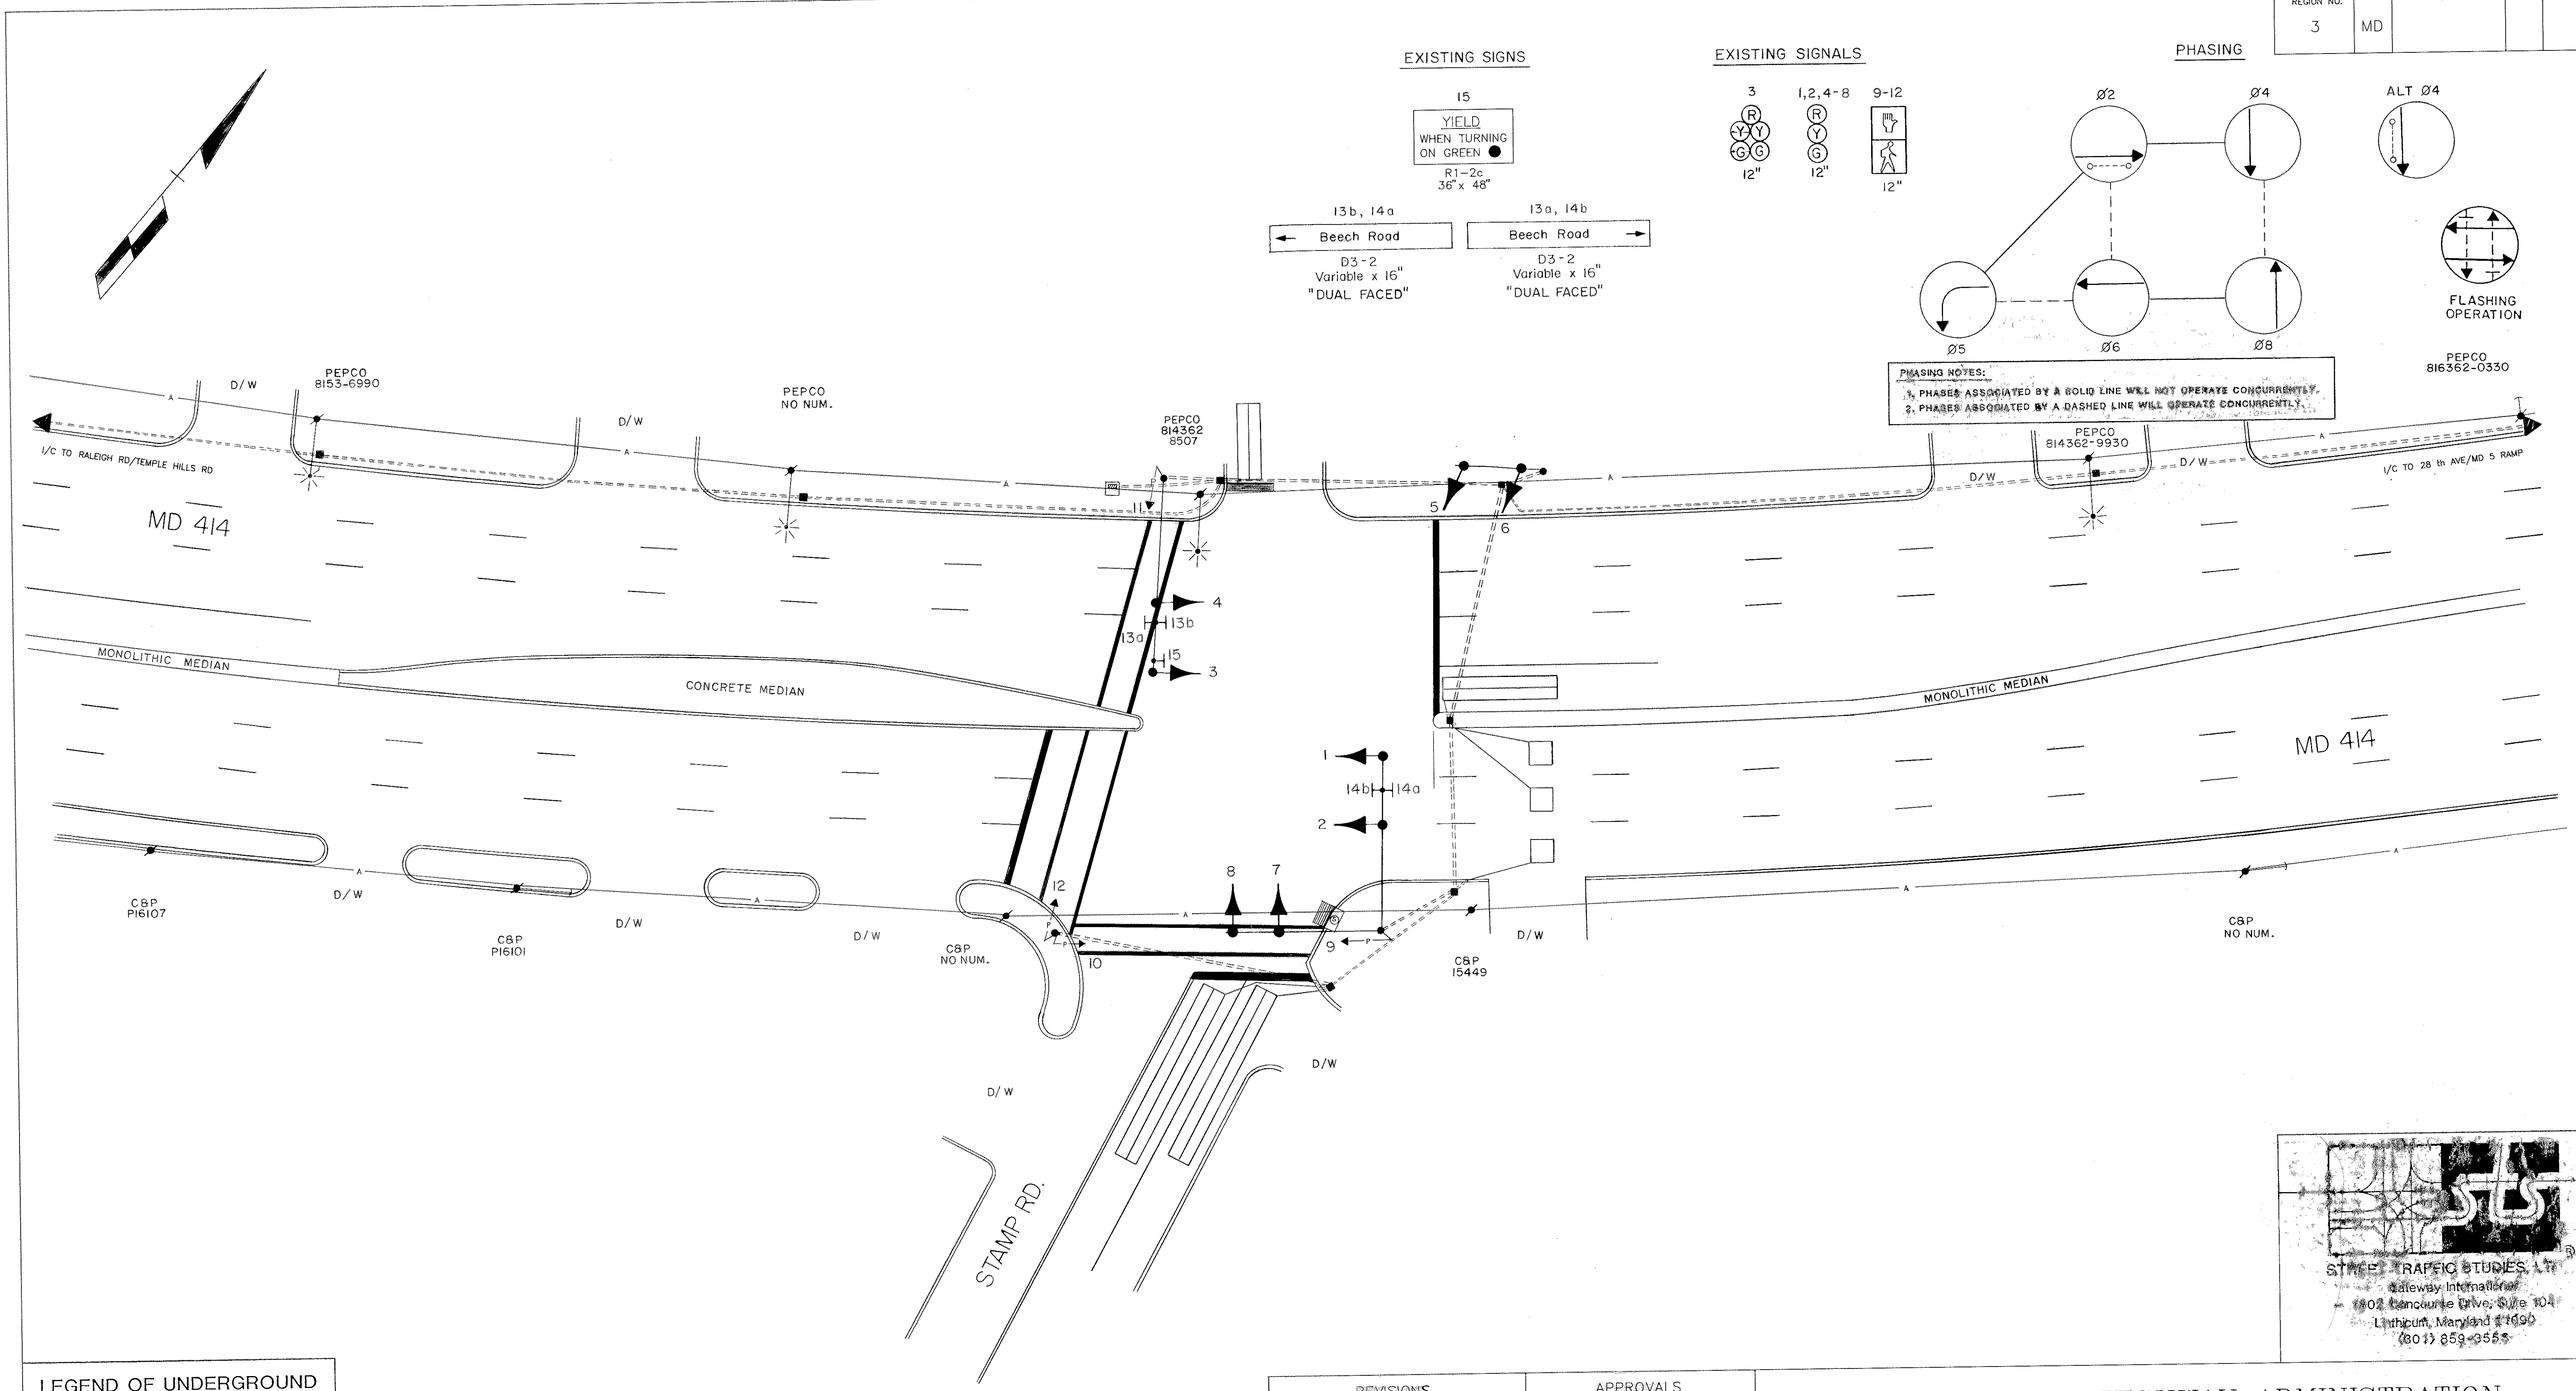

STATE TRAFFIC STUDIES, LTD.
Gateway International
7802 Concourse Drive, Suite 104
Lithicum, Maryland 21090
(301) 859-3555

LEGEND OF UNDERGROUND AND OVERHEAD UTILITIES

AERIAL CABLE —— A —— A —— A —— A
ELECTRIC —— E —— E —— E —— E
TELEPHONE —— T —— T —— T —— T
GAS —— G —— G —— G —— G
SEWER —— S —— S —— S —— S
WATER —— W —— W —— W —— W
CABLE TV —— TV —— TV —— TV —— TV

REVISIONS	APPROVALS
Ⓐ 1-17-92 ASBUILD	CHIEF, DESIGN SECTION
	ASST. DISTRICT ENGINEER, TRAFFIC
	CHIEF, TRAFFIC ENGINEERING DIVISION
	DEPUTY CHIEF ENGINEER, TRAFFIC
RRZ	

MDOT – STATE HIGHWAY ADMINISTRATION

Office of Traffic

TRAFFIC ENGINEERING DIVISION

1604140367

DRAWN BY: D.A.NIES
DES. BY: R R ZACHERL
CHK. BY:

MD 414 AND STAMP ROAD

COUNTY PRINCE GEORGES

DATE: 4-17-91
SCALE: 1"=20'
F.A.P. NO.
S.H.A. NO.

TS/STD. NO. 18 A

SHEET NO. ___ OF ___

1604140367