F.H.W.A. REGION NO.	STATE	FED AID PROJ. NO.	SHEET NO.	TOTAL SHEETS
3	MD.			

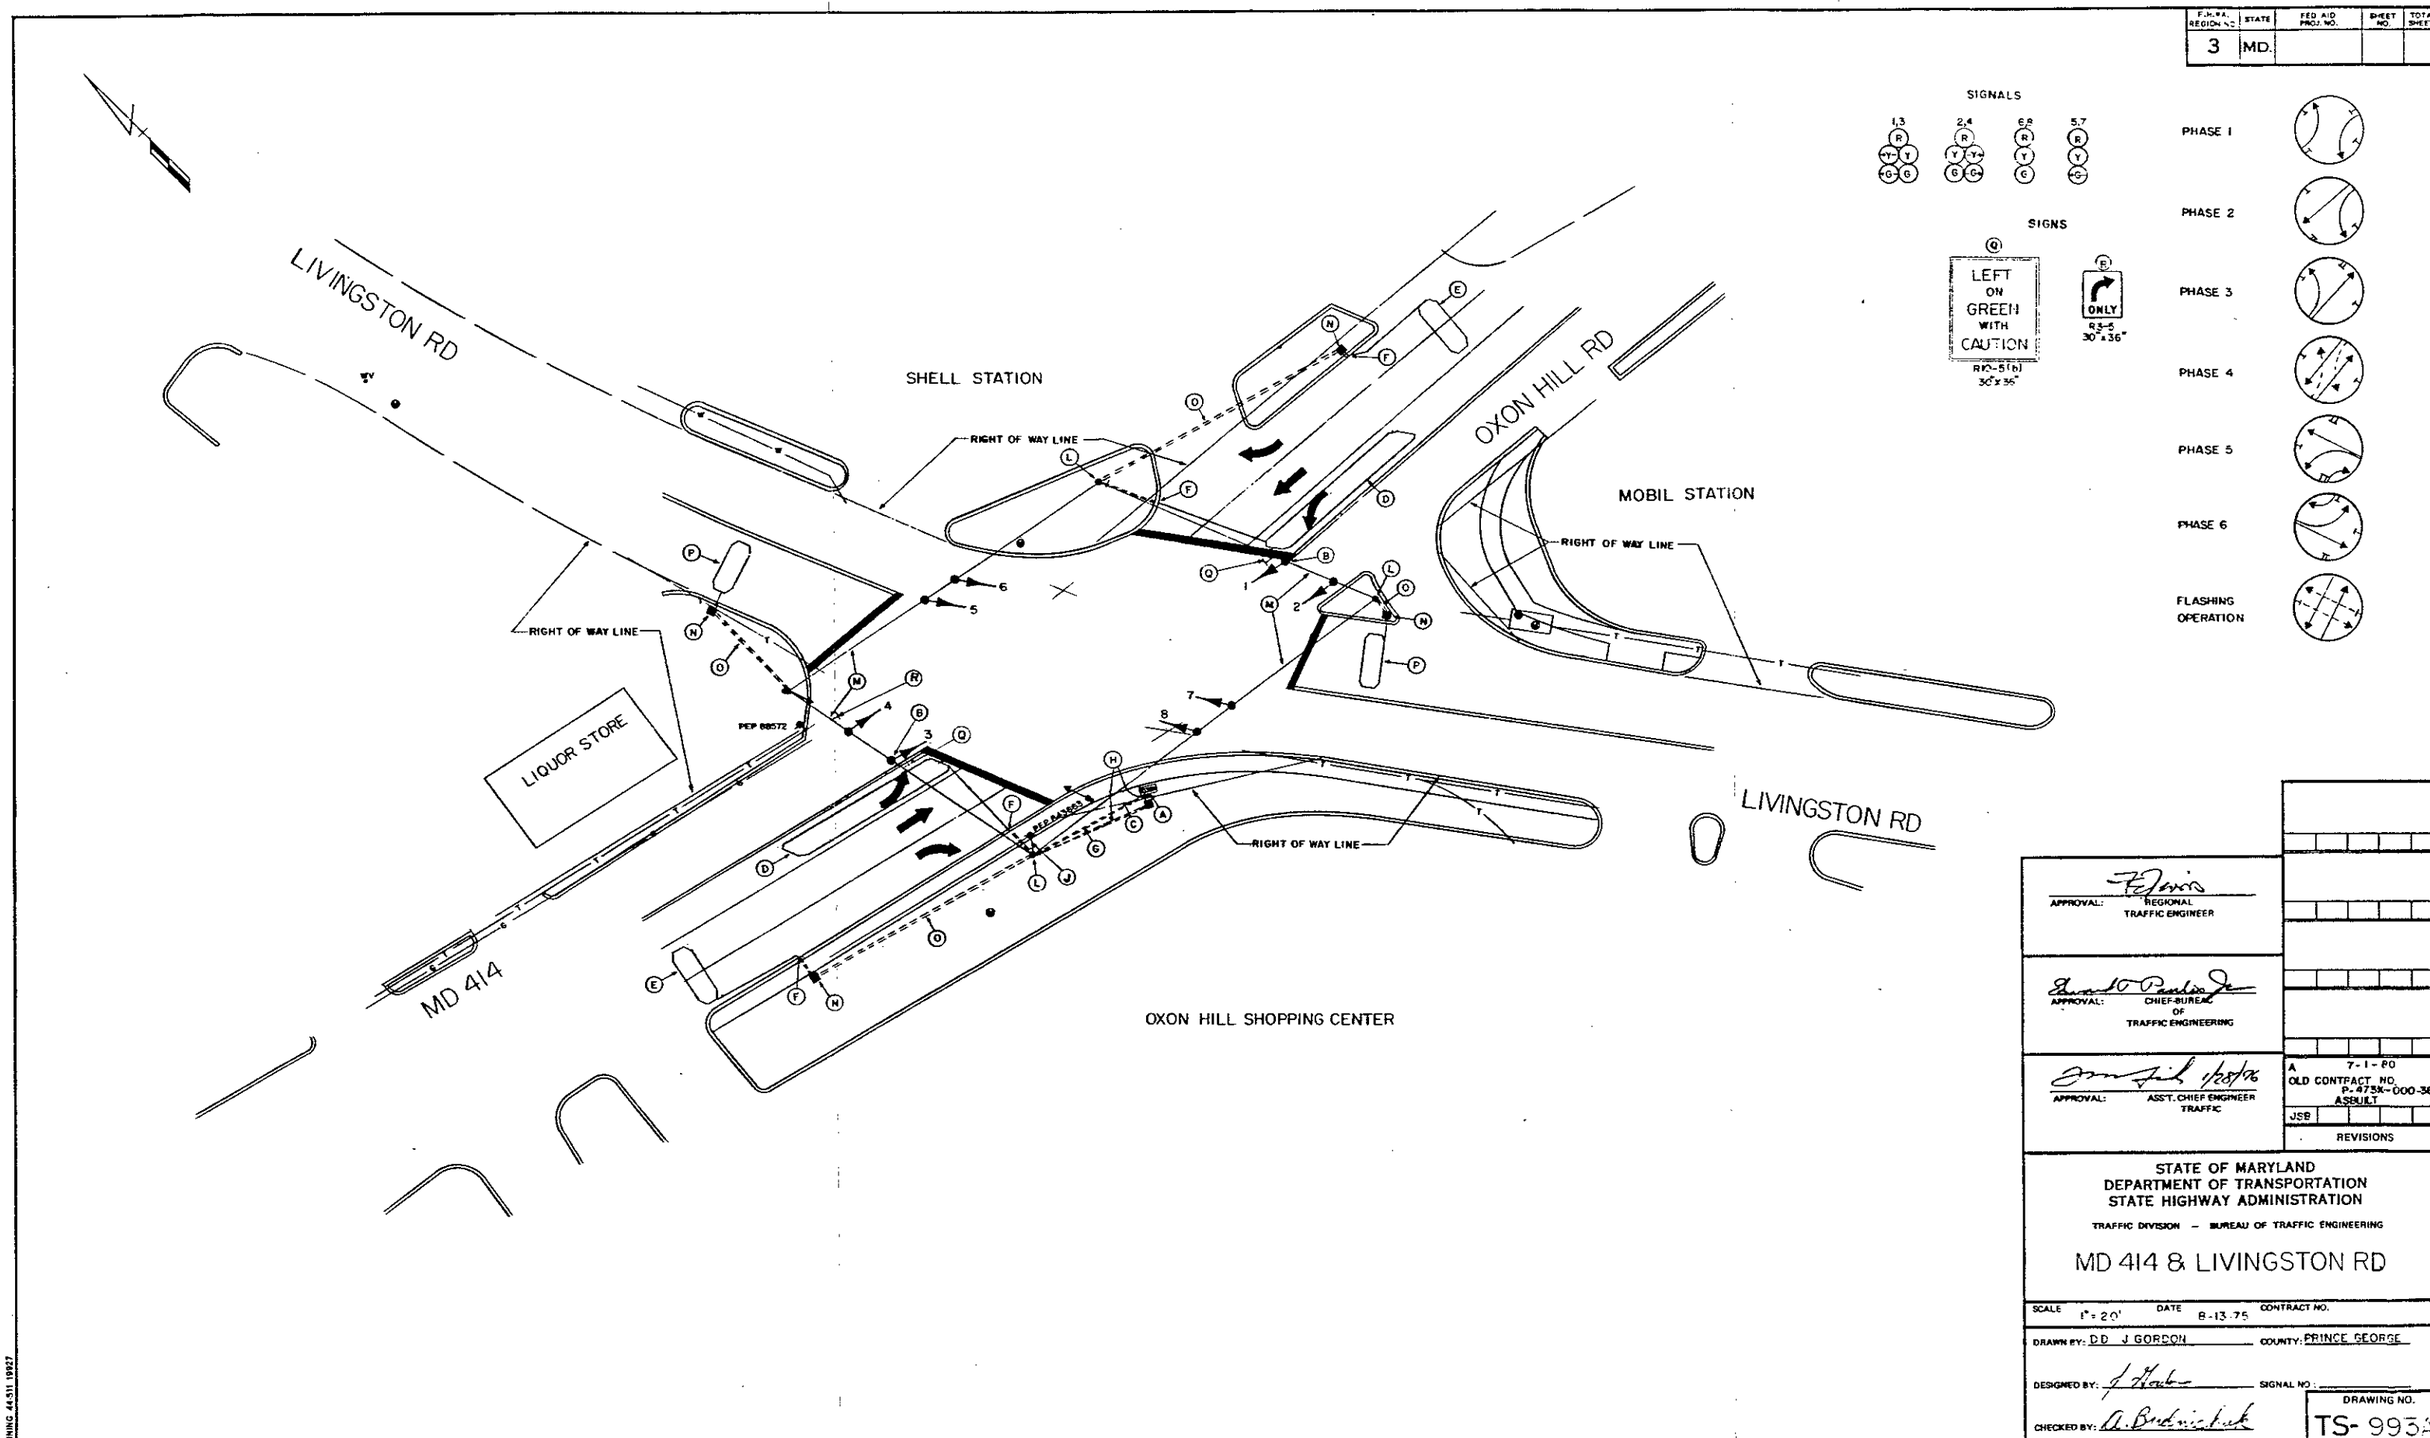

APPROVAL: REGIONAL TRAFFIC ENGINEER

APPROVAL: CHIEF-BUREAU OF TRAFFIC ENGINEERING

APPROVAL: ASS'T. CHIEF ENGINEER TRAFFIC 1/28/76

A 7-1-80
OLD CONTRACT NO. P-473X-000-385
ASBUILT
JSB
REVISIONS

STATE OF MARYLAND
DEPARTMENT OF TRANSPORTATION
STATE HIGHWAY ADMINISTRATION

TRAFFIC DIVISION – BUREAU OF TRAFFIC ENGINEERING

MD 414 & LIVINGSTON RD

SCALE 1" = 20' DATE 8-13-75 CONTRACT NO.

DRAWN BY: DD J GORDON COUNTY: PRINCE GEORGE

DESIGNED BY: SIGNAL NO.:

CHECKED BY: A. Budnichuk

DRAWING NO. TS-993A

16041400.43

BRUNING 44-511 19927