F.H.W.A. REGION NO.	STATE	FED. AID PROJ. NO.	SHEET NO.	TOTAL SHEETS
3	MD.			

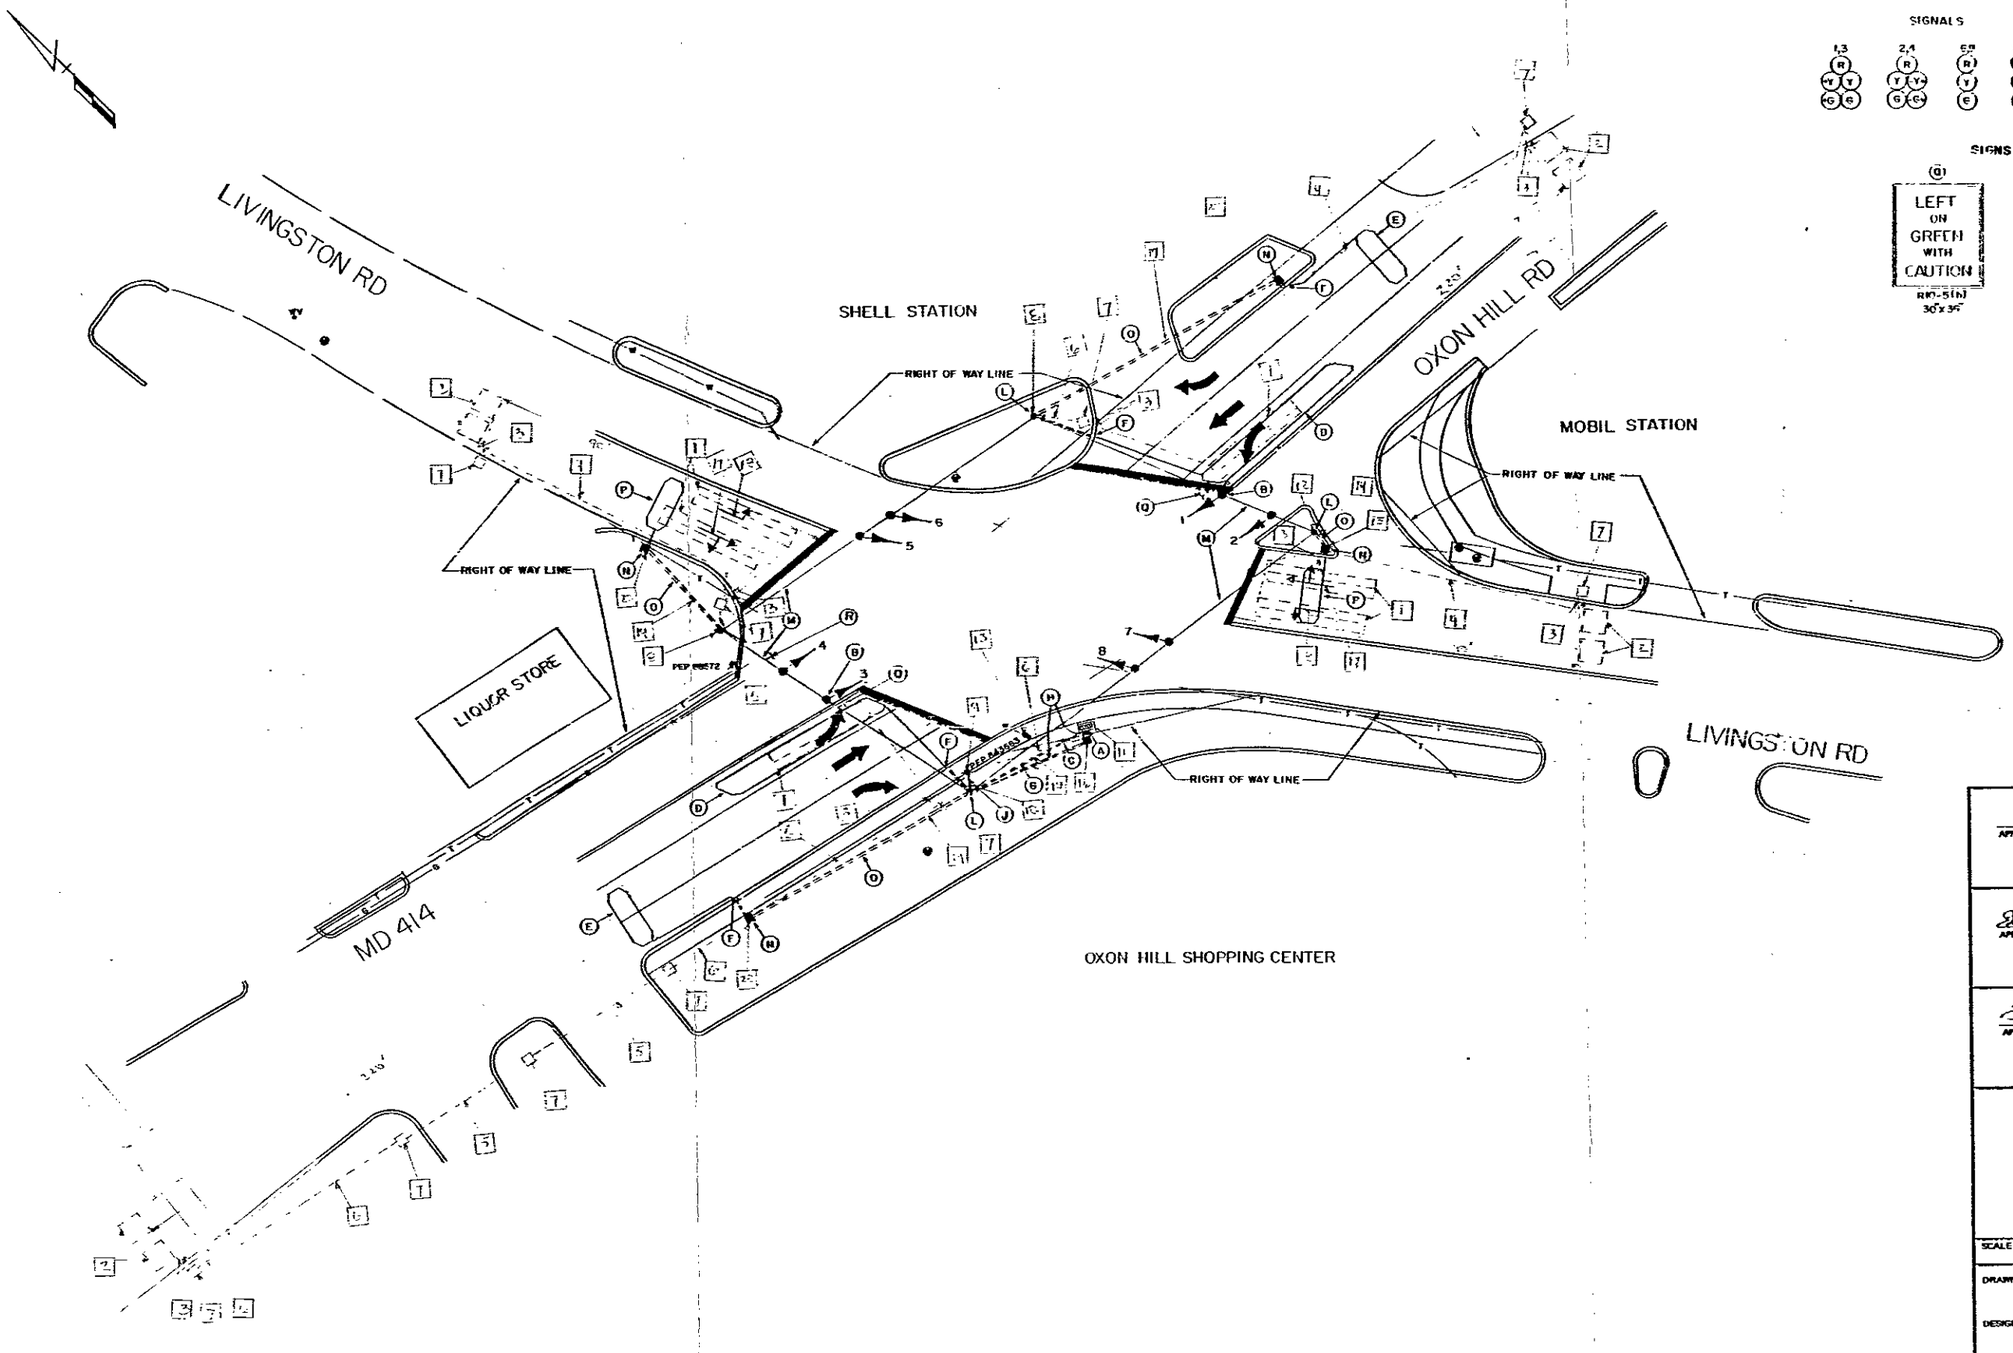

SIGNALS

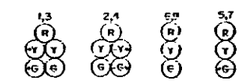

SIGNS

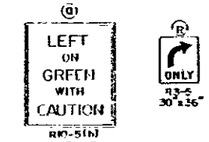

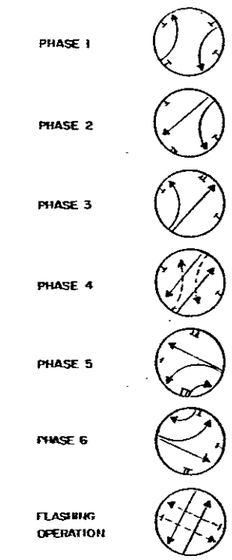

APPROVAL: REGIONAL TRAFFIC ENGINEER

APPROVAL: CHIEF BUREAU OF TRAFFIC ENGINEERING

APPROVAL: ASS'T. CHIEF ENGINEER TRAFFIC

6	REPLACE PAINTED LINE DETECTORS 7/81
A	7-1-80 OLD CONTRACT NO. P-473X-000-385 ASBUILT
JSB	

REVISIONS

STATE OF MARYLAND
DEPARTMENT OF TRANSPORTATION
STATE HIGHWAY ADMINISTRATION

TRAFFIC DIVISION — BUREAU OF TRAFFIC ENGINEERING

MD 414 & LIVINGSTON RD

SCALE 1" = 20' DATE 8-13-75 CONTRACT NO.

DRAWN BY: DD J GORDON COUNTY: PRINCE GEORGE

DESIGNED BY: SIGNAL NO.:

CHECKED BY:

DRAWING NO. TS-993A

1604/160.43

BRUNING 44-511 19927