F H W A REGION NO.	STATE	FED. AID PROJ. NO.	SHEET NO.	TOTAL SHEETS
3	MD			

EXISTING SIGNALS

1 - 7

R
Y
G
12"

EXISTING SIGNS

8

ONLY | ONLY

R3-5b(L)
36" x 60"

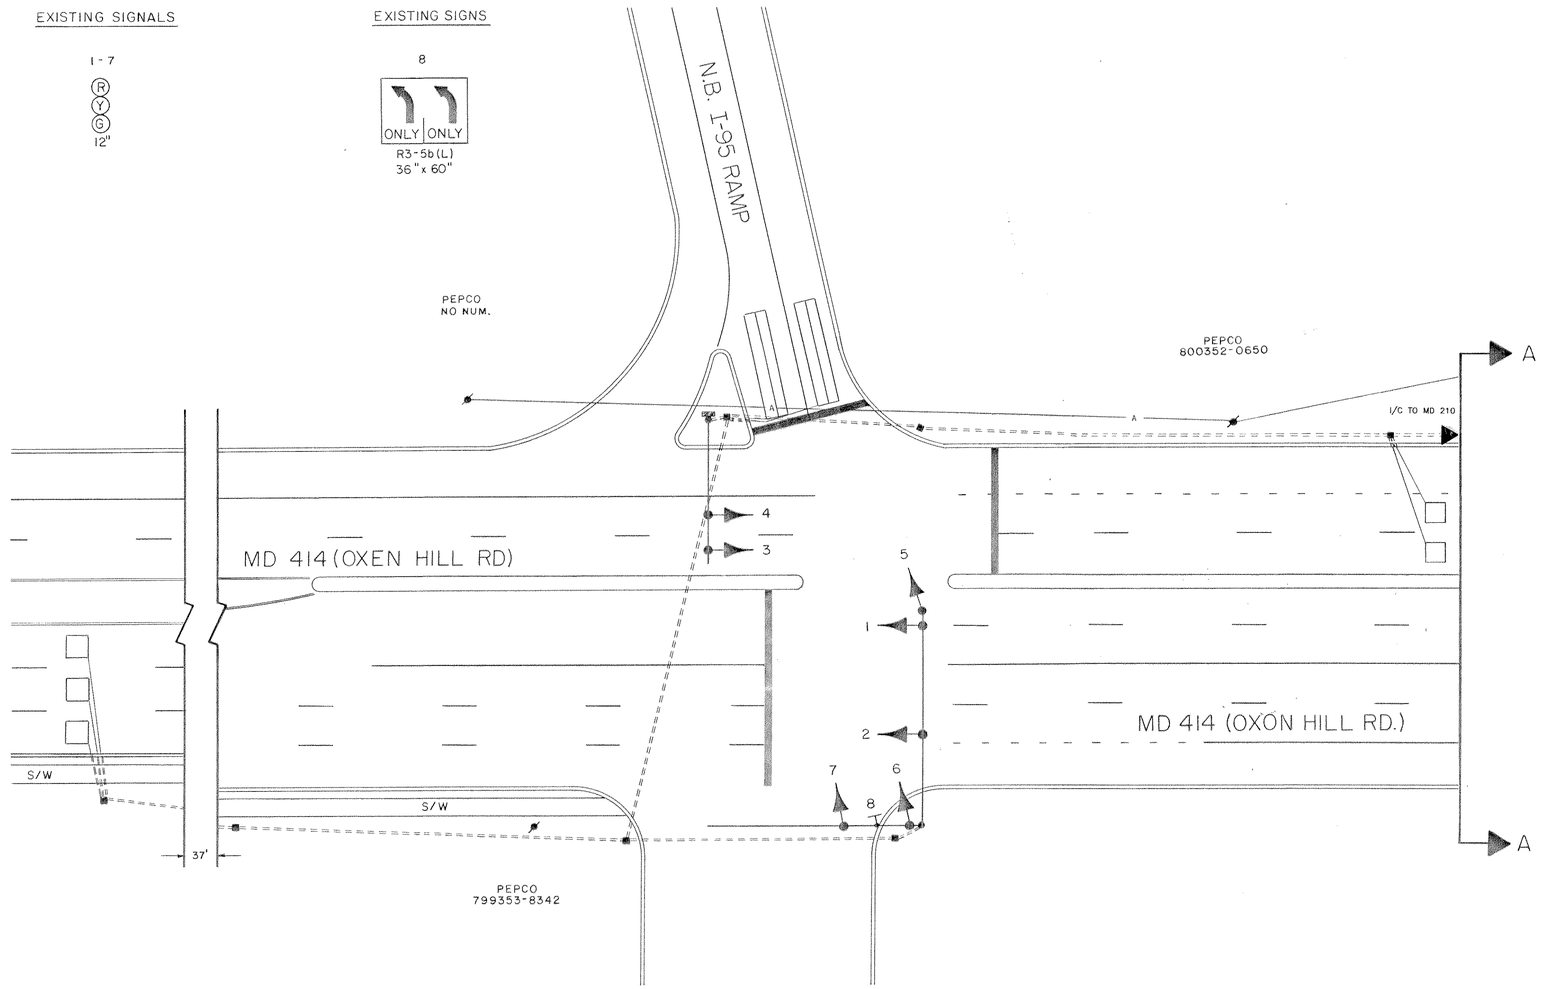

NEMA PHASING

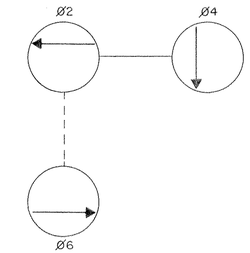

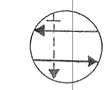

FLASHING OPERATION

PHASING NOTES:

1. PHASES ASSOCIATED BY A SOLID LINE WILL NOT OPERATE CONCURRENTLY.
2. PHASES ASSOCIATED BY A DASHED LINE WILL OPERATE CONCURRENTLY.

LEGEND OF UNDERGROUND AND OVERHEAD UTILITIES

AERIAL CABLE	A — A — A
ELECTRIC	E — E — E
TELEPHONE	T — T — T
GAS	G — G — G
SEWER	S — S — S
WATER	W — W — W
CABLE TV	TV — TV — TV

STREET TRAFFIC STUDIES, LTD.
Gateway International
1302 Concourse Drive, Suite 104
Linthicum, Maryland 21090
(301) 859-3553

REVISIONS

(B) 1-20-92 AS BUILD

RRZ

APPROVALS

CHIEF, DESIGN SECTION

ASST. DISTRICT ENGINEER, TRAFFIC

CHIEF, TRAFFIC ENGINEERING DIVISION

DEPUTY CHIEF ENGINEER, TRAFFIC

MDOT – STATE HIGHWAY ADMINISTRATION
Office of Traffic
TRAFFIC ENGINEERING DIVISION

LOG MILE 16041401.41

DRAWN BY: R.M.M.
DES. BY:
CHK. BY:

MD 414 AND NORHTBOUND RAMP FROM I-95
COUNTY PRINCE GEORGE'S

DATE: 6-6-86
SCALE: 1"=20'

F.A.P. NO.
S.H.A. NO. P-878-503-372

TS/STD. NO. TS 54B

SHEET NO. ___ OF ___