F H WA REGION NO	STATE	FED. AID PROJ. NO	SHEET NO.	TOTAL SHEETS
3	MD.			

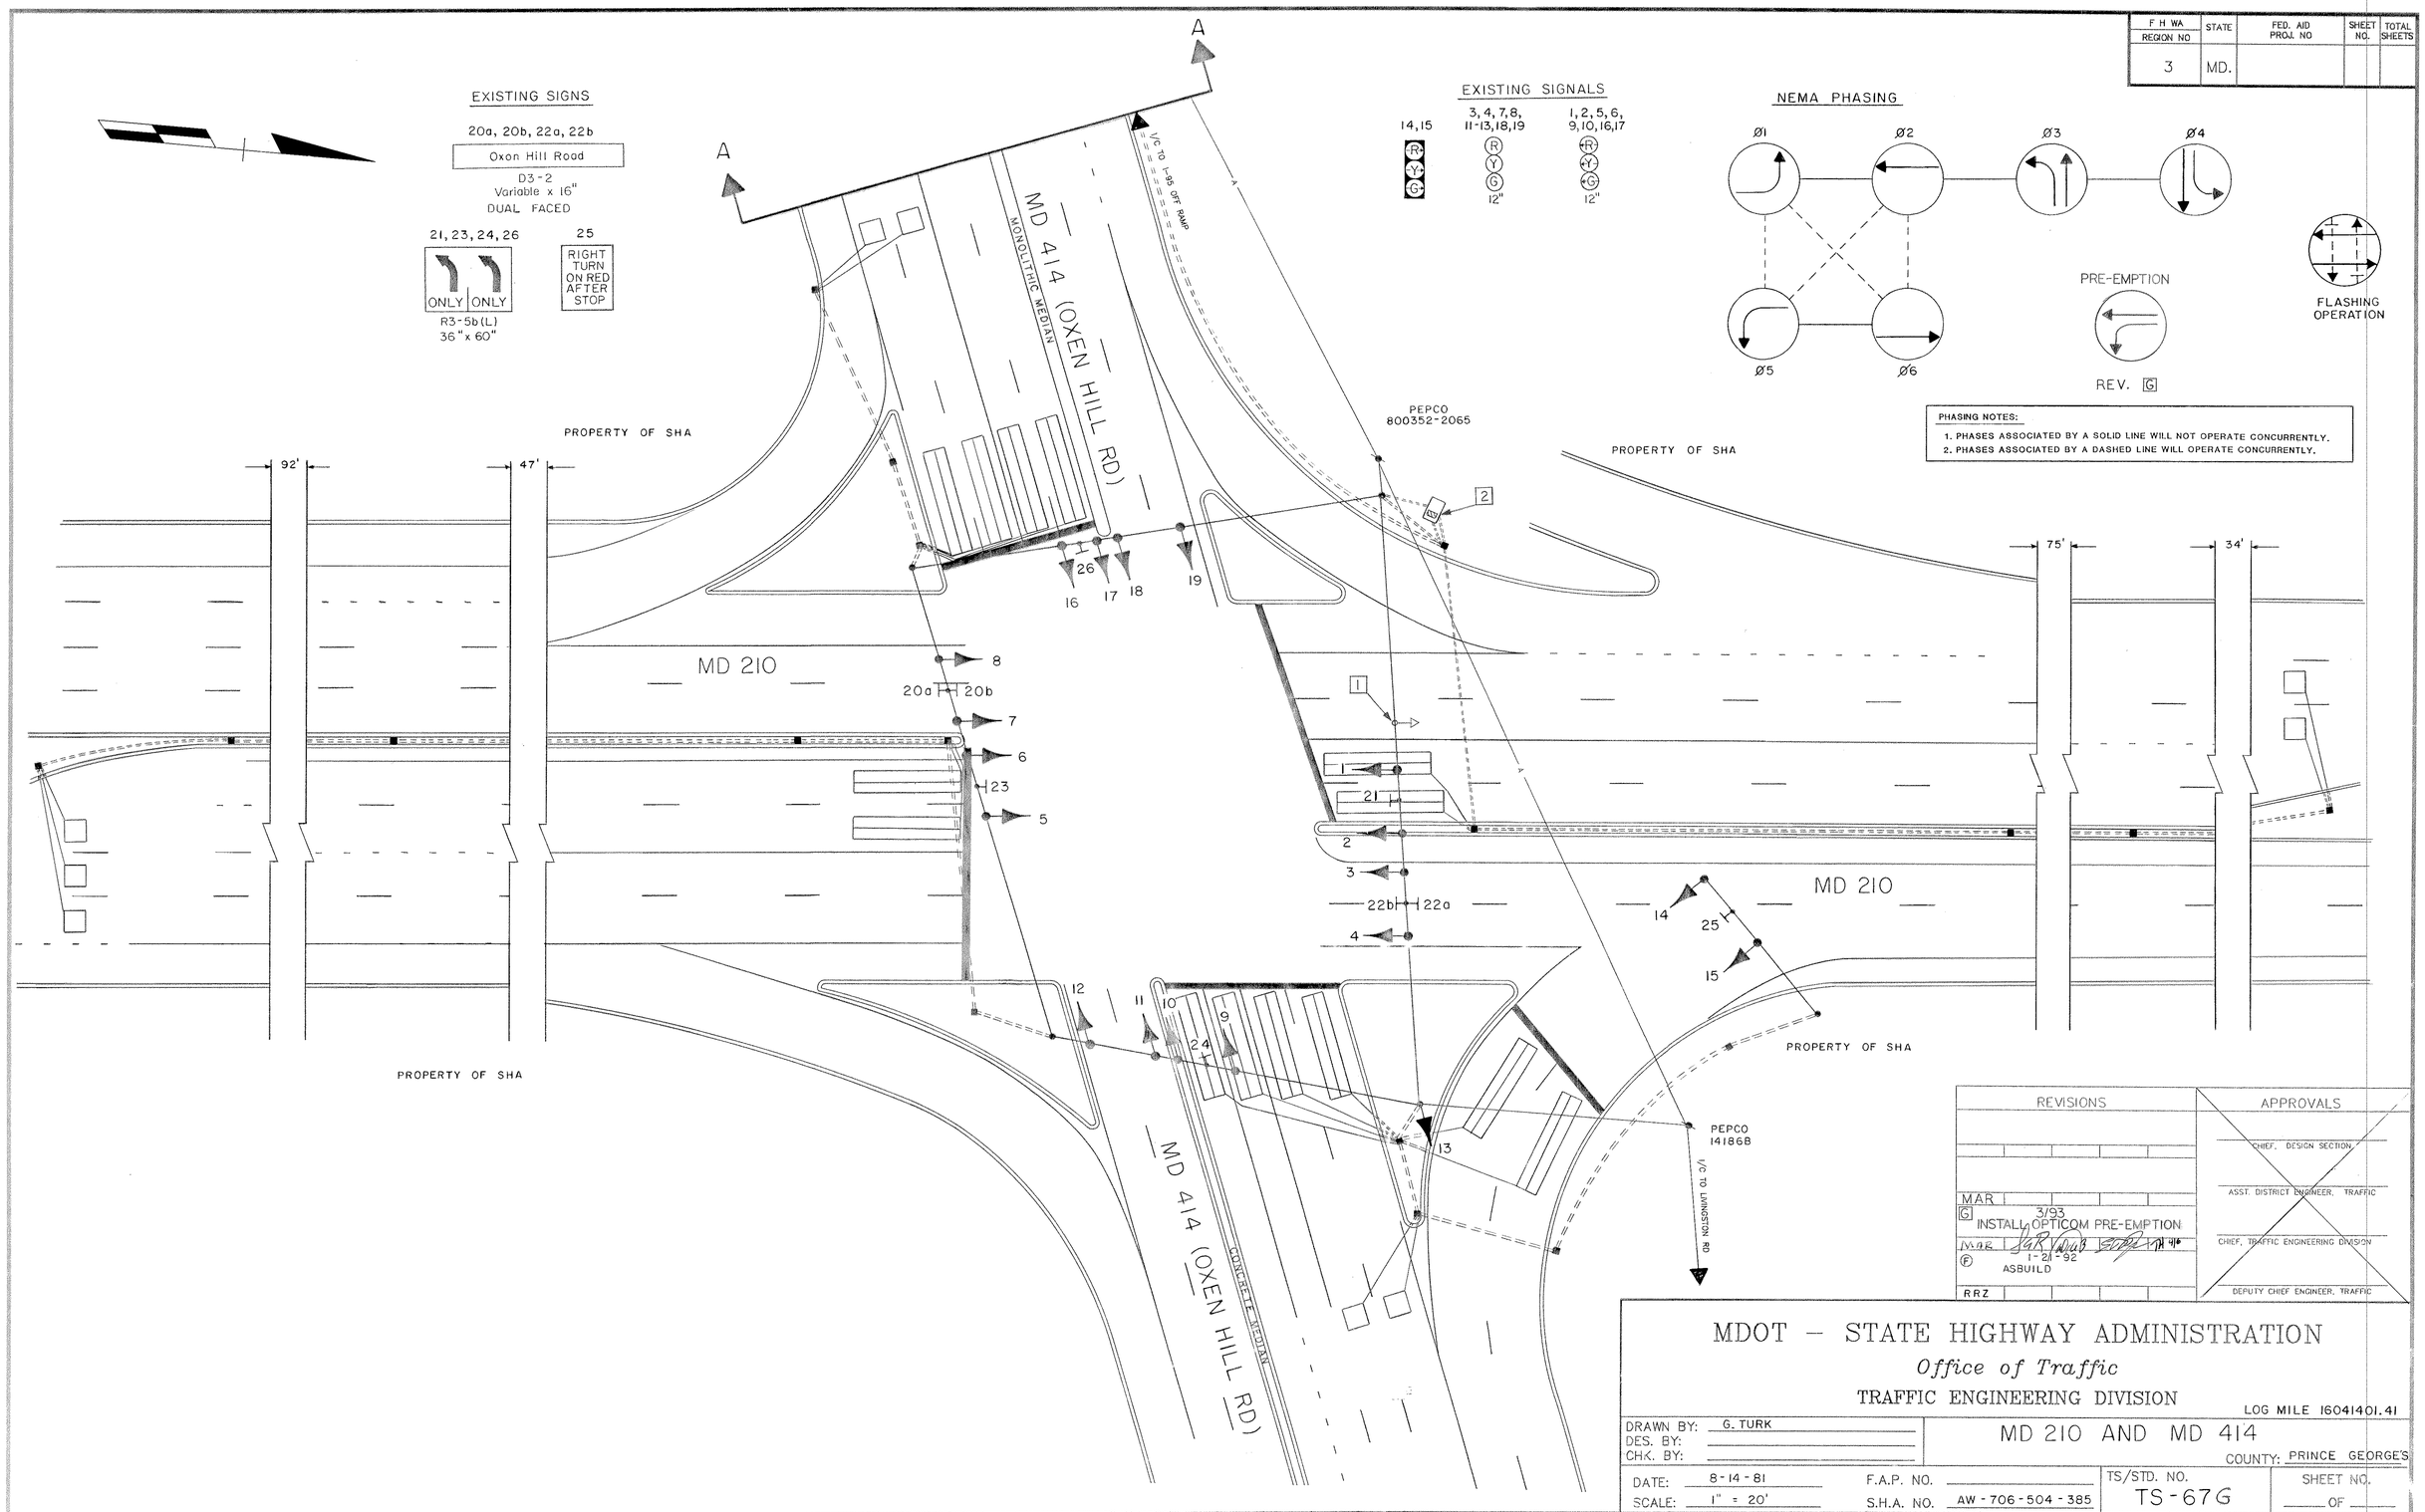

REVISIONS				APPROVALS
				CHIEF, DESIGN SECTION
				ASST. DISTRICT ENGINEER, TRAFFIC
MAR G	3/93 INSTALL OPTICOM PRE-EMPTION			CHIEF, TRAFFIC ENGINEERING DIVISION
MAR F	1-21-92 ASBUILD			DEPUTY CHIEF ENGINEER, TRAFFIC
RRZ				

MDOT – STATE HIGHWAY ADMINISTRATION

Office of Traffic

TRAFFIC ENGINEERING DIVISION

LOG MILE 16041401.41

DRAWN BY: G. TURK
DES. BY:
CHK. BY:

MD 210 AND MD 414

COUNTY: PRINCE GEORGE'S

DATE: 8-14-81
SCALE: 1" = 20'
F.A.P. NO.
S.H.A. NO. AW-706-504-385
TS/STD. NO. TS-67G
SHEET NO. ___ OF ___

16041401.41

FA 51