K&K 19 1153 6-81 MC 2647♦

F.H.W.A. REGION NO.	STATE	FED. AID PROJ. NO.	SHEET NO.	TOTAL SHEETS
3	MD.		2	5

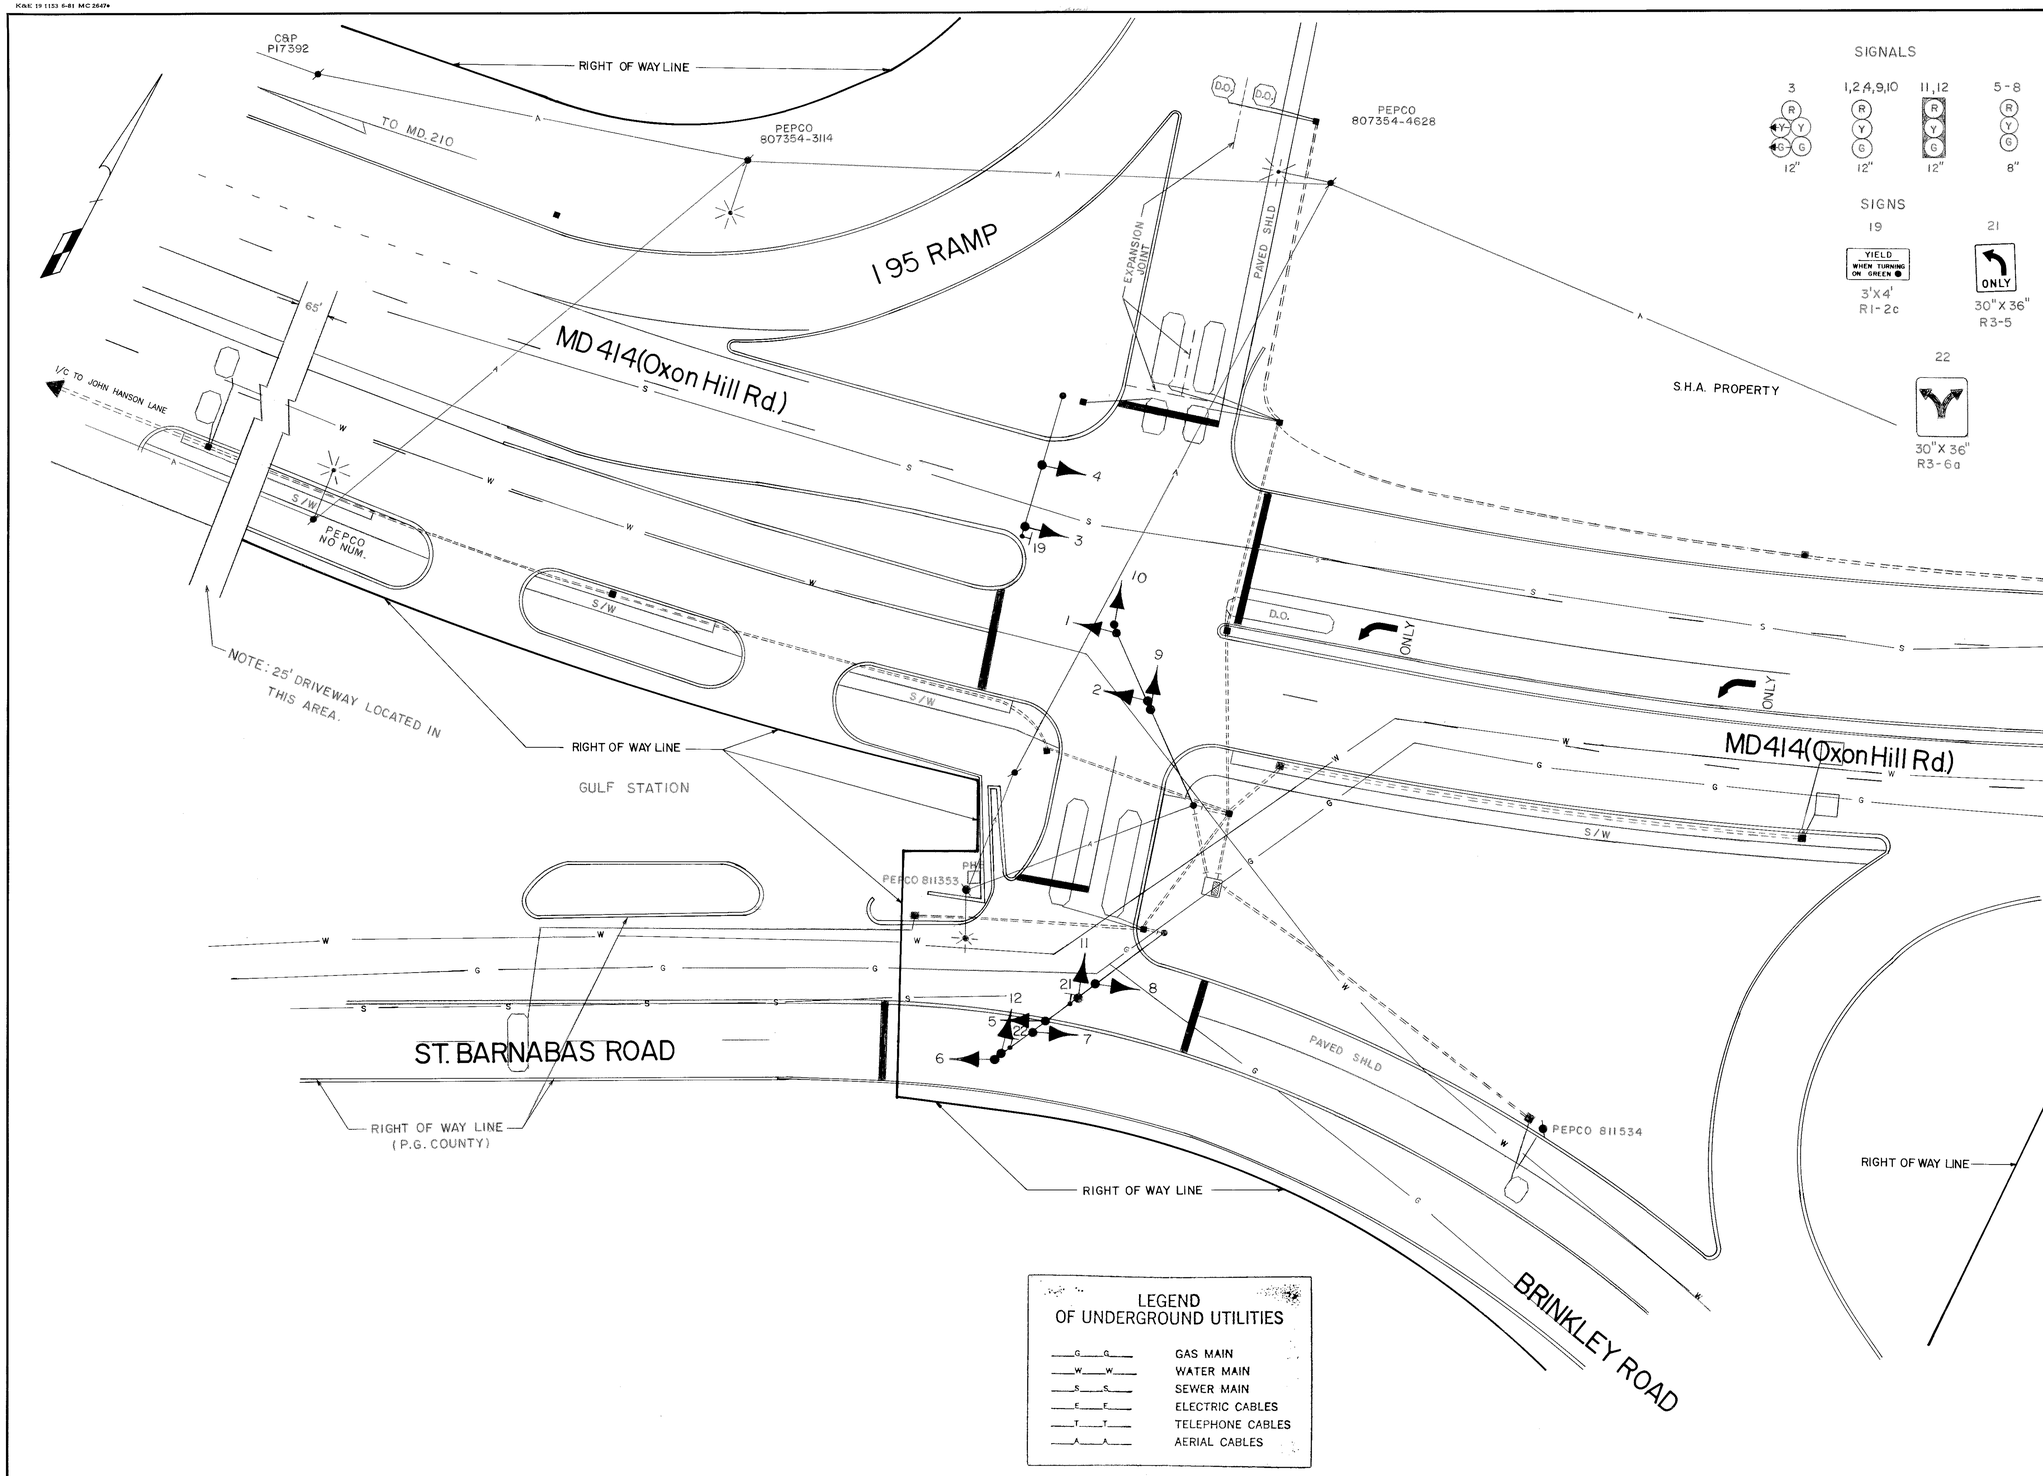

SIGNALS

SIGNS

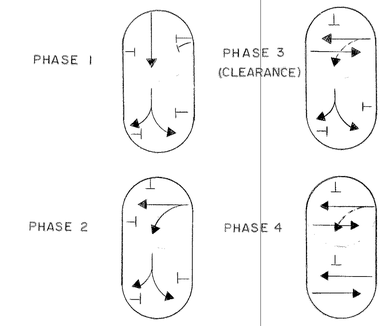

LEGEND OF UNDERGROUND UTILITIES

G G	GAS MAIN
W W	WATER MAIN
S S	SEWER MAIN
E E	ELECTRIC CABLES
T T	TELEPHONE CABLES
A A	AERIAL CABLES

APPROVAL: CHIEF SIGNAL DESIGN SECTION — 10/20/81

APPROVAL: REGIONAL TRAFFIC ENGINEER — 10/23/81

APPROVAL: CHIEF-BUREAU OF TRAFFIC ENGINEERING — 10/21/81

APPROVAL: ASS'T. CHIEF ENGINEER TRAFFIC — 10/10/81

B	1-17-92 ASBUILD
RRZ	
A	REDRAWN
R.E.W.	

REVISIONS

STATE OF MARYLAND
DEPARTMENT OF TRANSPORTATION
STATE HIGHWAY ADMINISTRATION

TRAFFIC DIVISION — BUREAU OF TRAFFIC ENGINEERING

MD. 414 (OXON HILL RD.) BRINKLEY ROAD - I 95 RAMP

SCALE	DATE	CONTRACT NO.
1"=20'	OCT. 8, 1981	P-723-501-385

DRAWN BY: R.E. WATSON — COUNTY: PRINCE GEORGE'S

DESIGNED BY: Dennis J. Abele Jr. 10-20-81 — SIGNAL NO.:

CHECKED BY:

DRAWING NO. TS-921B