F.H.WA. REGION NO.	STATE	FED. AID PROJ. NO.	SHEET NO.	TOTAL SHEETS
3	MD.			

SCHOOL WARNING SIGN INSTALLATION

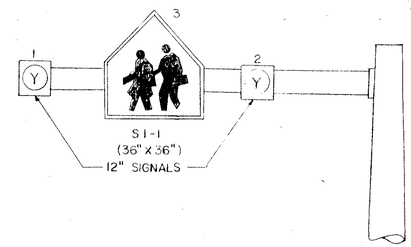

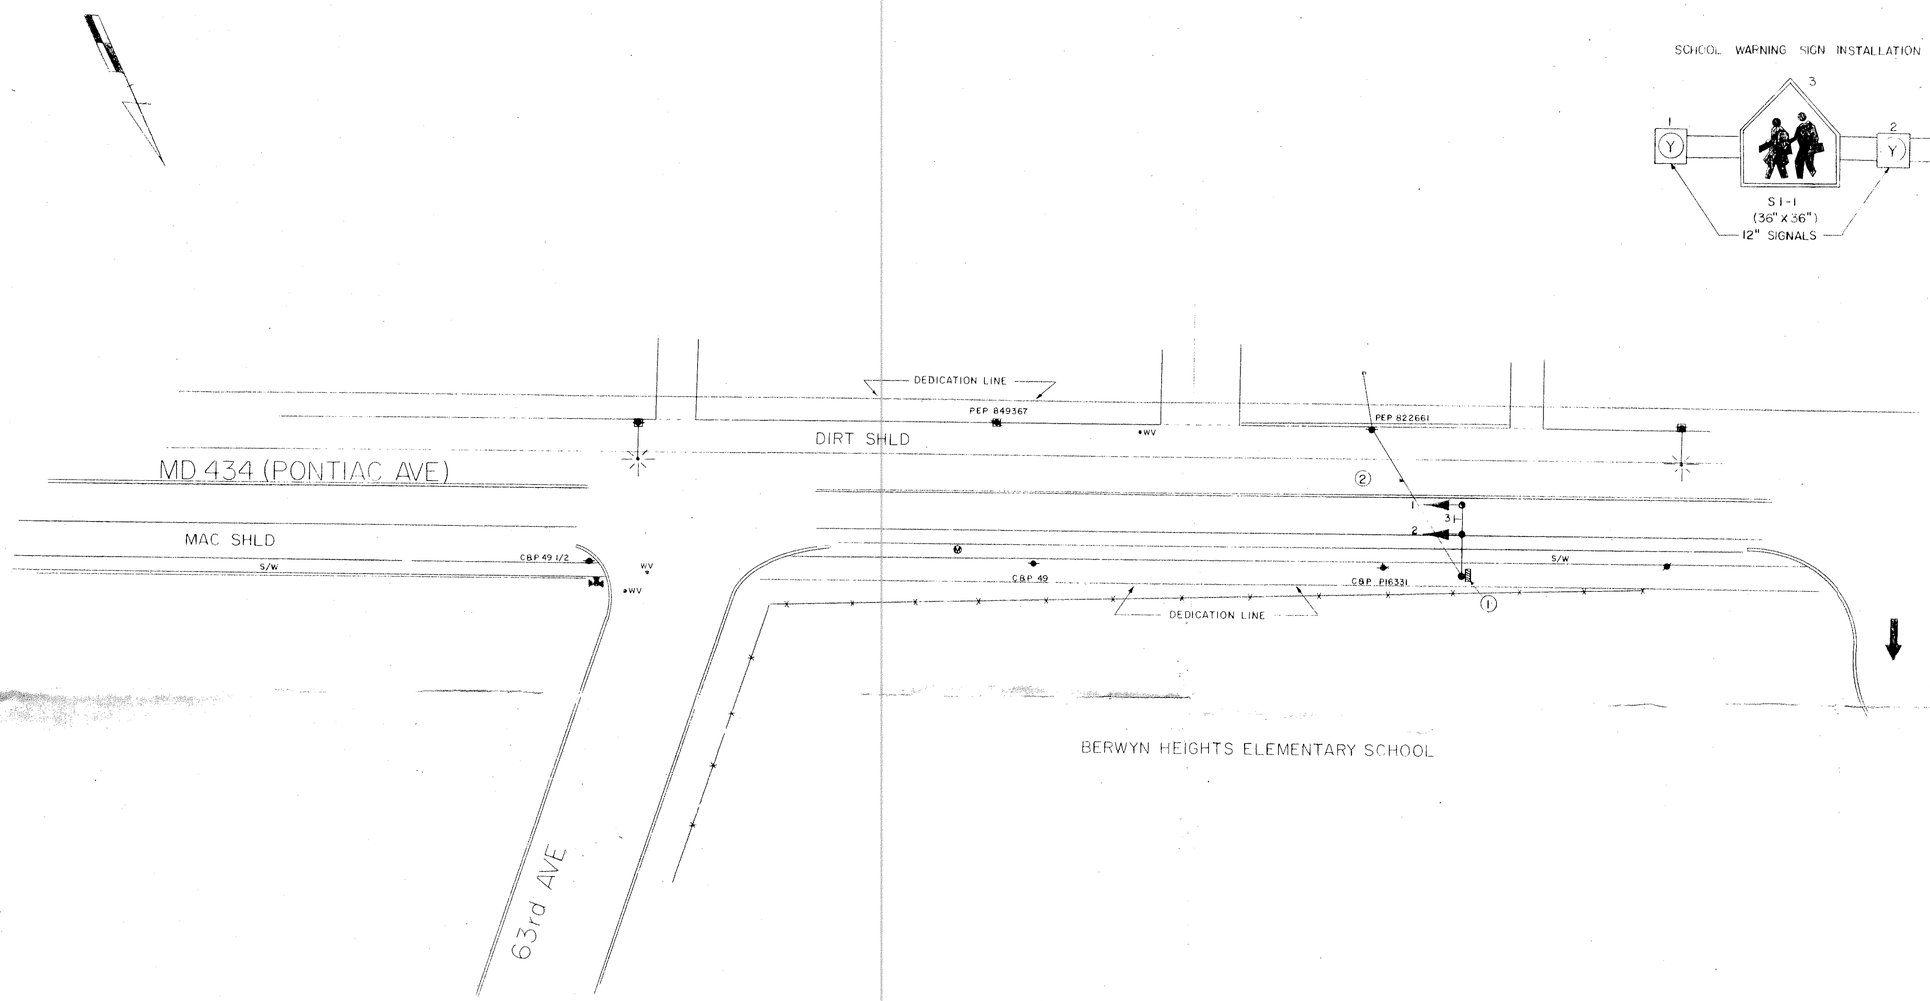

APPROVAL: REGIONAL TRAFFIC ENGINEER

APPROVAL: CHIEF BUREAU OF TRAFFIC ENGINEERING 9/12/75

APPROVAL: ASS'T. CHIEF ENGINEER TRAFFIC 9/12/75

E 7-8-80 ASBUILT

JSB

A 1-16-79 ASBUILT P466X-000-385

MM

REVISIONS

STATE OF MARYLAND
DEPARTMENT OF TRANSPORTATION
STATE HIGHWAY ADMINISTRATION

TRAFFIC DIVISION – BUREAU OF TRAFFIC ENGINEERING

MD 434 (PONTIAC AVE) & 63rd AVE

SCALE 1" = 20' DATE 3-18-75 CONTRACT NO.

DRAWN BY: J GORDON COUNTY: PRINCE GEORGES

DESIGNED BY: J Gordon SIGNAL NO.: 16363

CHECKED BY:

DRAWING NO. TS-1296A

16043400.85

BRUNING 44511 19927