F H WA REGION NO	STATE	FED. AID PROJ. NO	SHEET NO.	TOTAL SHEETS
3	MD.			

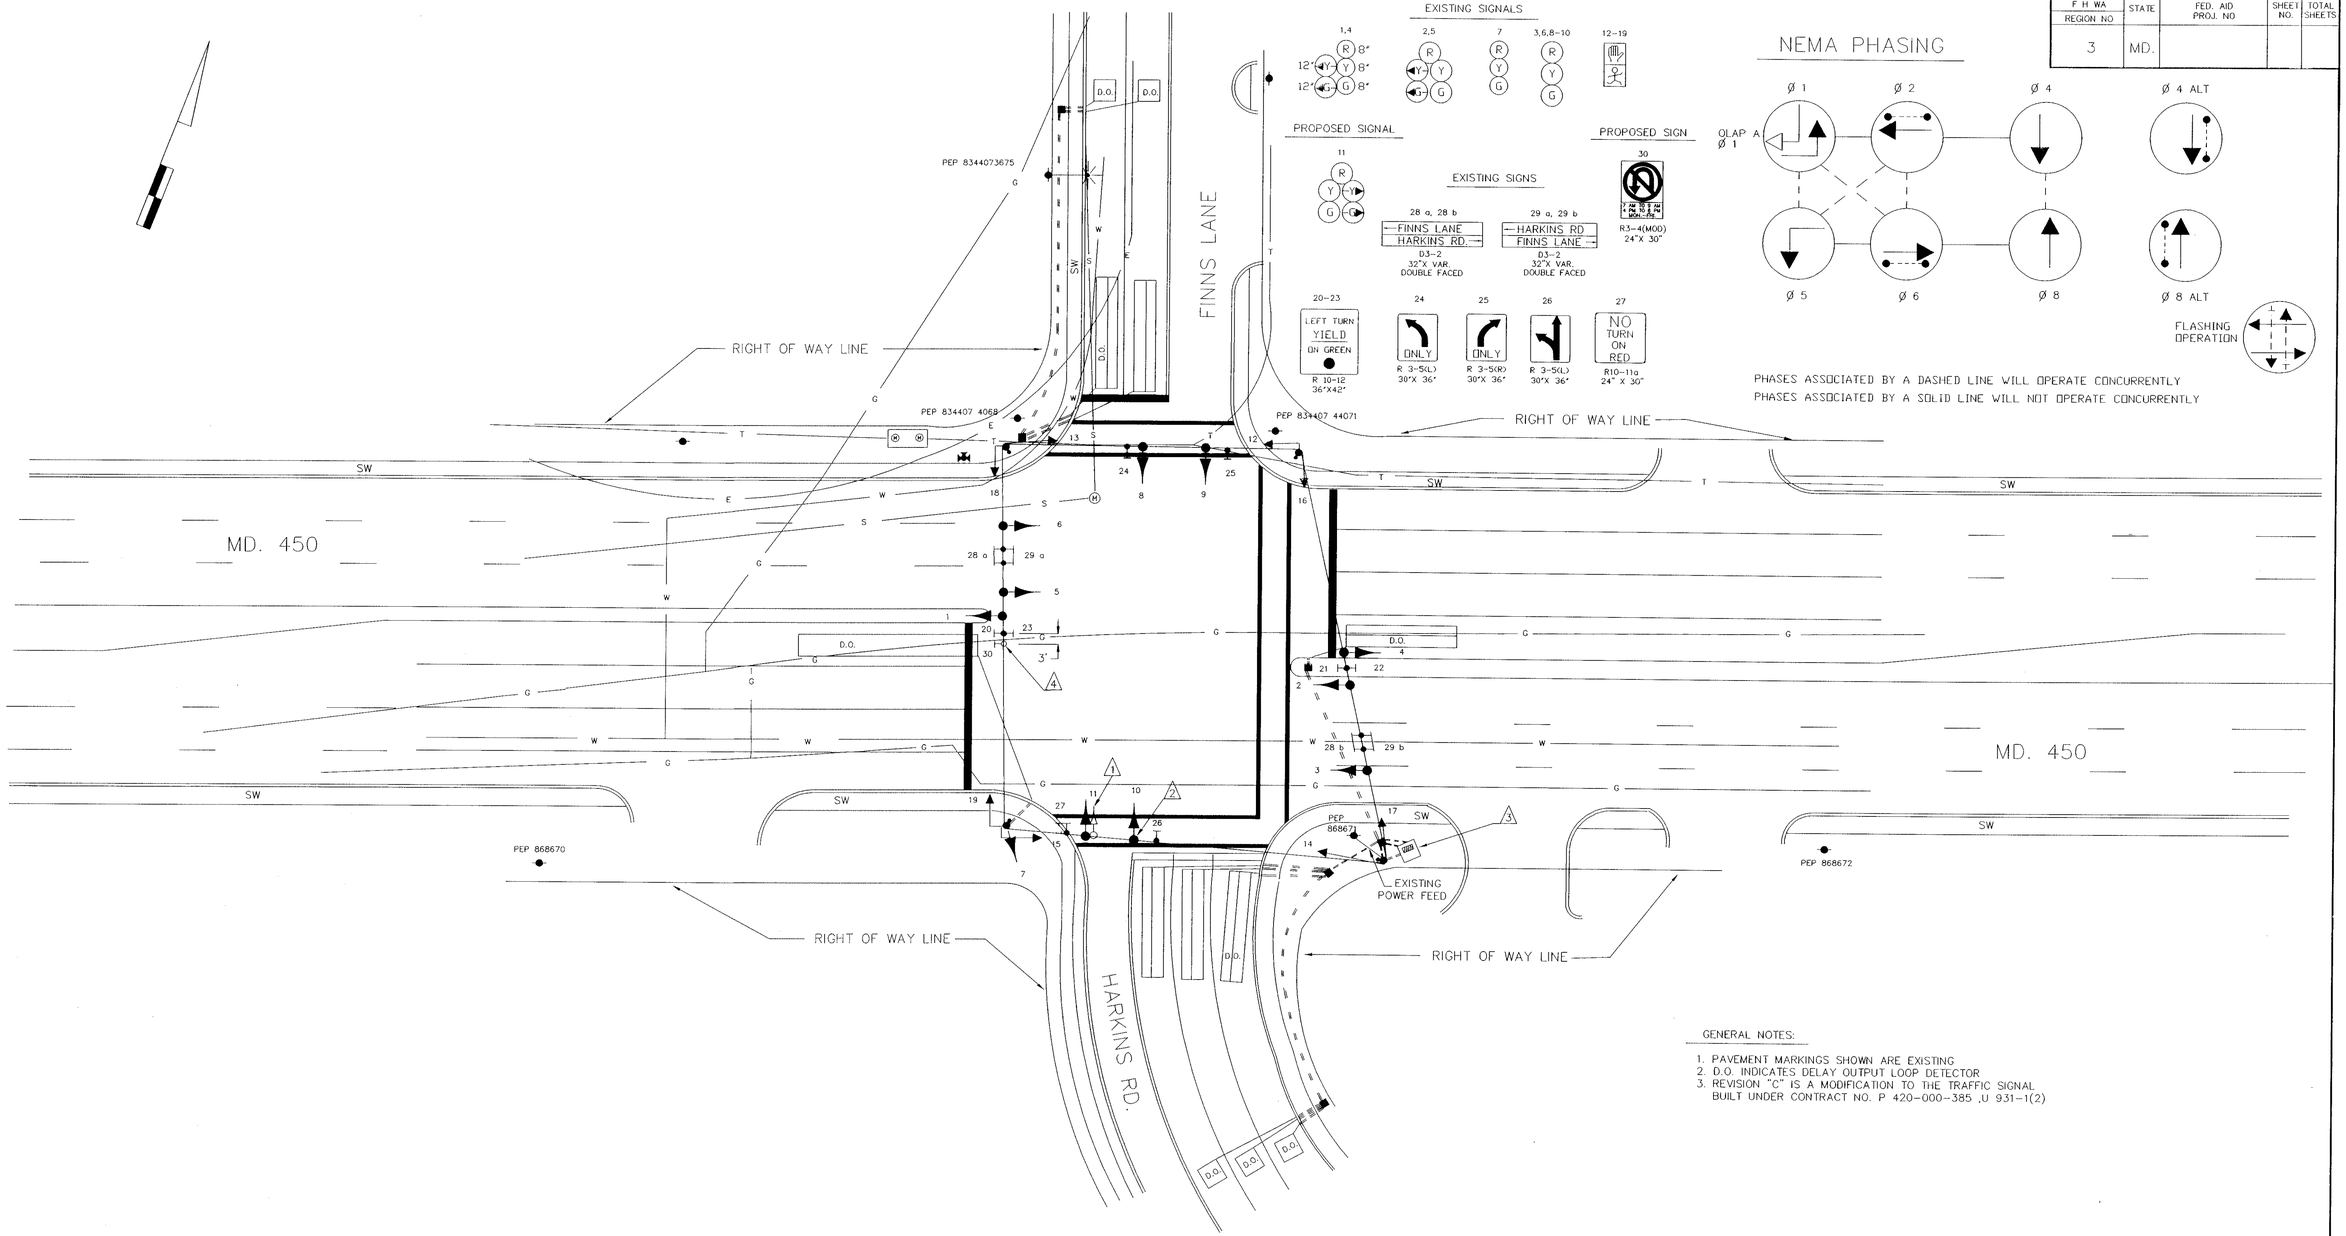

GENERAL NOTES:

1. PAVEMENT MARKINGS SHOWN ARE EXISTING
2. D.O. INDICATES DELAY OUTPUT LOOP DETECTOR
3. REVISION "C" IS A MODIFICATION TO THE TRAFFIC SIGNAL BUILT UNDER CONTRACT NO. P 420-000-385 ,U 931-1(2)

LEGEND OF UNDERGROUND AND OVERHEAD UTILITIES

AERIAL CABLE	A	A	A	A
ELECTRIC	E	E	E	E
TELEPHONE	T	T	T	T
GAS	G	G	G	G
SEWER	S	S	S	S
WATER	W	W	W	W
CABLE TV	TV	TV	TV	TV

REVISIONS	APPROVALS
B 8-30-86 REDRAWN AND REVISED FOR NEW GEOMETRICS SHA NO. BW-241-312	ORIGINAL ON FILE
C 4/92 INSTALL RIGHT TURN OVERLAP AND 5 SEC. FOR S/B FINNS LA.	CHIEF, SIGNAL DESIGN SECTION
MAR	ASST. DISTRICT ENGINEER, TRAFFIC
	CHIEF, TRAFFIC ENGINEERING DESIGN DIVISION
	DEPUTY CHIEF ENGINEER, OFFICE OF TRAFFIC & SAFTEY

MDOT – STATE HIGHWAY ADMINISTRATION

OFFICE OF TRAFFIC & SAFETY

TRAFFIC ENGINEERING DESIGN DIVISION

DRAWN BY: RICHARDSON

DES. BY:

CHK. BY:

MD. 450 @ FINNS LANE / HARKINS ROAD

SIGNAL # 16045003.87

COUNTY: PRINCE GEORGE'S

DATE:

SCALE: 1" = 20'

F.A.P. NO. U 931-1(2)

S.H.A. NO. P 420-000-385

TS/STD. NO. TS-1067 C

SHEET NO. ___ OF ___

F# 52

16045003.87