F.H.WA. REGION NO.	STATE	FED. AID PROJ. NO.	SHEET NO.	TOTAL SHEETS
3	MD.		2	8

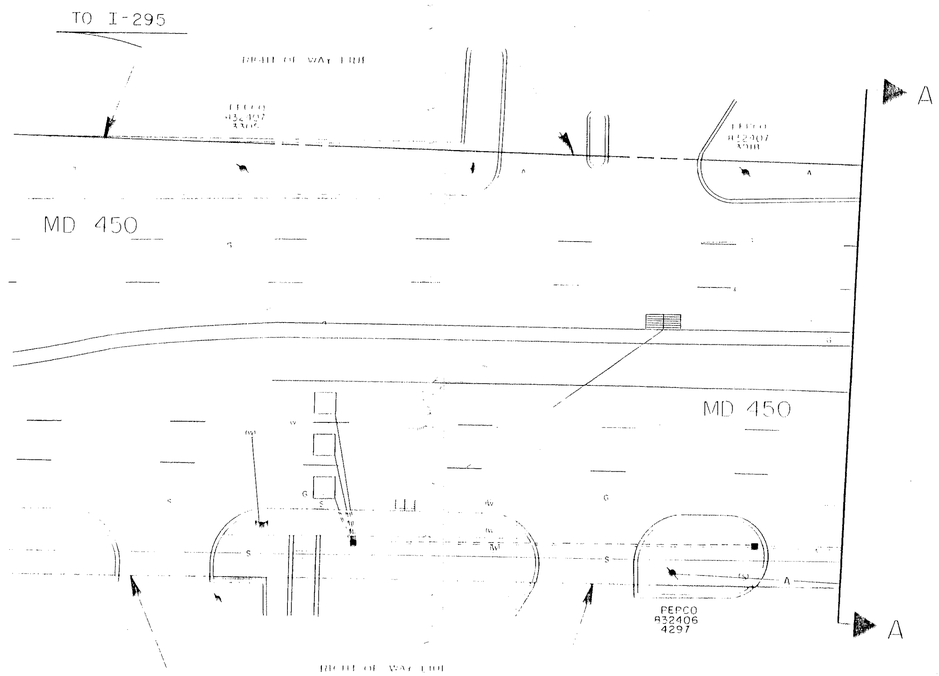

LEGEND OF UNDERGROUND AND OVERHEAD UTILITIES

AERIAL CABLE
ELECTRIC
TELEPHONE
GAS
SEWER
WATER
CABLE TV

STREET TRAFFIC STUDIES, LTD.
Gateway International
1702 Concourse Drive, Suite 104
Lighting, Maryland 21090
(301) 850-1353

REVISION "C"

REVISIONS

(C) 10-5-89 MODIFY SIGNAL DUE TO THE ADDITION OF NORTH LEG OF MD 410
SHA NO. BW-424-802-312
RRZ

(B) 10-4-89 MODIFICATION TO DESIGN FOR TEMPORARY INSTALLATION
SHA NO.
RRZ

APPROVALS

CHIEF, SIGNAL DESIGN SECTION
ASST. DISTRICT ENGINEER, TRAFFIC
CHIEF, TRAFFIC ENGINEERING DIVISION
DEPUTY CHIEF ENGINEER, TRAFFIC

ORIGINAL ON FILE

MDOT STATE HIGHWAY ADMINISTRATION
Office of Traffic
TRAFFIC ENGINEERING DIVISION

DRAWN BY: W.J. NIES (FOR SIS)
DES. BY: R.R. ZACHERL (FOR SIS)
CHK. BY:

MD 450 AND MD 410 (EXTENDED)
COUNTY: PRINCE GEORGE'S

DATE: 10-5-89
SCALE: 1"=20'
F.A.P. NO. AC-IX-130-1(28)
P-822-502-370
DESIGN NO. 2279CX
SHEET NO. 2 OF 8

16045004.22