F.H.W.A. REGION NO.	STATE	FED. AID PROJ. NO.	SHEET NO.	TOTAL SHEETS
3	MD.		10	15

SIGNALS
12" R,Y W/8" Y
15-20

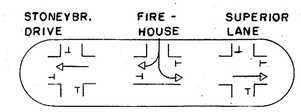

PRE-EMPTION PHASE

21, 22
FIRE HOUSE SIGNAL

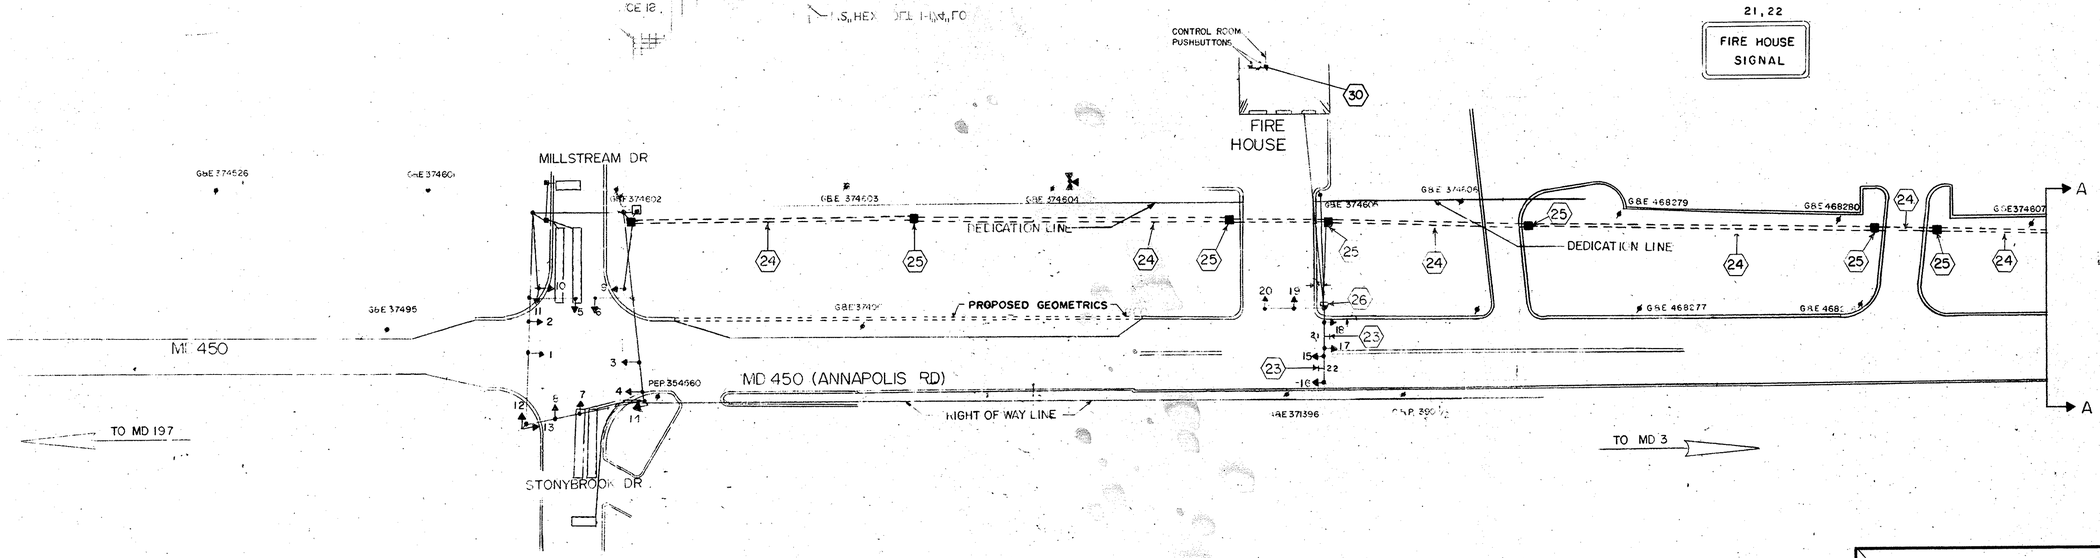

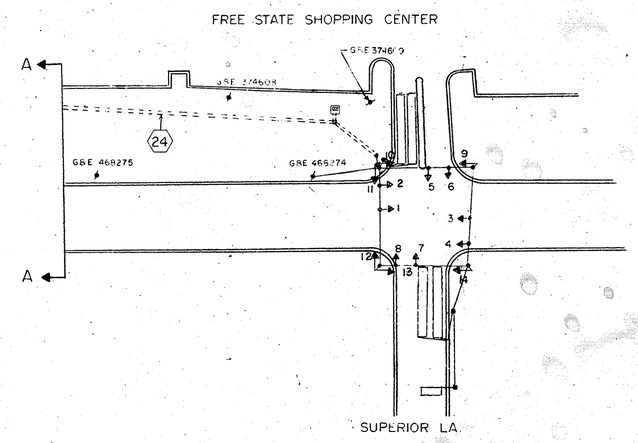

NOTE: THIS IS A REVISION TO THE THE TRAFFIC SIGNAL INSTALLED UNDER CONTRACT No. P-328-001-585 (FAP-U-931 I(I))

APPROVAL: REGIONAL TRAFFIC ENGINEER

APPROVAL: CHIEF-BUREAU OF TRAFFIC ENGINEERING

APPROVAL: ASS'T. CHIEF ENGINEER TRAFFIC

B	4/85 REPLACEMENT OF CABINET AT THE FIRE HOUSE B-791-501-377
DCD	
A	7/83 "ASBUILT" P-328-001-585 FAP U 931 I(I)
DCD	

REVISIONS

STATE OF MARYLAND
DEPARTMENT OF TRANSPORTATION
STATE HIGHWAY ADMINISTRATION

TRAFFIC DIVISION – BUREAU OF TRAFFIC ENGINEERING

MD 450 & BOWIE VOL. FIRE DEPT. (STATION NO 2)

SHEET 9 OF 14

SCALE	DATE	CONTRACT NO.
1"=50'	1-22-74	P-328-001-385 FAP NO U-931-I(I)

DRAWN BY: B TYSON
COUNTY: PRINCE GEORGES
DESIGNED BY:
SIGNAL NO.: 16328
CHECKED BY:
DRAWING NO. TS-1119 ~~A~~ B

BRUNING 44-511 19927