F.H.WA. REGION NO.	STATE	FED. AID PROJ. NO.	SHEET NO.	TOTAL SHEETS
3	MD.	U-931-1(2)	18	28

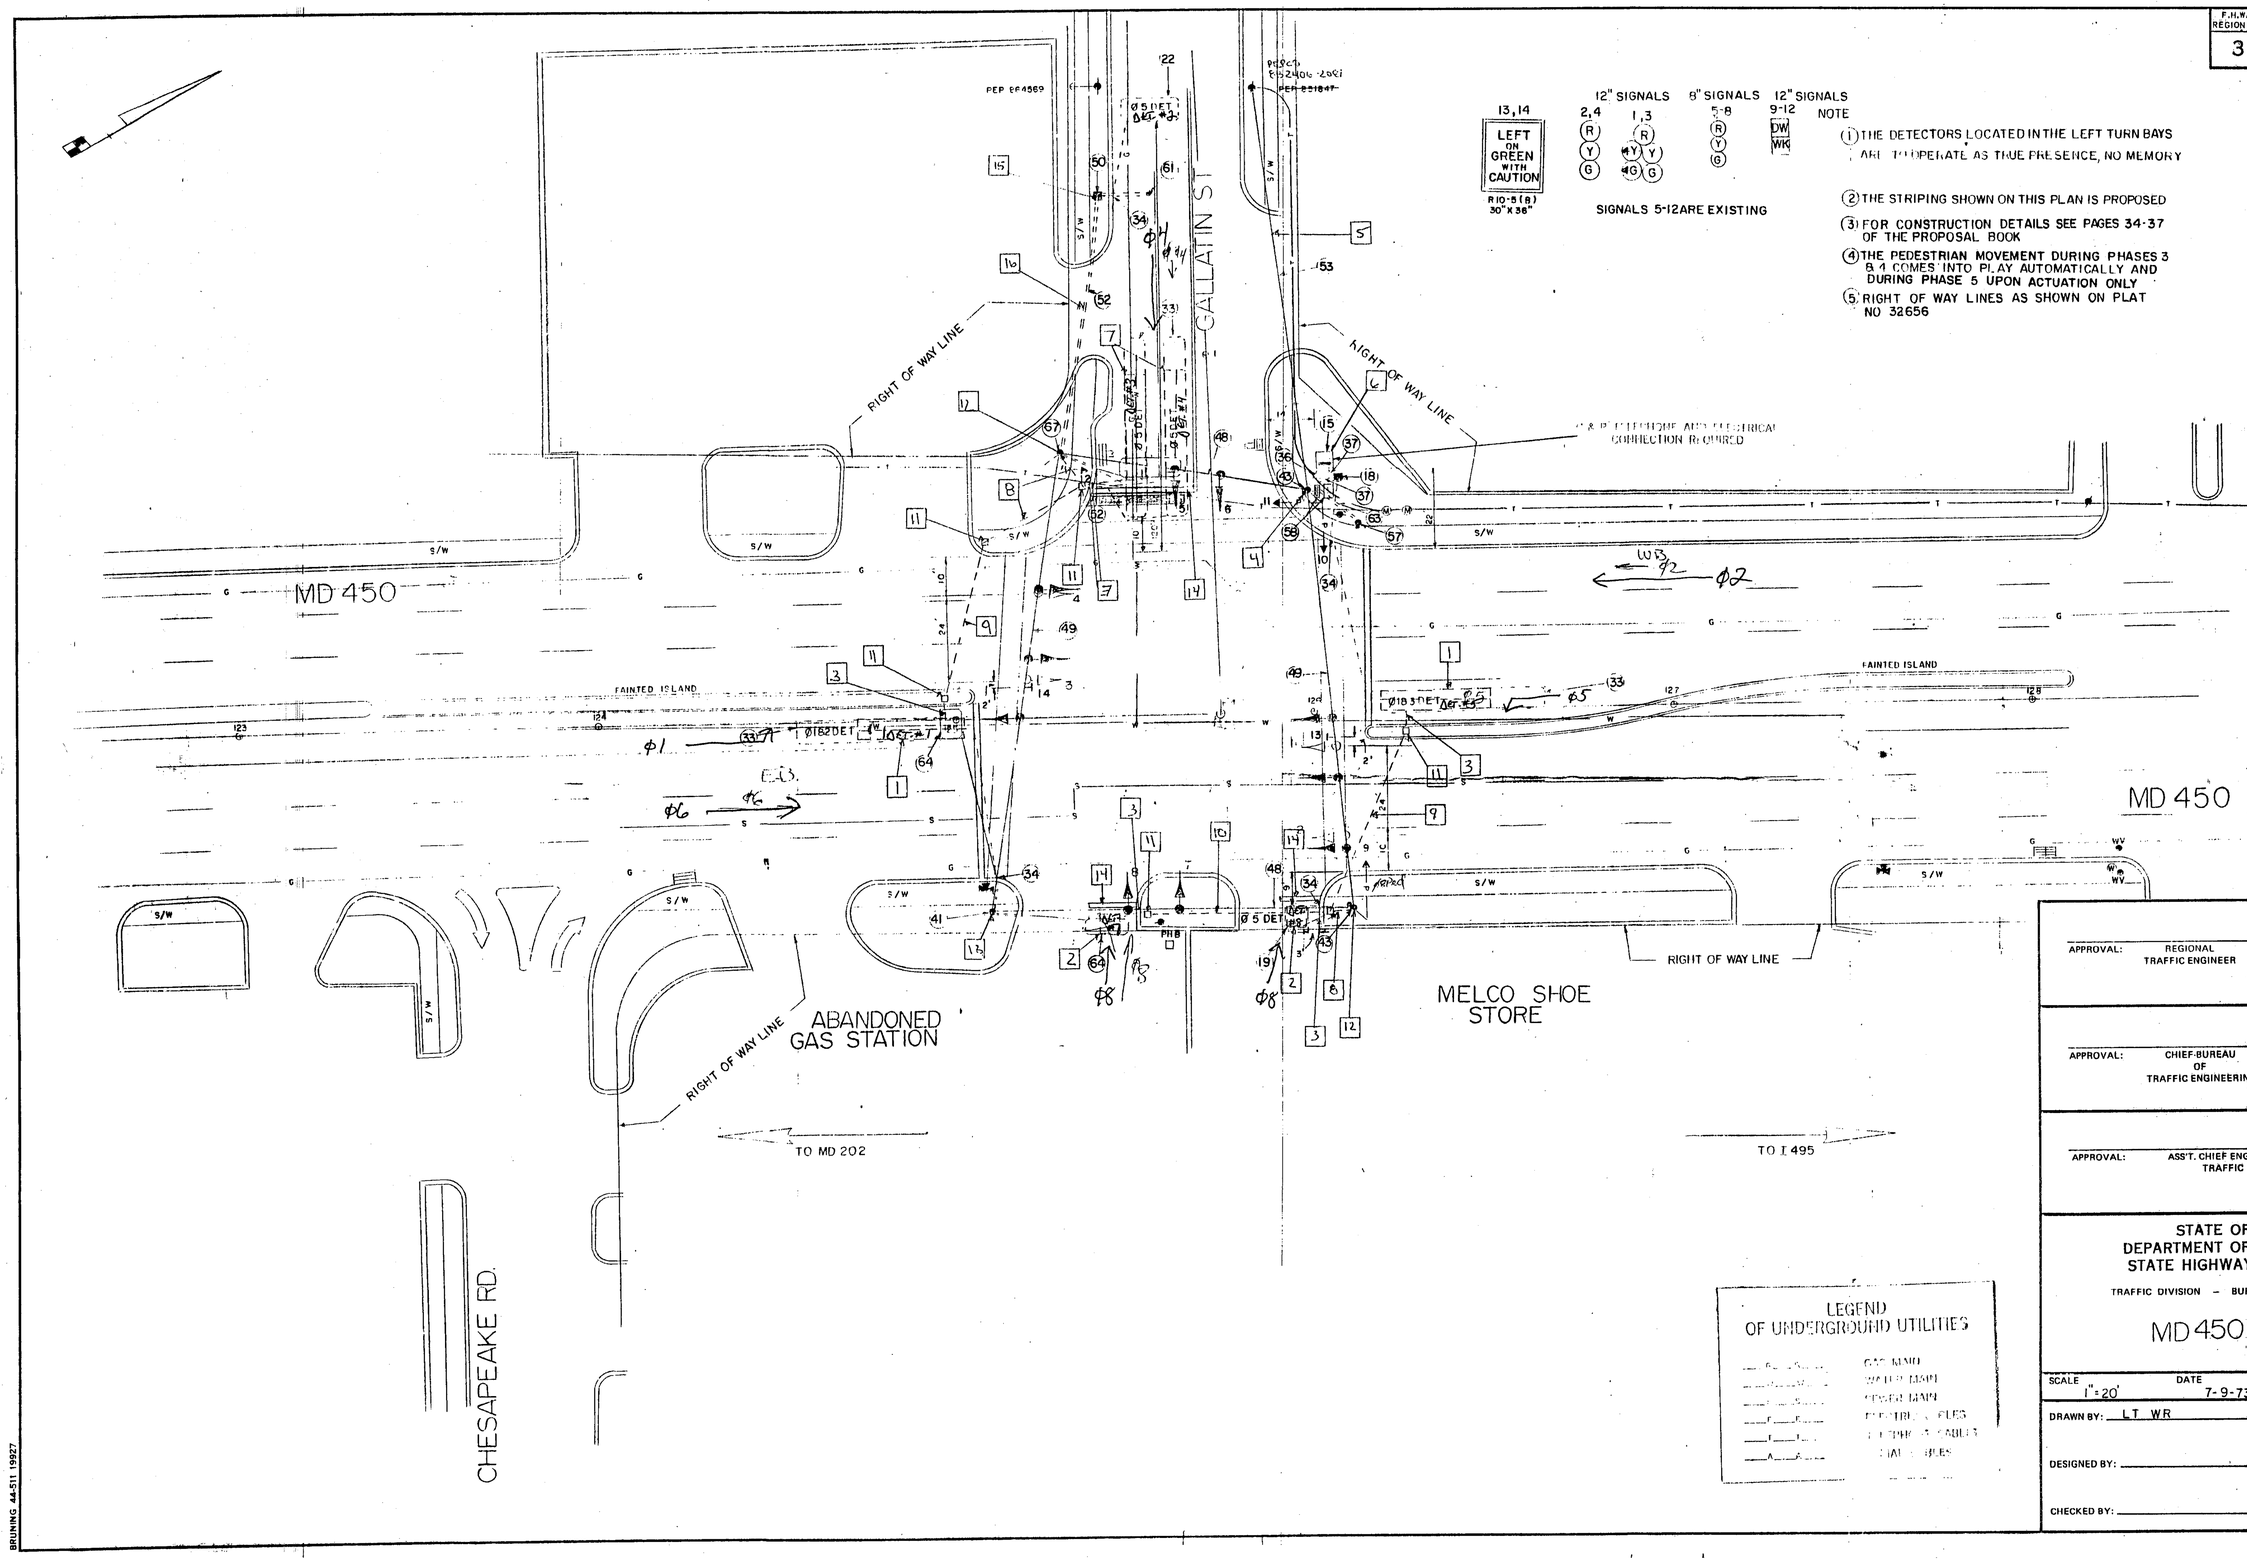

APPROVAL: REGIONAL TRAFFIC ENGINEER

APPROVAL: CHIEF-BUREAU OF TRAFFIC ENGINEERING

APPROVAL: ASS'T. CHIEF ENGINEER TRAFFIC

REVISIONS

STATE OF MARYLAND
DEPARTMENT OF TRANSPORTATION
STATE HIGHWAY ADMINISTRATION

TRAFFIC DIVISION – BUREAU OF TRAFFIC ENGINEERING

MD 450 & GALLATIN ST

SHEET 18 OF 28

SCALE 1" = 20' | DATE 7-9-73 | CONTRACT NO. P-420-000-385 FAP NO U-931-1(2)

DRAWN BY: LT WR | COUNTY: PRINCE GEORGES

DESIGNED BY: | SIGNAL NO.: 16238

CHECKED BY:

DRAWING NO. TS-118

BRUNING 44-511 19927