F H WA REGION NO	STATE	FED. AID PROJ. NO	SHEET NO.	TOTAL SHEETS
3	MD.			

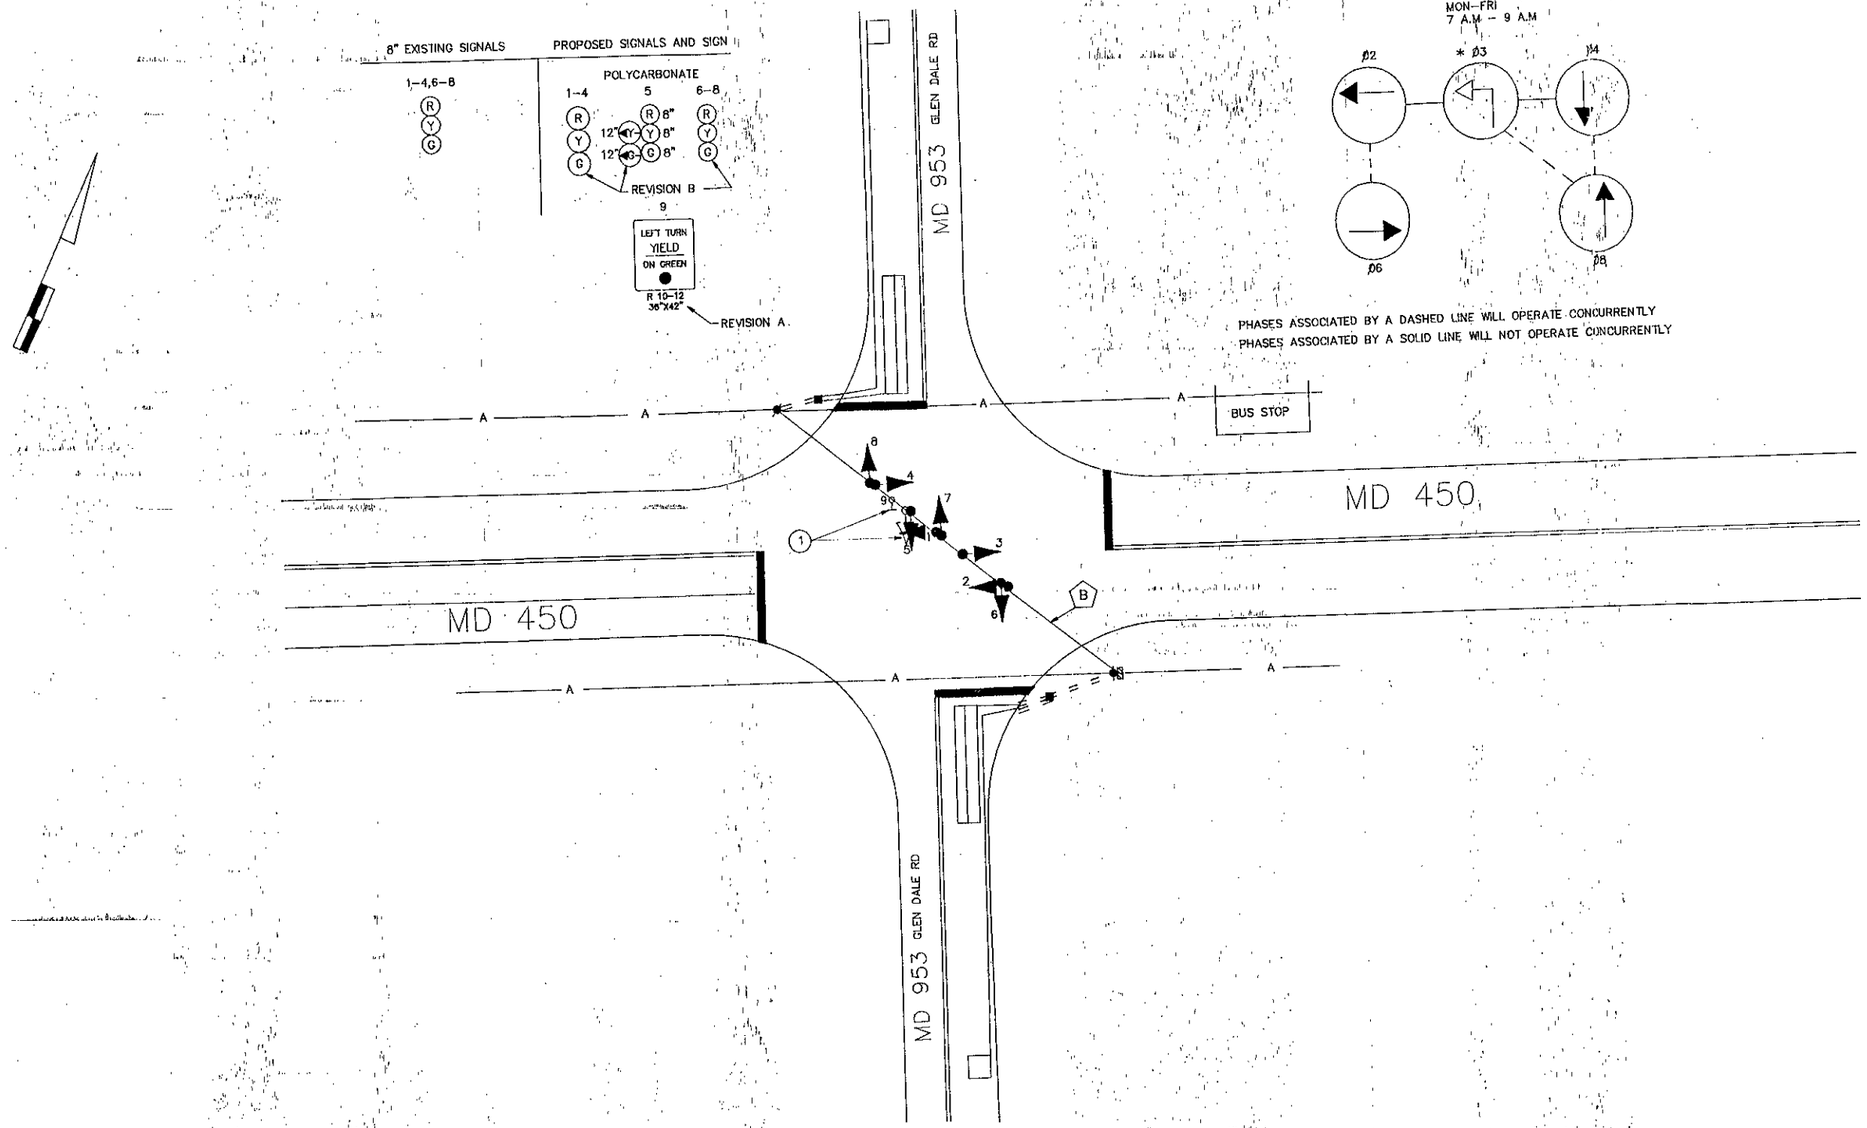

UTILITY LEGEND

G	GAS MAIN
W	WATER MAIN
S	SEWER MAIN
E	ELECTRIC CABLES
A	AERIAL CABLES

REVISIONS	APPROVALS
(B) 2/91 CHANGE SIGNALS TO POLYCARBONATE ADJUST SPAN. S.H.A. NO. 855-25031039	CHIEF, SIGNAL DESIGN SECTION
(A) INSTALL E/P LEFT TURN FOR NB MD 953	ASST. DISTRICT ENGINEER, TRAFFIC
OBD SR DZ ETP TH	CHIEF, TRAFFIC ENGINEERING DIVISION
	DEPUTY CHIEF ENGINEER, OFFICE OF TRAFFIC

MDOT – STATE HIGHWAY ADMINISTRATION #F0834

Office of Traffic

TRAFFIC ENGINEERING DIVISION

SIGNAL # REUSED

DRAWN BY: DERRICK DICKERSON

DES. BY:

CHK. BY:

MD 450 AND MD 953 (GLEN DALE RD)

16045007.90

COUNTY: PRINCE GEORGES

DATE: 9/90

SCALE: 1" = 20"

F.A.P. NO.

S.H.A. NO.

TS/STD. NO. 3083 B

SHEET NO. ___ OF ___