F.H.W.A. REGION NO.	STATE	FED. AID PROJ. NO.	SHEET NO.	SHEETS
3	MD.	U-931-1(2)	21	28

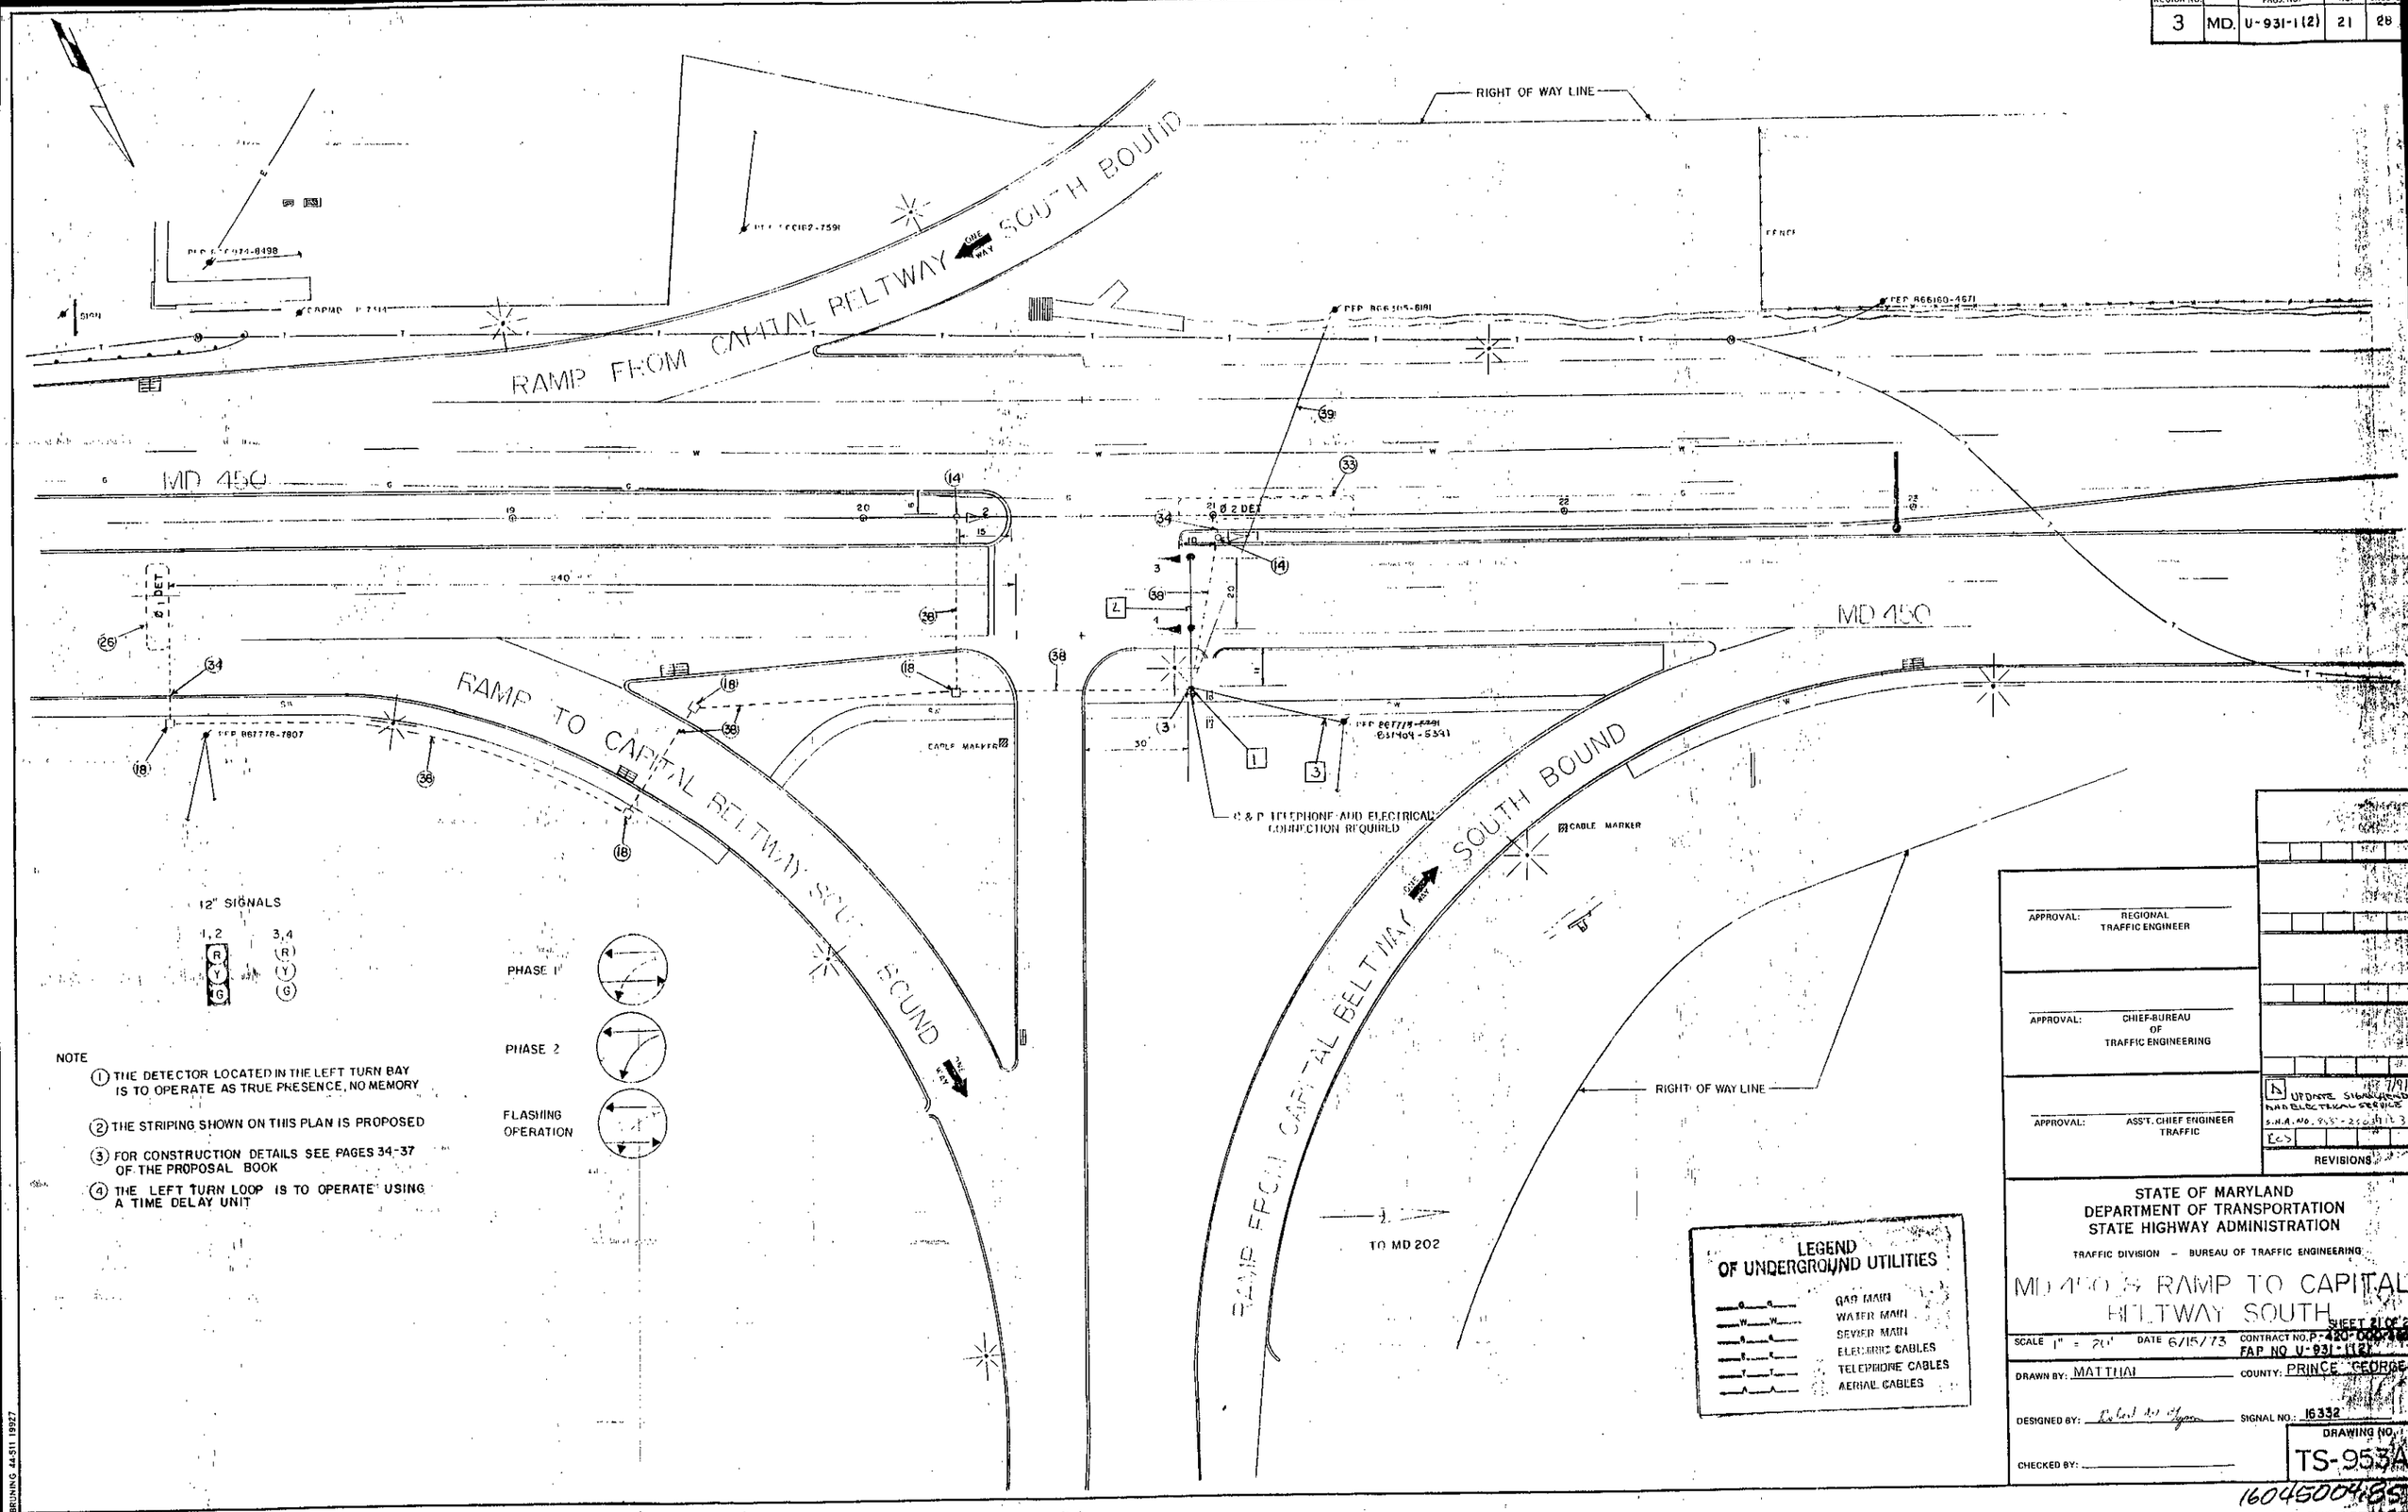

APPROVAL: REGIONAL TRAFFIC ENGINEER

APPROVAL: CHIEF-BUREAU OF TRAFFIC ENGINEERING

APPROVAL: ASS'T. CHIEF ENGINEER TRAFFIC

REVISIONS

STATE OF MARYLAND
DEPARTMENT OF TRANSPORTATION
STATE HIGHWAY ADMINISTRATION

TRAFFIC DIVISION – BUREAU OF TRAFFIC ENGINEERING

MD 450 & RAMP TO CAPITAL BELTWAY SOUTH

SHEET 21 OF 28

SCALE 1" = 20' DATE 6/15/73 CONTRACT NO. P-420-000-000 FAP NO. U-931-1(2)

DRAWN BY: MATTHAI COUNTY: PRINCE GEORGES

DESIGNED BY: SIGNAL NO.: 16332

CHECKED BY:

DRAWING NO. TS-953A

1604500485

BRUNING 44-511 19927