F.H.W.A. REGION NO.	STATE	FED. AID PROJ. NO.	SHEET NO.	TOTAL SHEETS
3	MD.		3	7

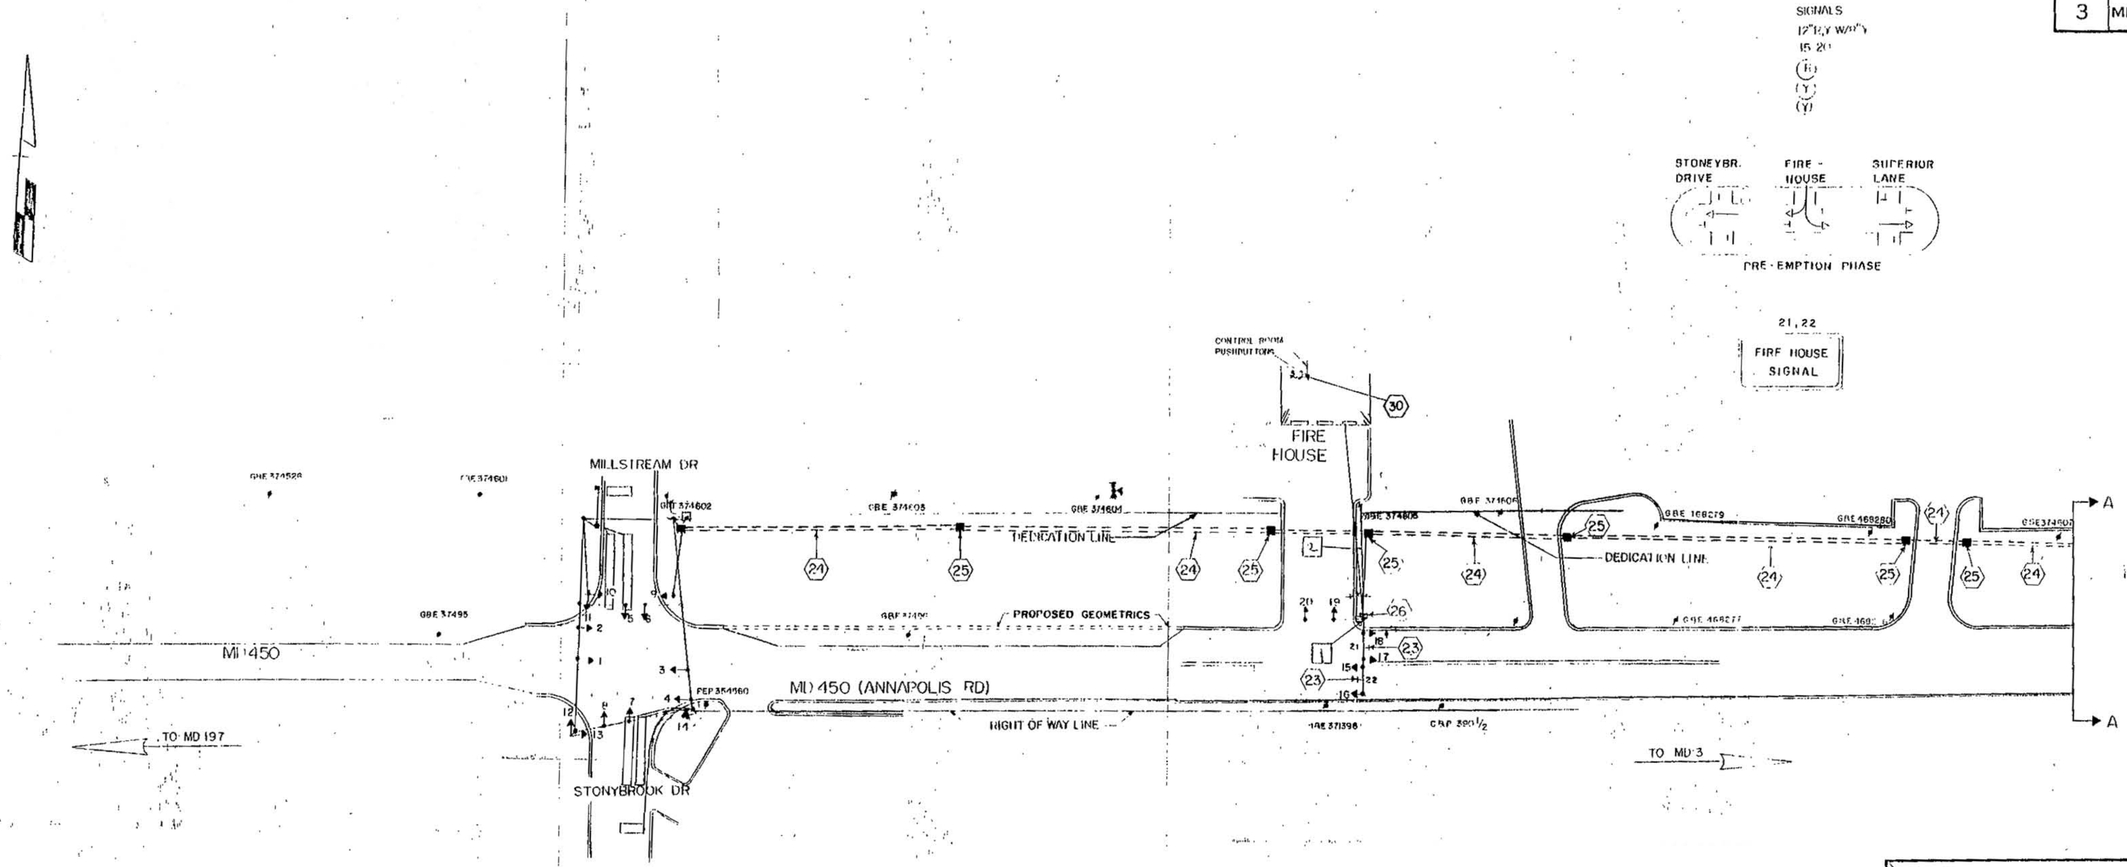

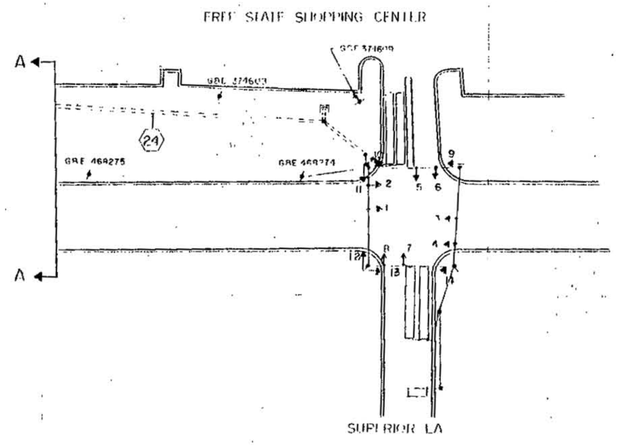

NOTE: THIS IS A REVISION TO THE THE TRAFFIC SIGNAL INSTALLED UNDER CONTRACT No. P-328-001-585 (FAP-U-931 (1))

APPROVAL: REGIONAL TRAFFIC ENGINEER

APPROVAL: CHIEF-BUREAU OF TRAFFIC ENGINEERING

APPROVAL: ASS'T. CHIEF ENGINEER TRAFFIC

C UPDATE CONTROLLER CABINET 7/91

S.H.A. NO.

(B) 4/85 REPLACEMENT OF CABINET AT THE FIRE HOUSE R-791-501-377

DCD

A 7/83 "ASBUILT" P-328-001-585 FAP U 931 (1)

DCD

REVISIONS

STATE OF MARYLAND
DEPARTMENT OF TRANSPORTATION
STATE HIGHWAY ADMINISTRATION

TRAFFIC DIVISION – BUREAU OF TRAFFIC ENGINEERING

MD450 & BOWIE VOL. FIRE DEPT (STATION NO 2)

SHEET 9 OF 14

SCALE 1"-50' DATE 1-22-74 CONTRACT NO. P-328-001-585 FAP NO U-931-1(1)

DRAWN BY: B TYSON COUNTY: PRINCE GEORGES

DESIGNED BY: [signature] SIGNAL NO.: 16328

CHECKED BY:

DRAWING NO TS-1119 C

16045012.77