F.H.W.A. REGION NO.	STATE	FED AID PROJ. NO.	SHEET NO.	TOTAL SHEETS
3	MD.		2	5

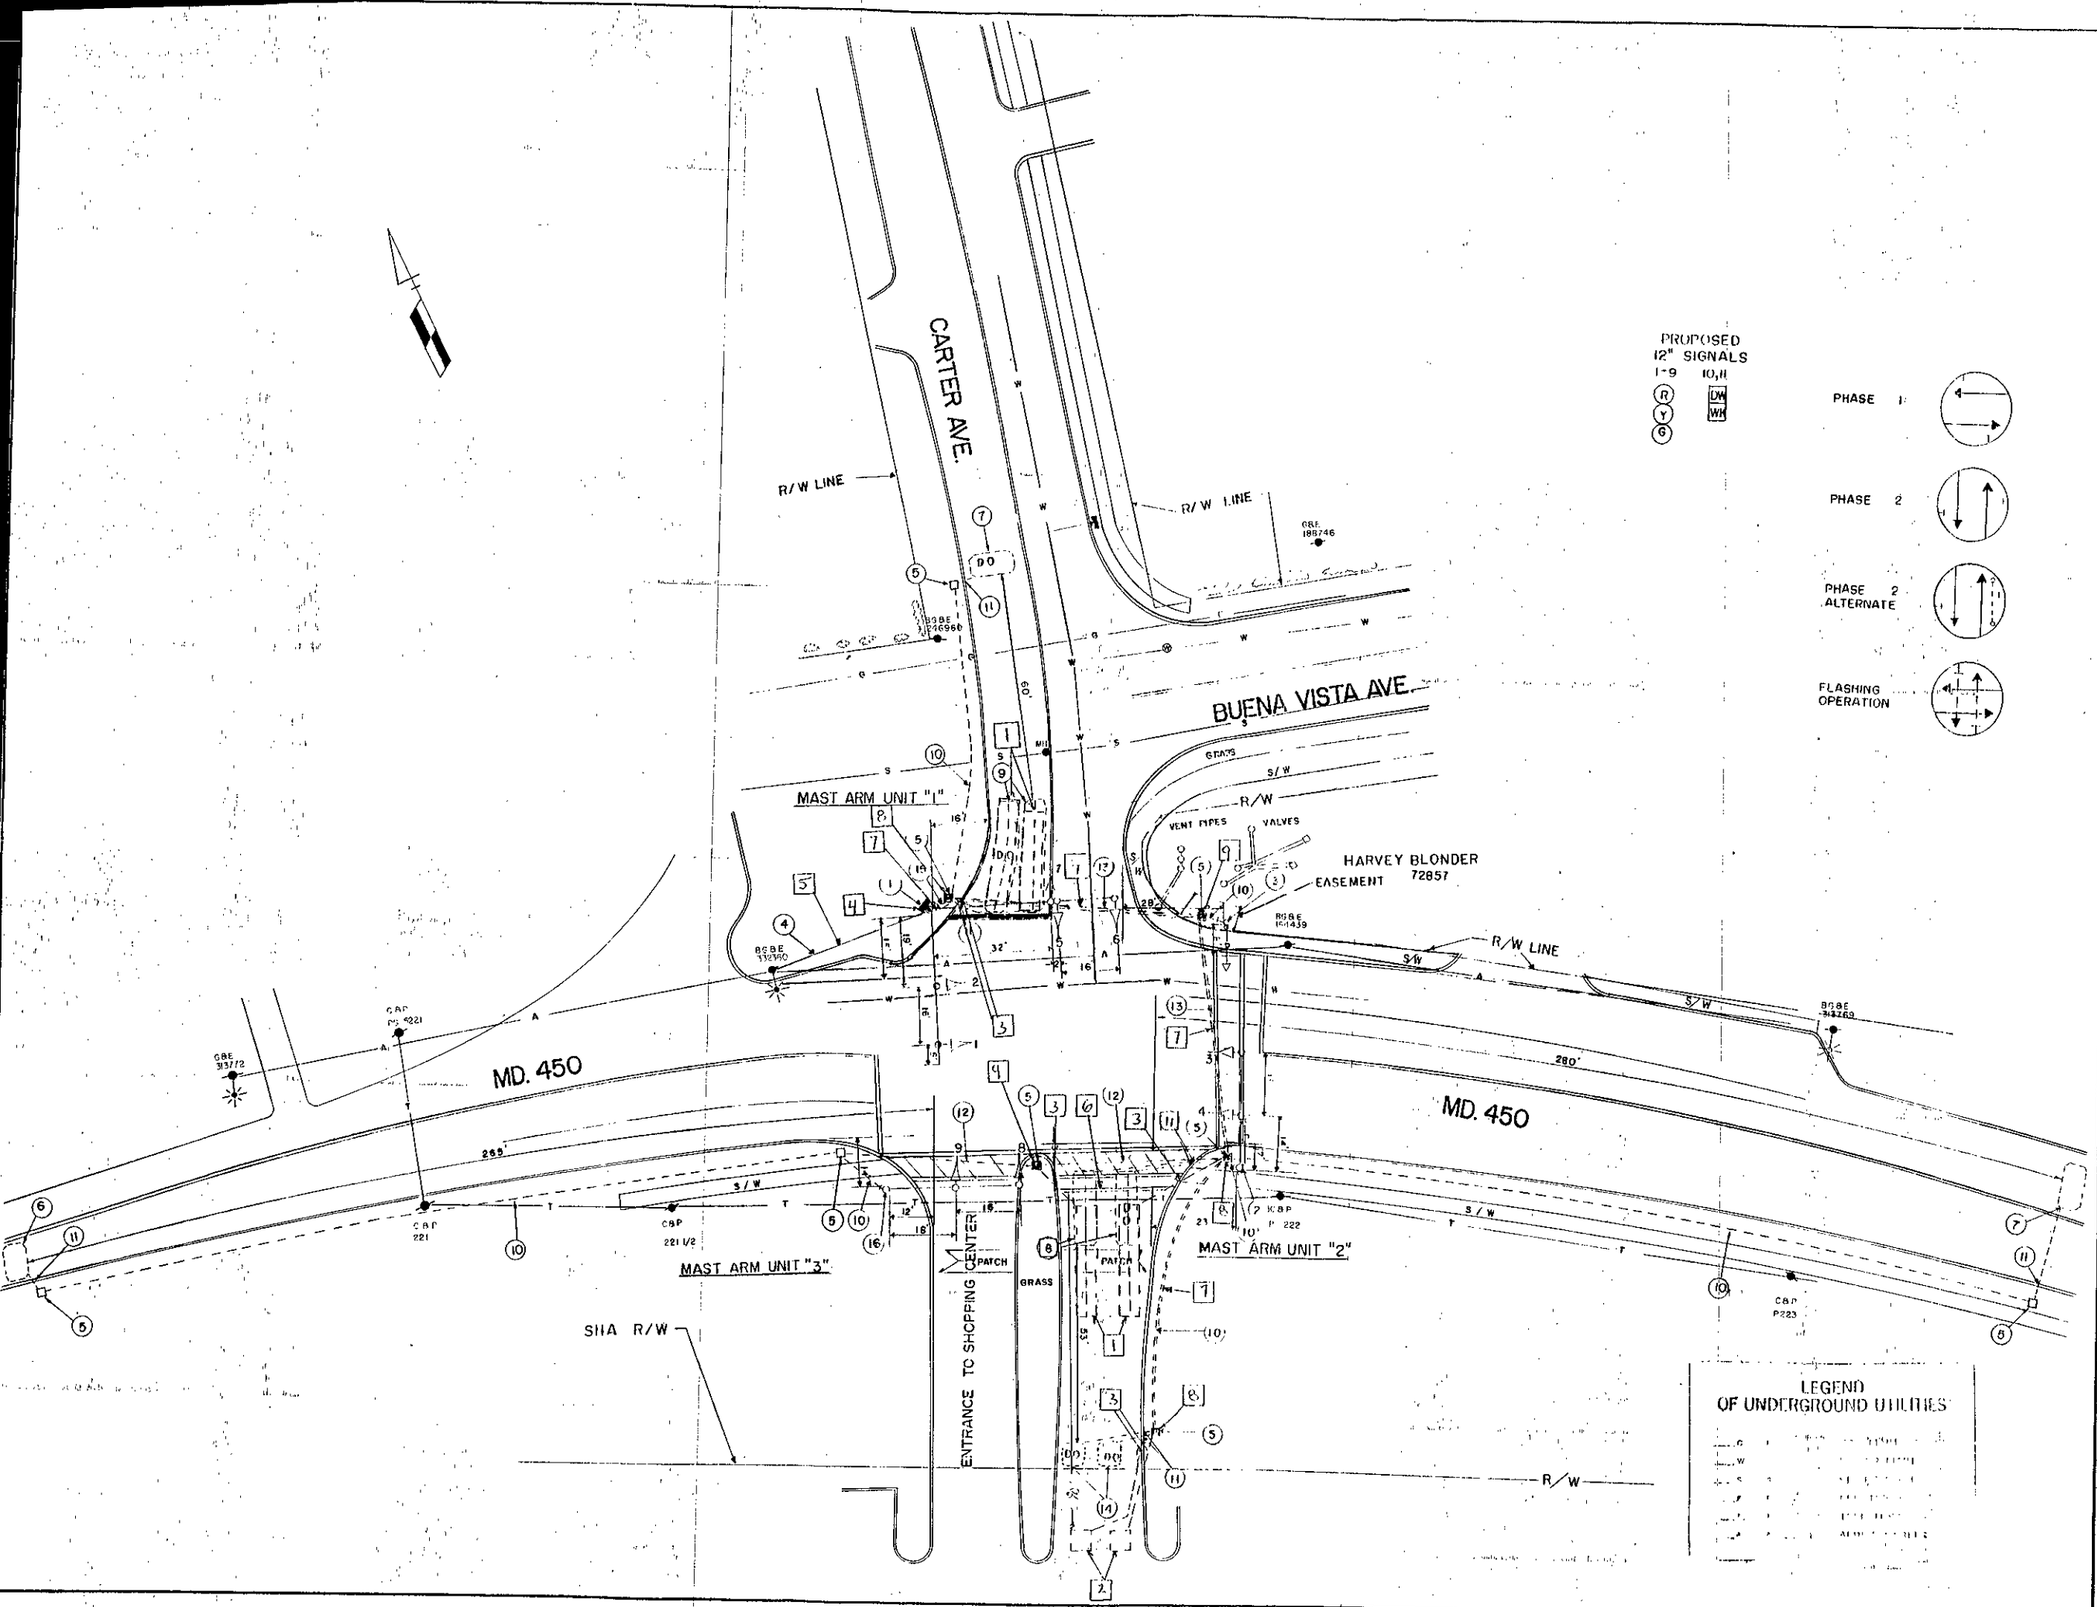

PROPOSED
12" SIGNALS
1-9 10,11
R DW
Y WK
G

NOTE:
1) THE STRIPING SHOWN ON THIS PLAN IS PROPOSED.

LEGEND
OF UNDERGROUND UTILITIES

APPROVAL: CHIEF SIGNAL DESIGN SECTION

APPROVAL: REGIONAL TRAFFIC ENGINEER 3/30/83

APPROVAL: CHIEF-BUREAU OF TRAFFIC ENGINEERING 3/30/83

APPROVAL: ASS'T. CHIEF ENGINEER TRAFFIC 3-31-83

B REPLACE FAILED LOOP DETECTORS 7/91
S.H.A. NO. 955-25031112
RCS

A REVISED LENGTH OF LOOP DETECTORS AT ENT. TO SHOPPING MALL
EMM

REVISIONS

STATE OF MARYLAND
DEPARTMENT OF TRANSPORTATION
STATE HIGHWAY ADMINISTRATION

TRAFFIC DIVISION - BUREAU OF TRAFFIC ENGINEERING

MD. 450 & CARTER AVE. & BUENA VISTA AVE.

SCALE 1"=20' DATE 4-7-81 CONTRACT NO. P-730-501-385

DRAWN BY: THOMAS M. ZAYDEL COUNTY: PRINCE GEORGES

DESIGNED BY: E.M.MILESKY SIGNAL NO.: 16470

CHECKED BY:

DRAWING NO. TS-1818A

16045005,94