F.H.W.A. REGION NO.	STATE	FED. AID PROJ. NO.	SHEET NO.	TOTAL SHEETS
3	MD.			

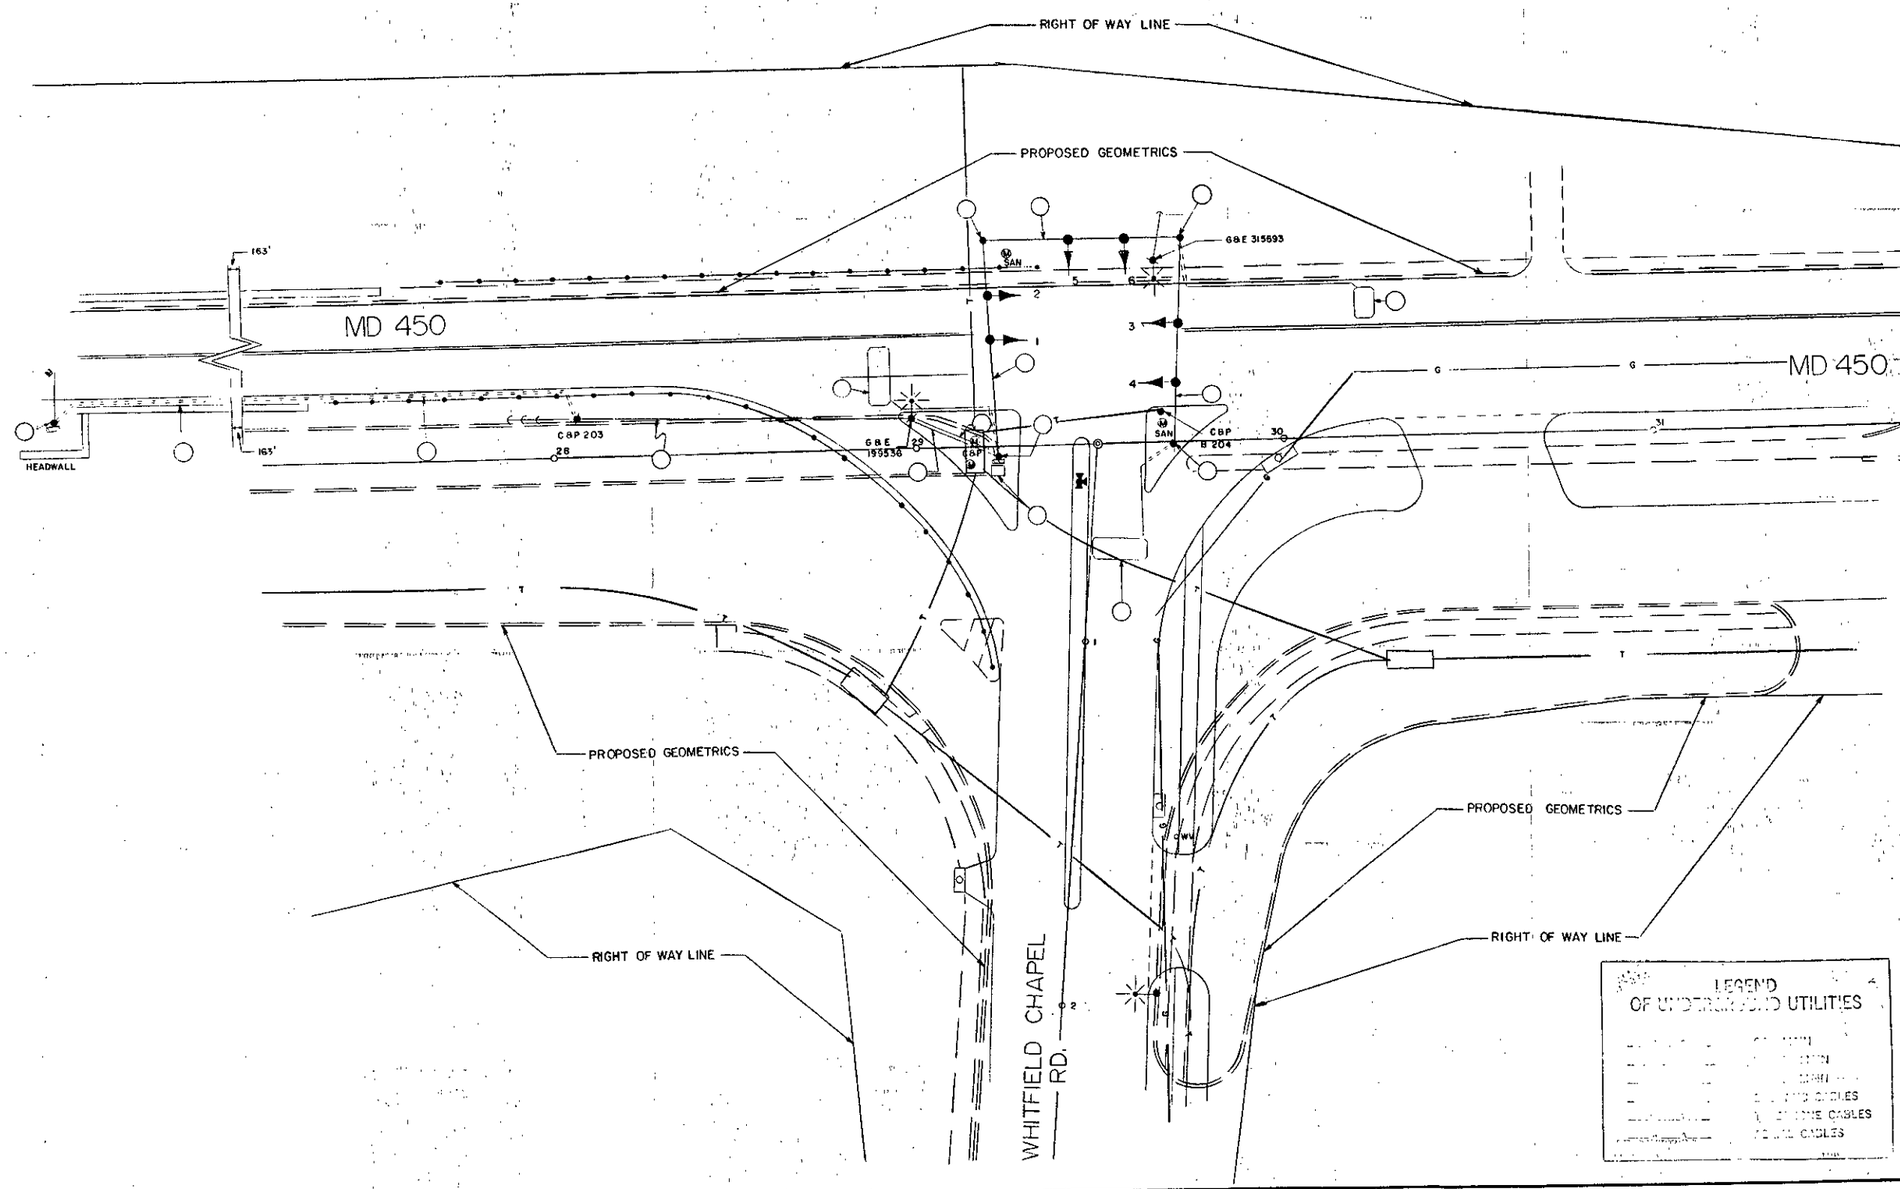

APPROVAL: REGIONAL TRAFFIC ENGINEER

APPROVAL: CHIEF-BUREAU OF TRAFFIC ENGINEERING

APPROVAL: ASS'T. CHIEF ENGINEER TRAFFIC

REVISIONS	
B. MARCH 14, 1975	REDRAWN AND PROPOSED GEOMETRICS ADDED
HF	
A JUNE 7, 1971	AS BUILT
LET	

STATE OF MARYLAND
DEPARTMENT OF TRANSPORTATION
STATE HIGHWAY ADMINISTRATION

TRAFFIC DIVISION – BUREAU OF TRAFFIC ENGINEERING

MD 450 & WHITFIELD CHAPEL RD

SCALE 1" = 20' DATE 3-14-75 CONTRACT NO.

DRAWN BY: H. FLOYD COUNTY: PRINCE GEORGES

DESIGNED BY: SIGNAL NO.: in book 16045005.28

CHECKED BY:

DRAWING NO. TS-144B

16045005.TL