F.H.W.A. REGION NO.	STATE	FED. AID PROJ. NO.	SHEET NO.	TOTAL SHEETS
3	MD		1	1

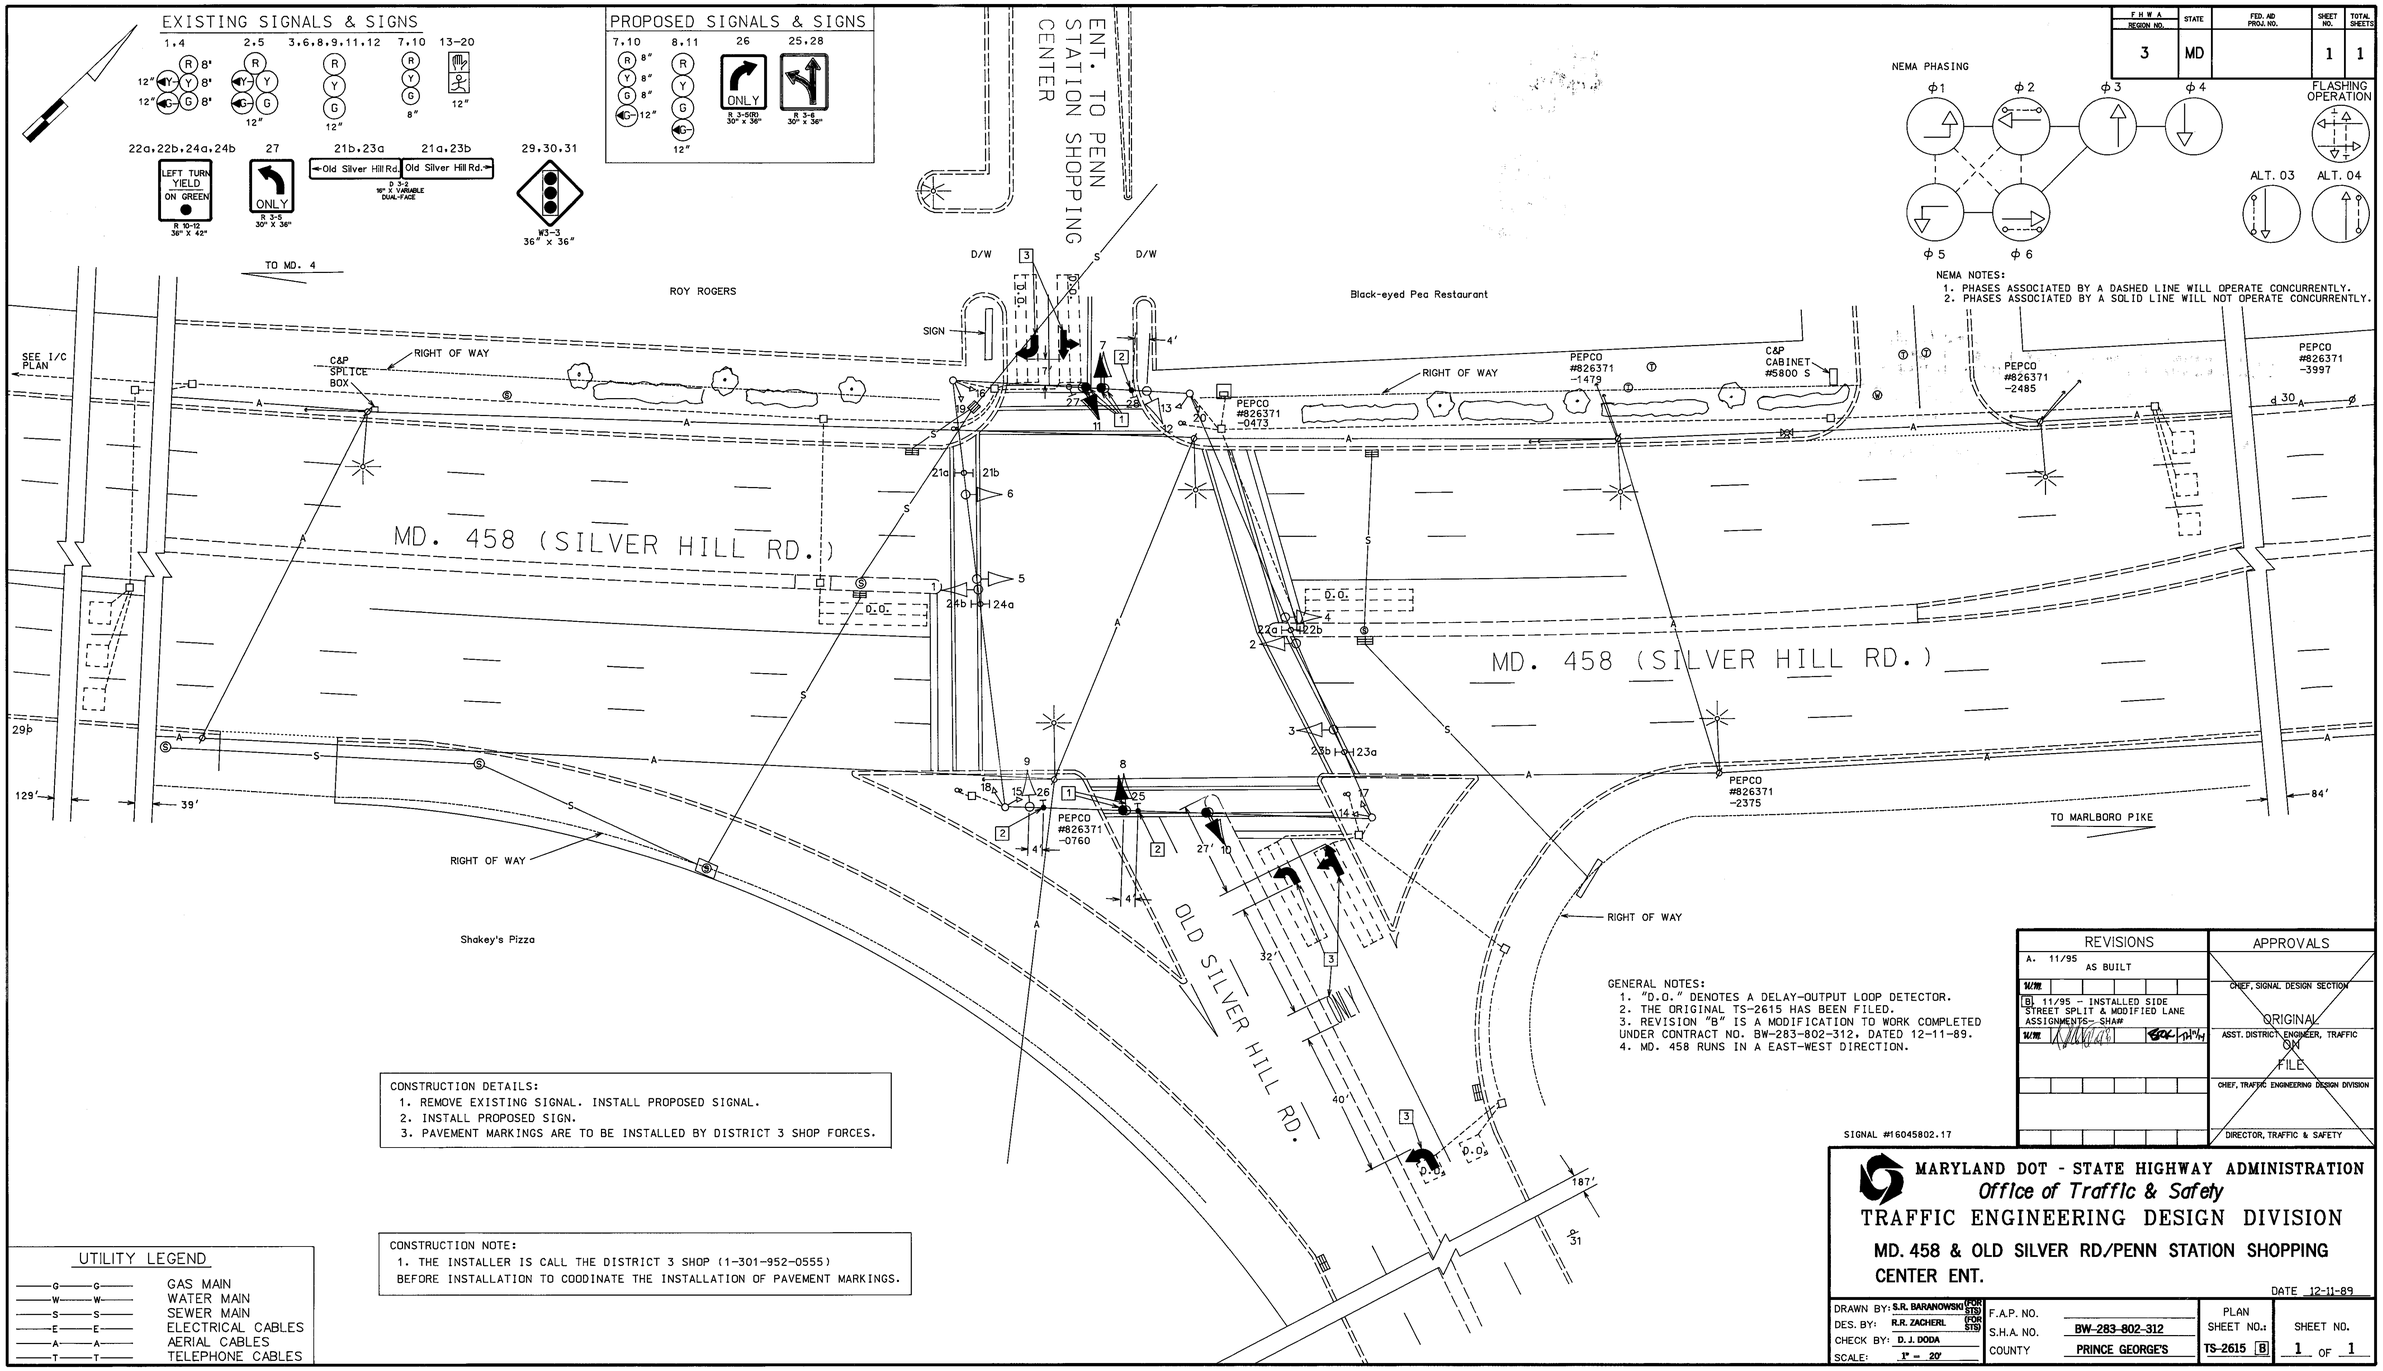

REVISIONS	APPROVALS
A. 11/95 AS BUILT	CHIEF, SIGNAL DESIGN SECTION
B. 11/95 - INSTALLED SIDE STREET SPLIT & MODIFIED LANE ASSIGNMENTS - SHAW	ORIGINAL ON FILE
	ASST. DISTRICT ENGINEER, TRAFFIC
	CHIEF, TRAFFIC ENGINEERING DESIGN DIVISION
	DIRECTOR, TRAFFIC & SAFETY

SIGNAL #16045802.17

MARYLAND DOT - STATE HIGHWAY ADMINISTRATION
Office of Traffic & Safety
TRAFFIC ENGINEERING DESIGN DIVISION

MD. 458 & OLD SILVER RD/PENN STATION SHOPPING CENTER ENT.

DATE 12-11-89

DRAWN BY: S.R. BARANOWSKI (FOR STS)	F.A.P. NO.	PLAN SHEET NO.:	SHEET NO.
DES. BY: R.R. ZACHERL (FOR STS)	S.H.A. NO. BW-283-802-312	TS-2615 B	1 OF 1
CHECK BY: D. J. DODA	COUNTY PRINCE GEORGE'S		
SCALE: 1" = 20'			

16045802.16