F.H.W.A. REGION NO.	STATE	FED. AID PROJ. NO.	SHEET NO.	TOTAL SHEETS
3	MD.	US-9692 (1)	10	16

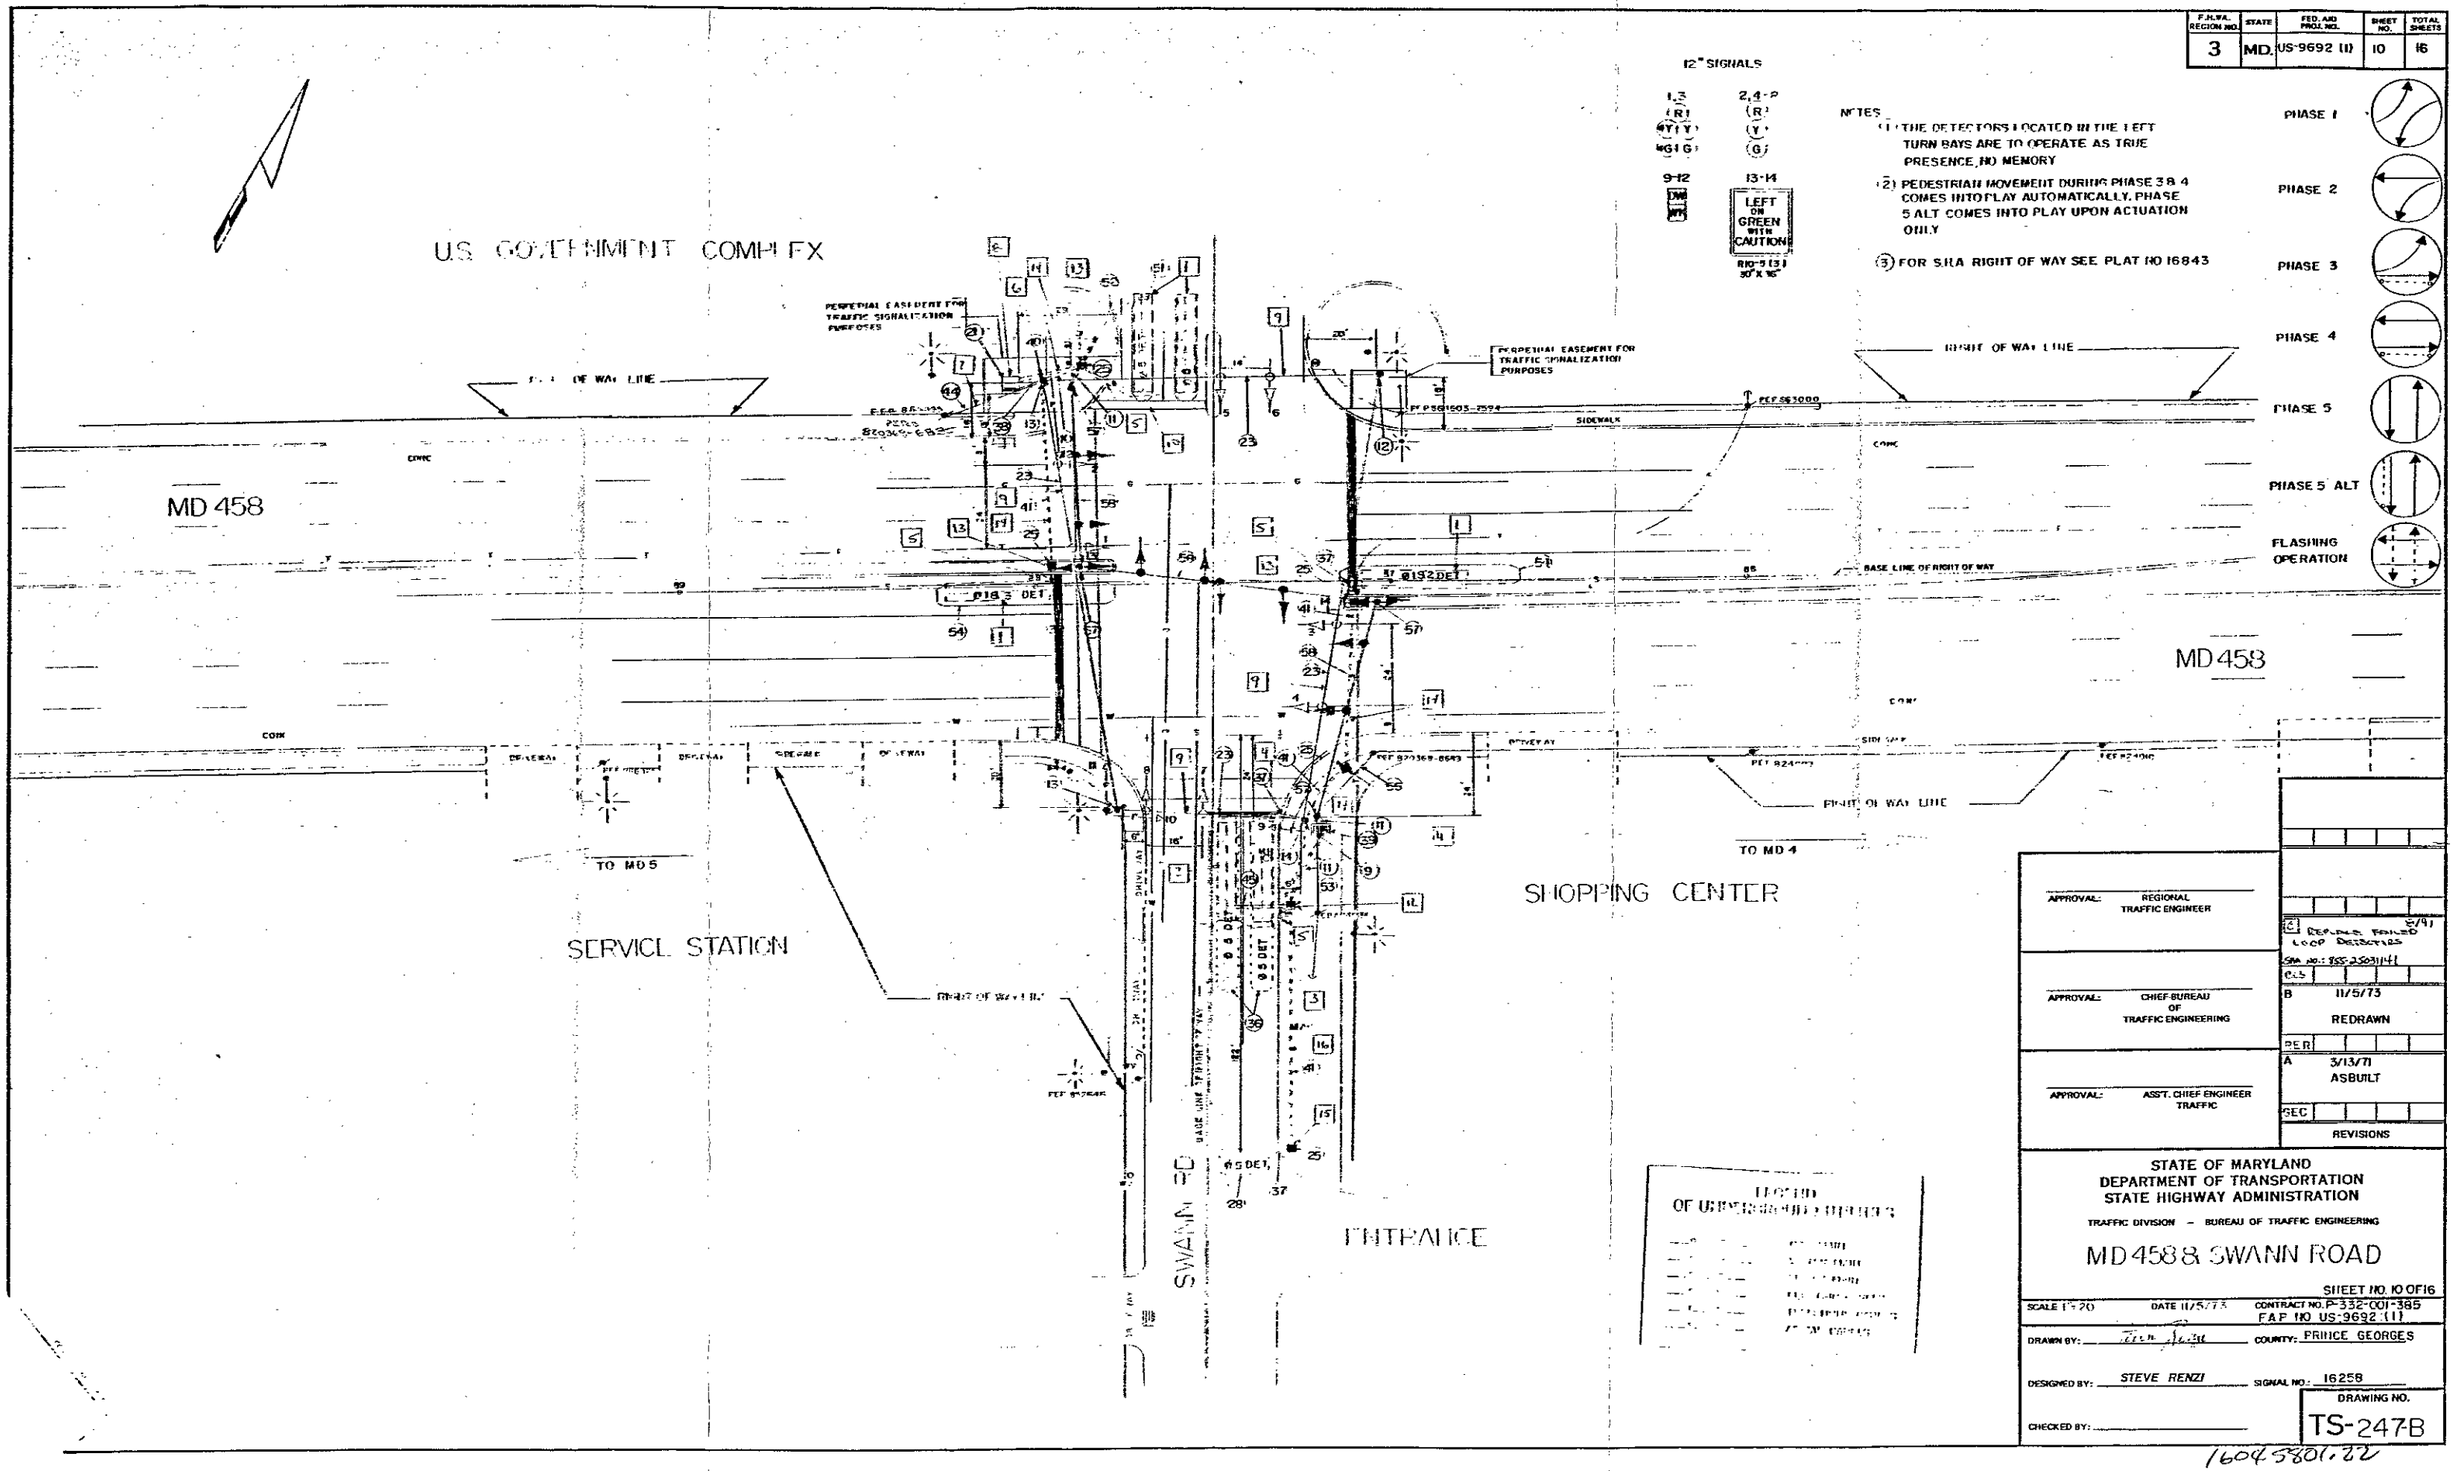

APPROVAL: REGIONAL TRAFFIC ENGINEER

APPROVAL: CHIEF-BUREAU OF TRAFFIC ENGINEERING

APPROVAL: ASS'T. CHIEF ENGINEER TRAFFIC

C REPLACE FAILED LOOP DETECTORS 8/91
SHA NO.: 855-25031141

B 11/5/73 REDRAWN

A 3/13/71 ASBUILT

REVISIONS

STATE OF MARYLAND
DEPARTMENT OF TRANSPORTATION
STATE HIGHWAY ADMINISTRATION

TRAFFIC DIVISION – BUREAU OF TRAFFIC ENGINEERING

MD 458 & SWANN ROAD

SHEET NO. 10 OF 16

SCALE 1"=20' DATE 11/5/73 CONTRACT NO. P-332-001-385 FAP NO. US-9692 (1)

DRAWN BY: [signature] COUNTY: PRINCE GEORGES

DESIGNED BY: STEVE RENZI SIGNAL NO.: 16258

CHECKED BY:

DRAWING NO. TS-247-B

16045801.22