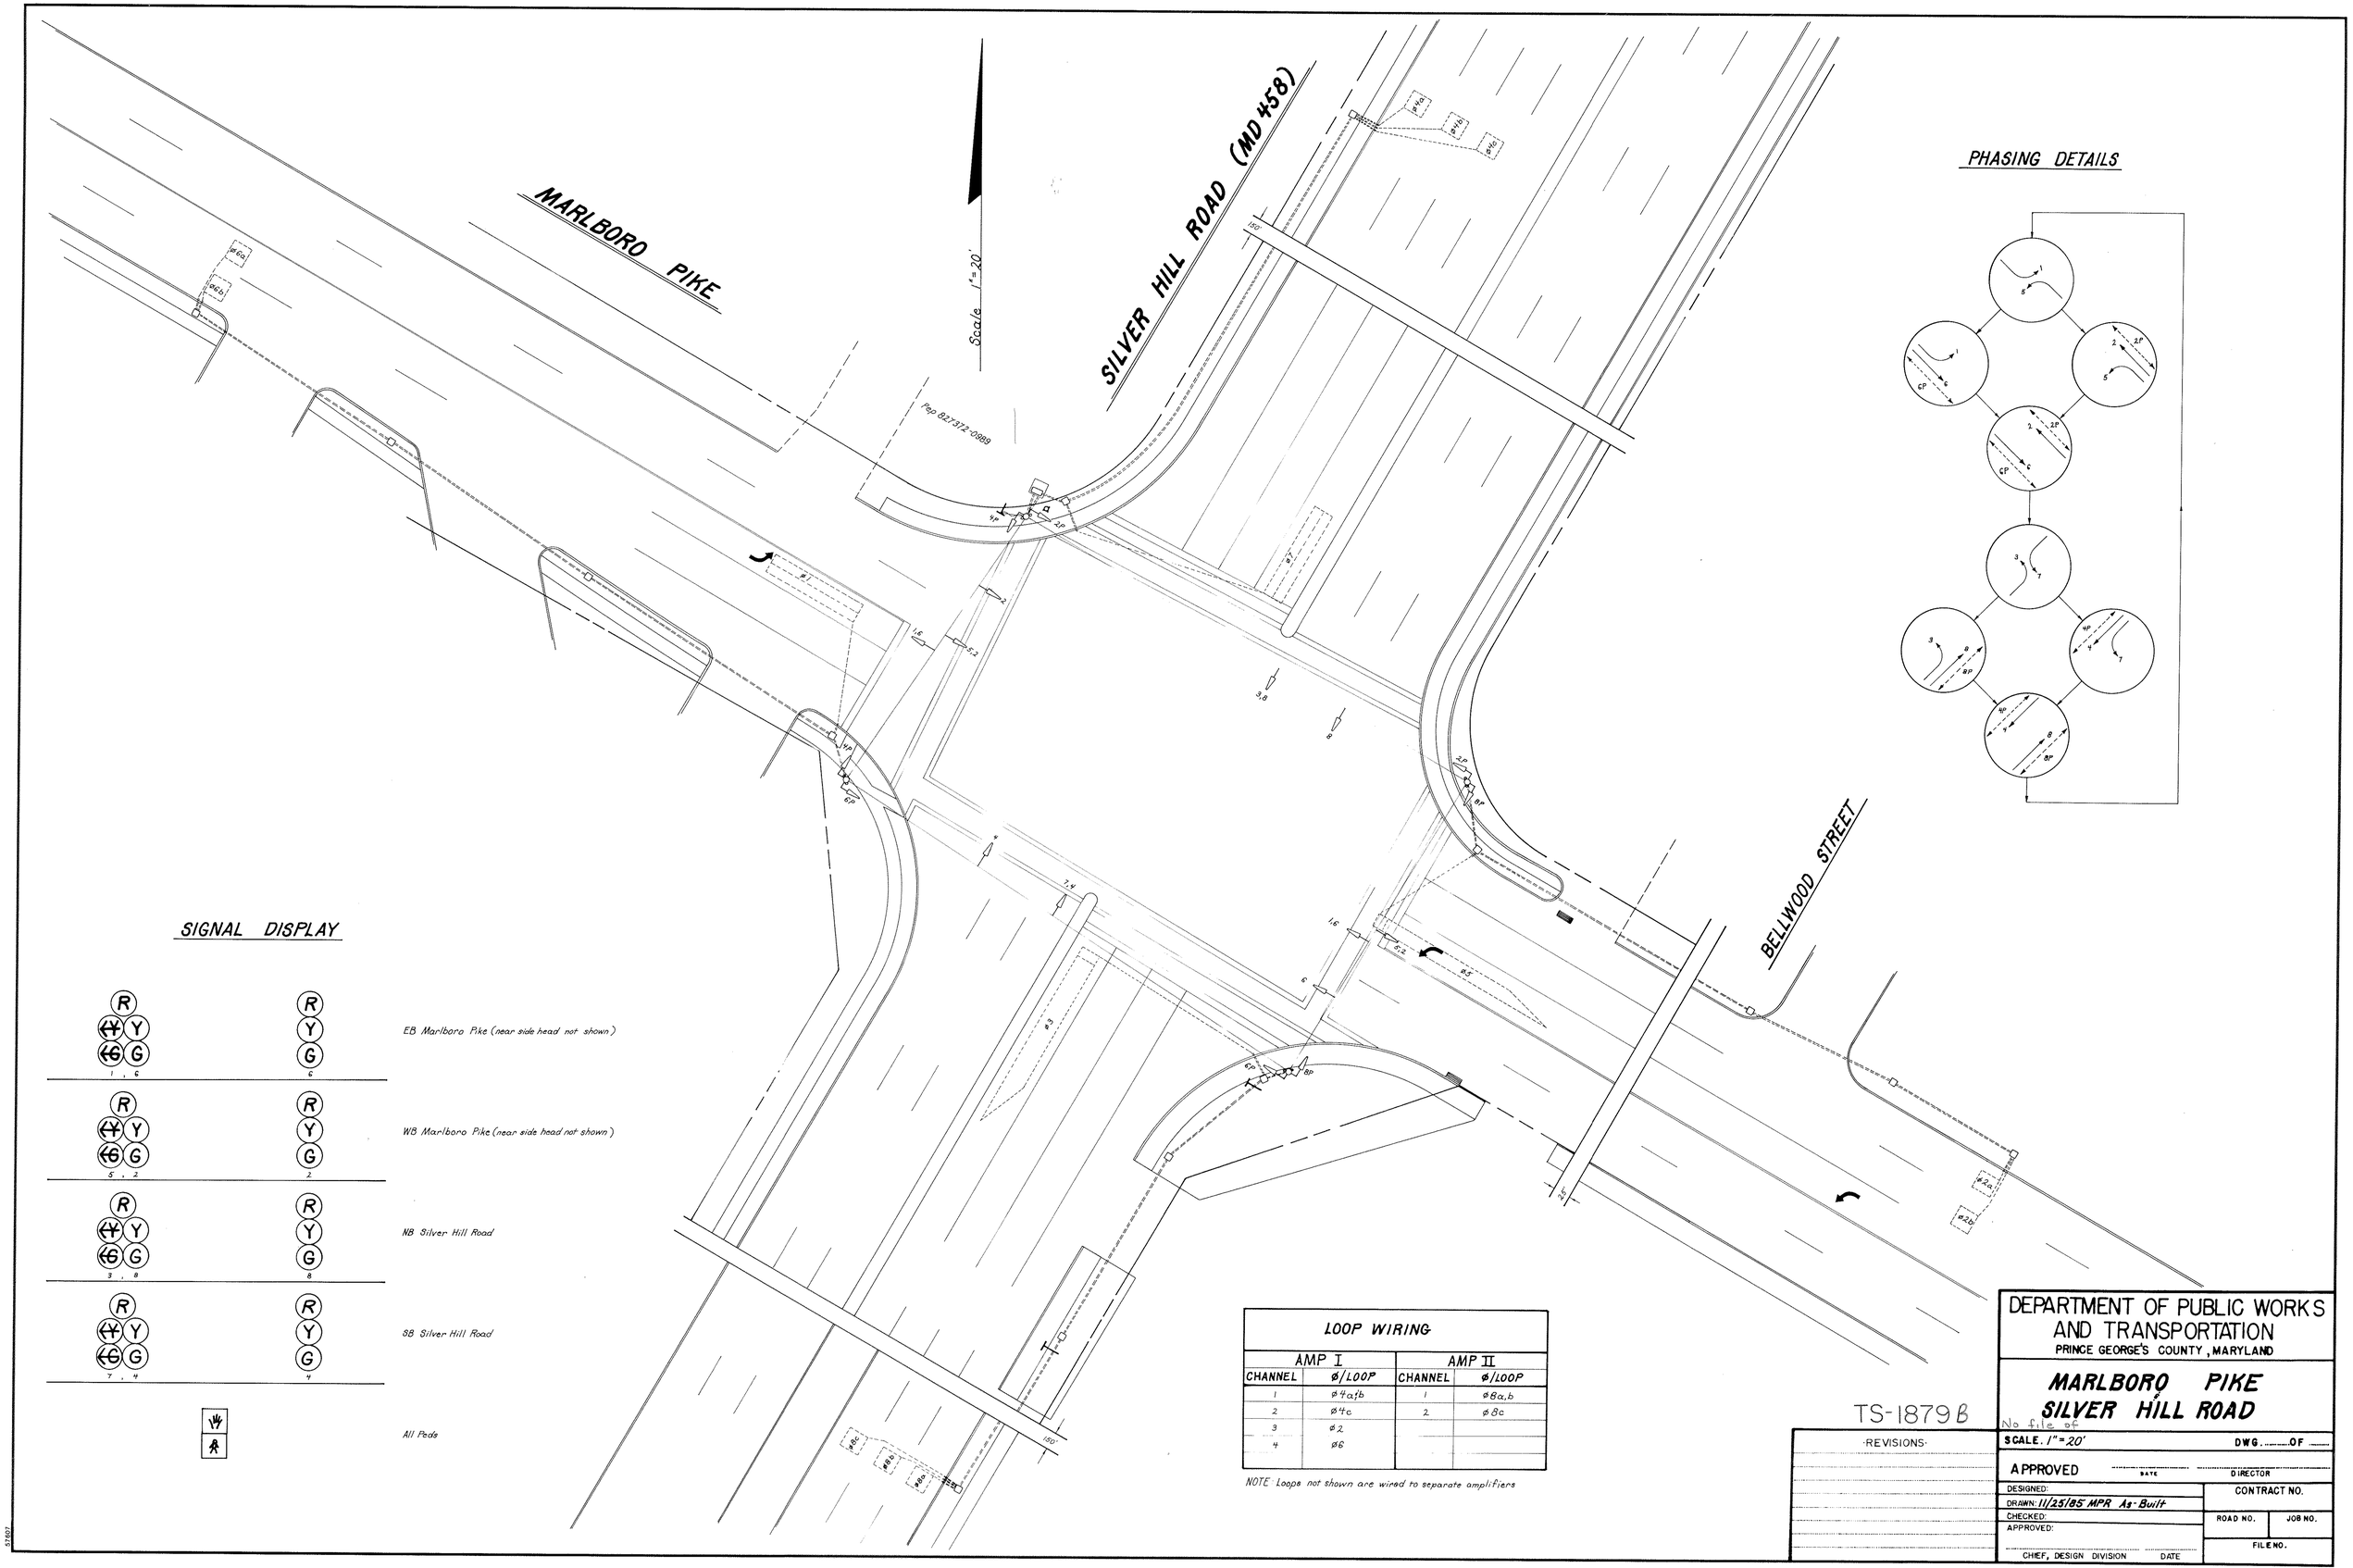

LOOP WIRING

AMP I		AMP II	
CHANNEL	ø/LOOP	CHANNEL	ø/LOOP
1	ø4a,b	1	ø8a,b
2	ø4c	2	ø8c
3	ø2		
4	ø6		

NOTE: Loops not shown are wired to separate amplifiers

DEPARTMENT OF PUBLIC WORKS AND TRANSPORTATION
PRINCE GEORGE'S COUNTY, MARYLAND

MARLBORO PIKE
SILVER HILL ROAD

REVISIONS

SCALE. 1"=20' DWG. ..... OF .....

APPROVED DATE DIRECTOR

DESIGNED:
DRAWN: 11/25/85 MPR As-Built
CHECKED:
APPROVED:
CHIEF, DESIGN DIVISION DATE

CONTRACT NO.
ROAD NO. JOB NO.
FILE NO.