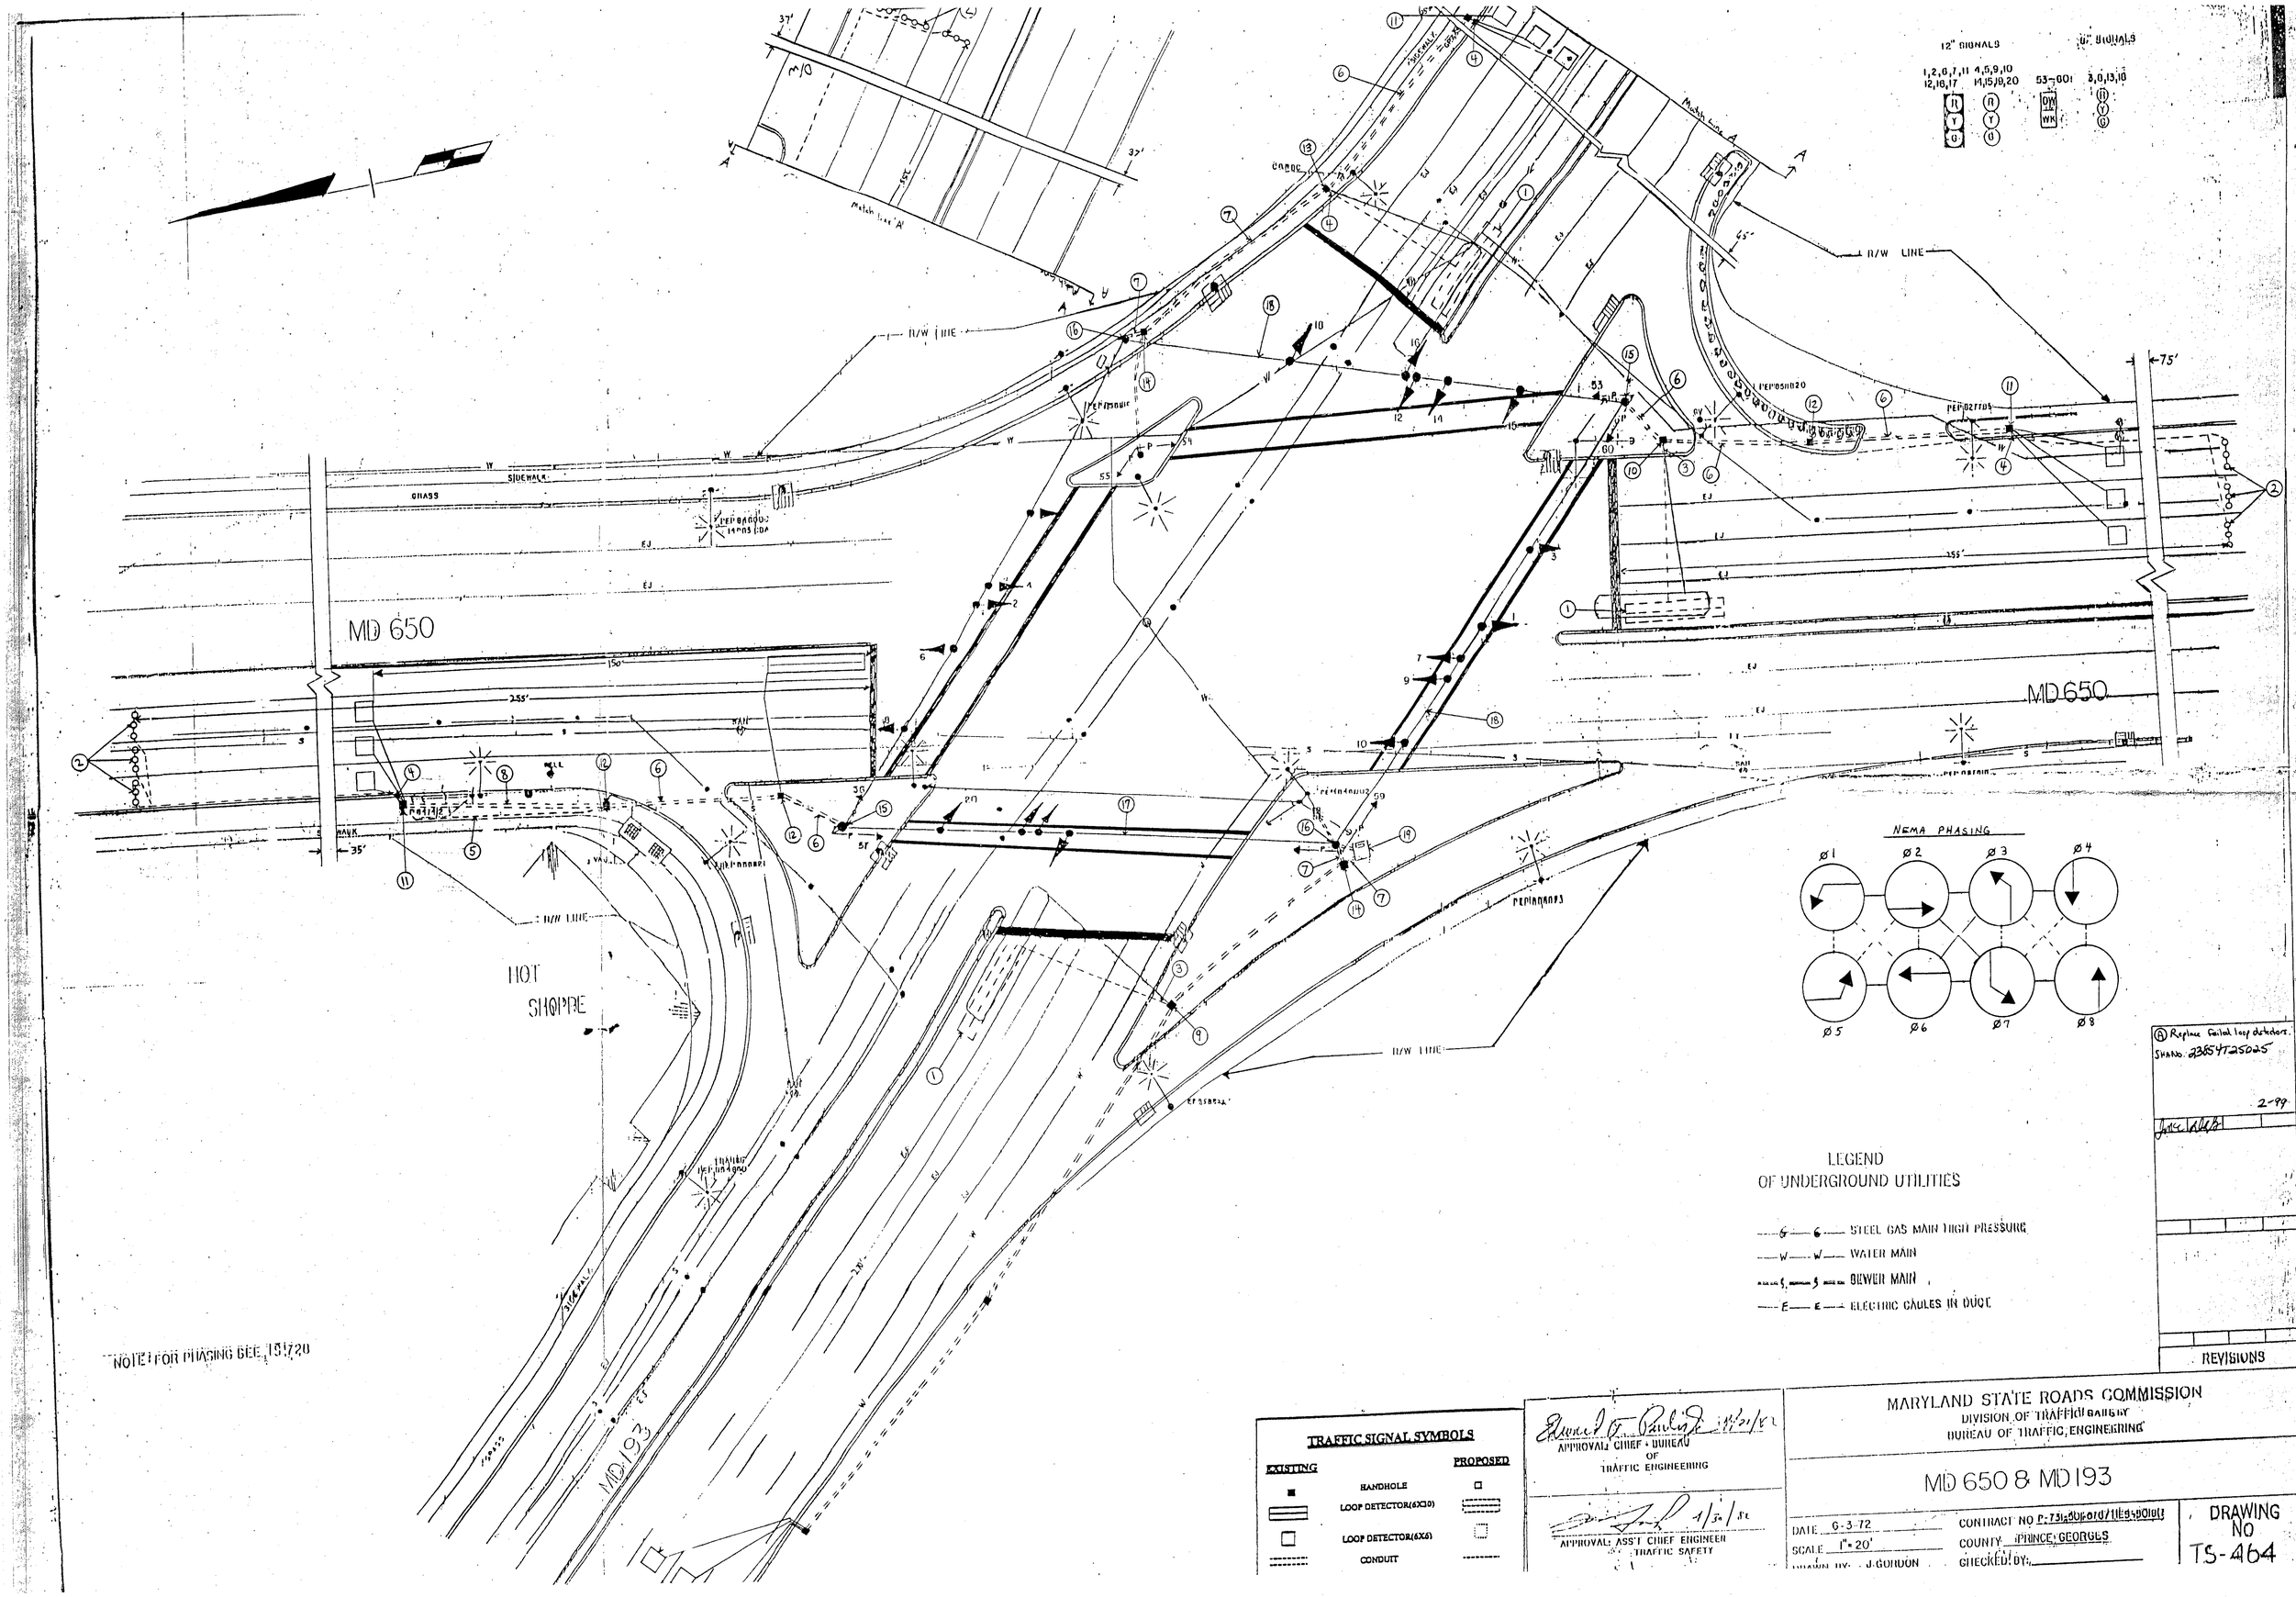

12" SIGNALS
1,2,6,7,11 4,5,9,10
12,16,17 14,15,19,20
53-60
6" SIGNALS
3,8,13,18
R/W LINE
MD 650
MD 650
HOT SHOPPE
MD 193
NEMA PHASING
Ø1
Ø2
Ø3
Ø4
Ø5
Ø6
Ø7
Ø8
LEGEND
OF UNDERGROUND UTILITIES
STEEL GAS MAIN HIGH PRESSURE
WATER MAIN
SEWER MAIN
ELECTRIC CABLES IN DUCT
NOTE: FOR PHASING SEE TS-720
Replace failed loop detectors.
SHA No. 23854T25025
2-99
REVISIONS
TRAFFIC SIGNAL SYMBOLS
EXISTING
PROPOSED
HANDHOLE
LOOP DETECTOR(6X30)
LOOP DETECTOR(6X6)
CONDUIT
APPROVAL: CHIEF - BUREAU OF TRAFFIC ENGINEERING
APPROVAL: ASS'T CHIEF ENGINEER TRAFFIC SAFETY
MARYLAND STATE ROADS COMMISSION
DIVISION OF TRAFFIC SAFETY
BUREAU OF TRAFFIC ENGINEERING
MD 650 & MD 193
DATE 6-3-72
SCALE 1" = 20'
DRAWN BY: J. GORDON
CONTRACT NO
COUNTY PRINCE GEORGES
CHECKED BY:
DRAWING NO
TS-464