F H WA REGION NO	STATE	FED. AID PROJ. NO	SHEET NO.	TOTAL SHEETS
3	MD.			

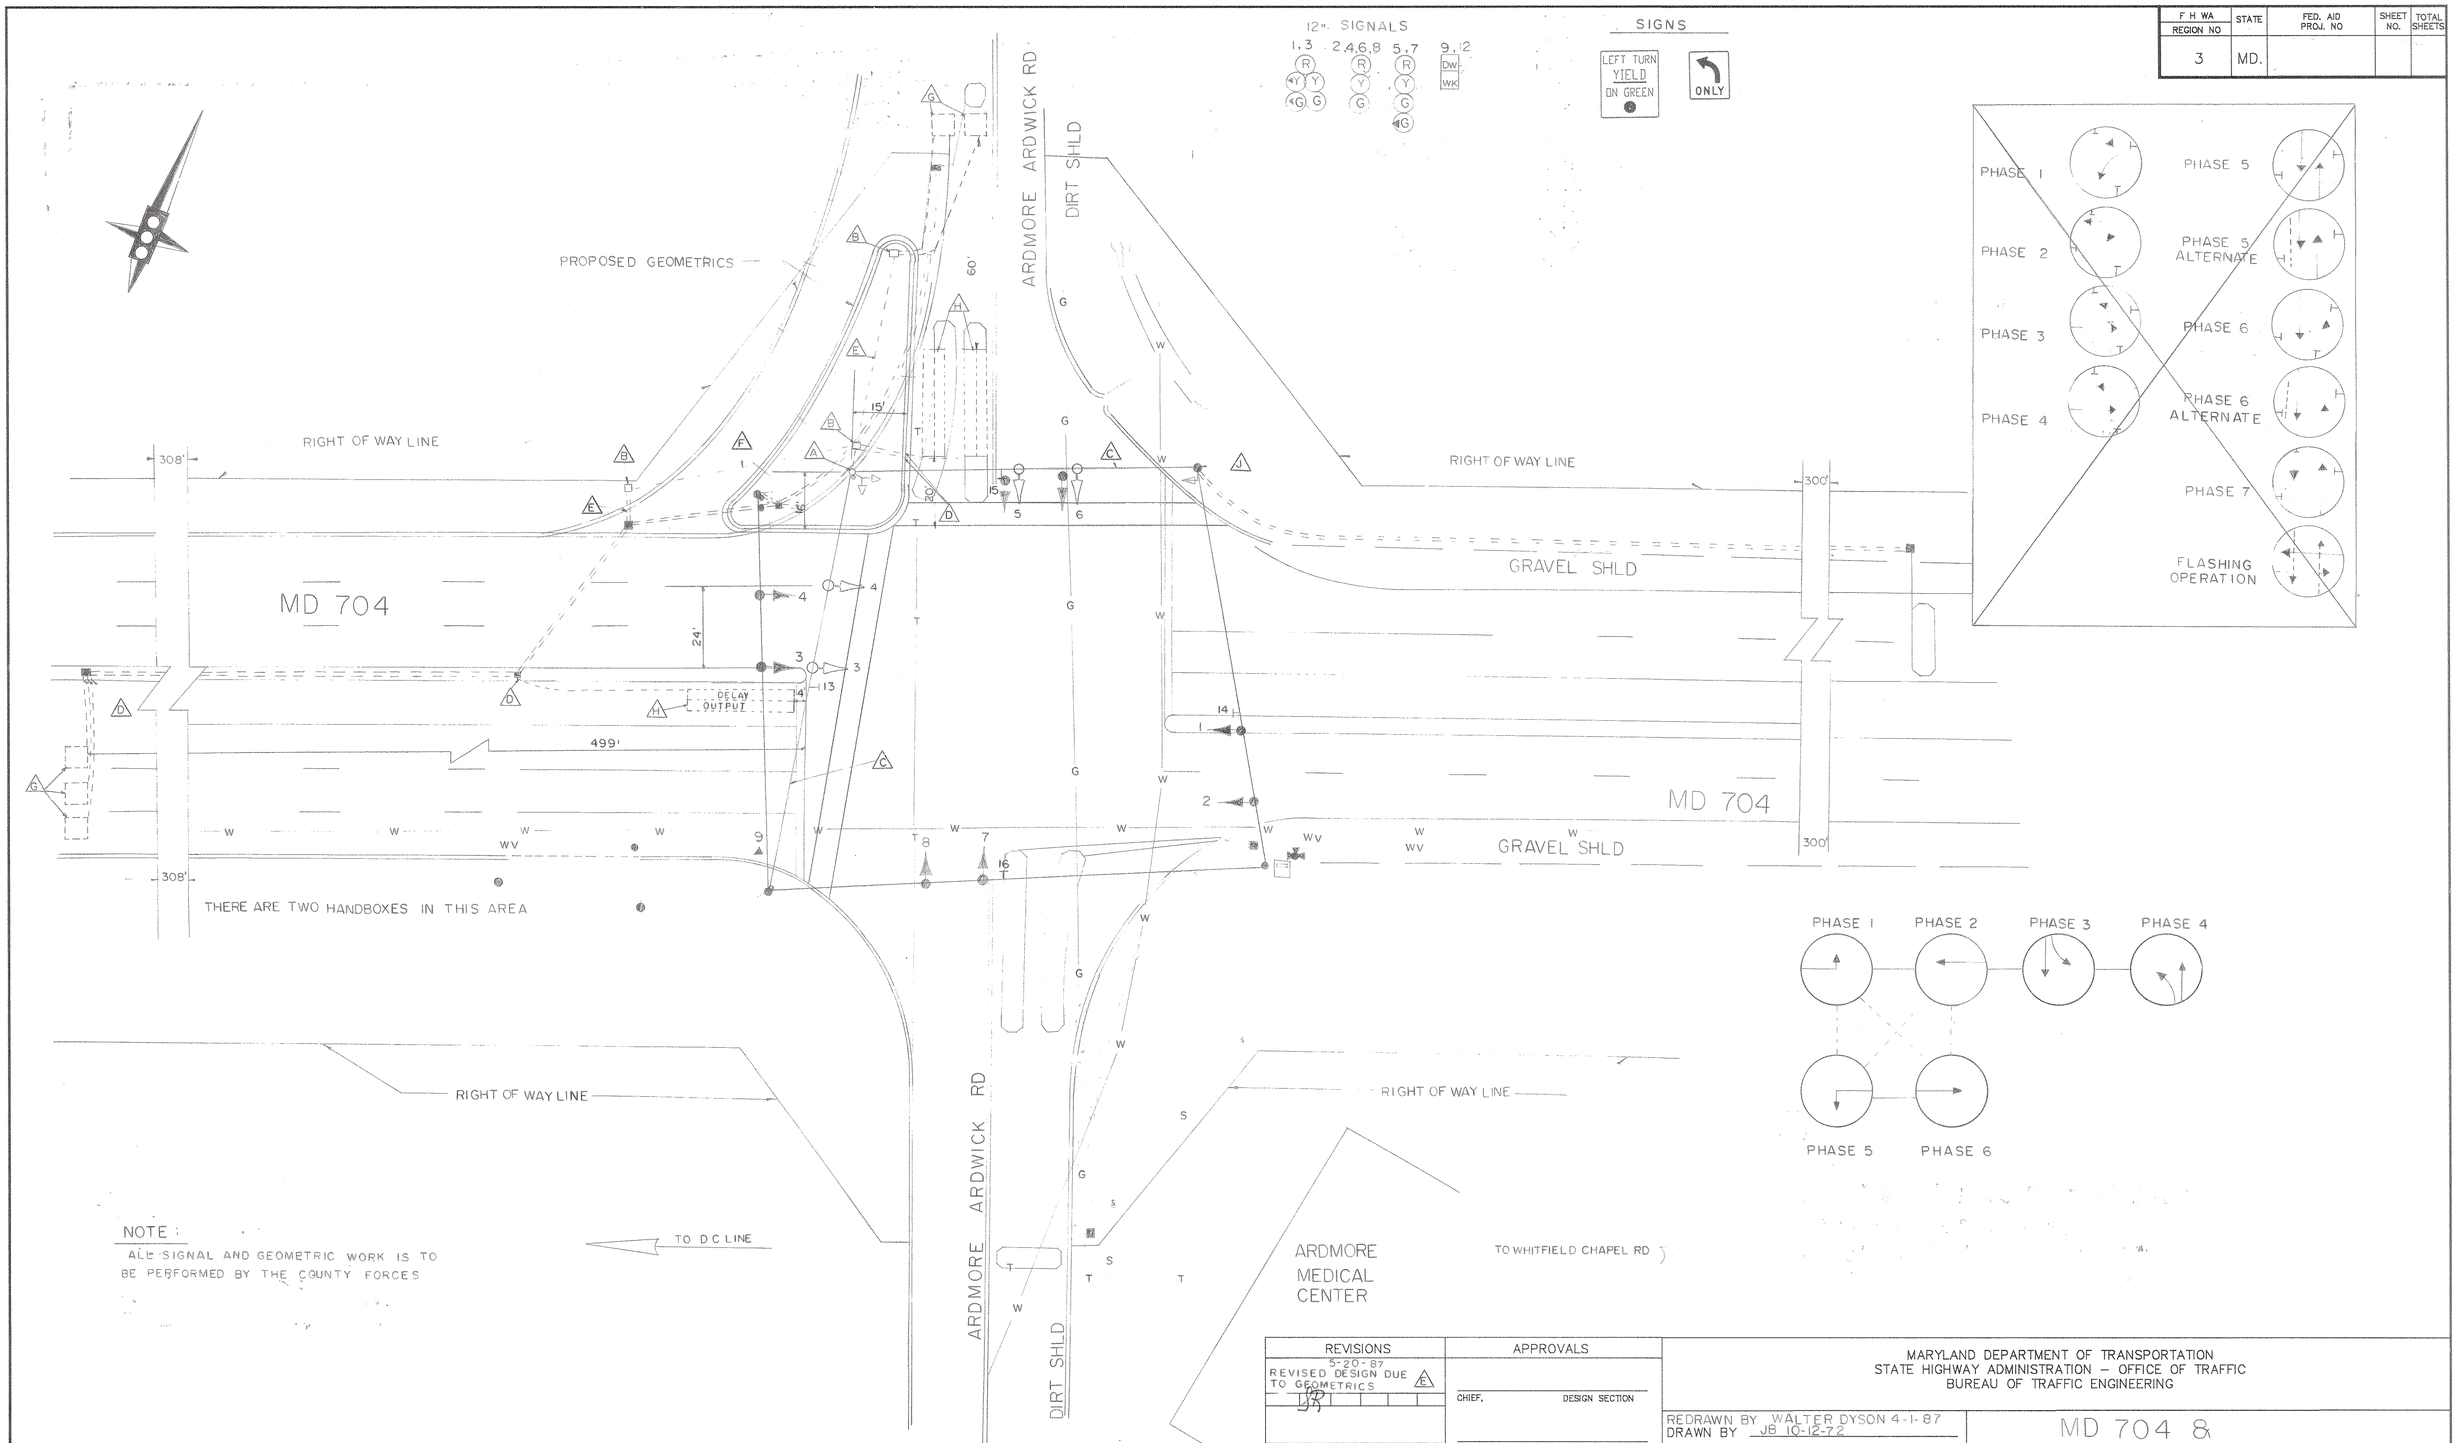

NOTE:
ALL SIGNAL AND GEOMETRIC WORK IS TO BE PERFORMED BY THE COUNTY FORCES

REVISIONS	APPROVALS
5-20-87 REVISED DESIGN DUE TO GEOMETRICS	CHIEF, DESIGN SECTION
	ASST. DISTRICT ENGINEER, TRAFFIC
	CHIEF, BUREAU OF TRAFFIC ENGINEERING
	DEPUTY CHIEF ENGINEER, OFFICE OF TRAFFIC

MARYLAND DEPARTMENT OF TRANSPORTATION
STATE HIGHWAY ADMINISTRATION – OFFICE OF TRAFFIC
BUREAU OF TRAFFIC ENGINEERING

REDRAWN BY WALTER DYSON 4-1-87
DRAWN BY JB 10-12-72
DES. BY: ROBERT W TYSON 10-12-72
CHK. BY: AL BUDNICHUK 10-12-72

MD 704 & ARDMORE ARDWICK RD

COUNTY: PRINCE GEORGES

DATE: ORIG 10-12-72
SCALE: 1" = 20'
F.A.P. NO. M-5025 (2)
S.H.A. NO. P-408-001-385
TS/FILE NO. 549 E
SHEET NO. 17 OF 23

16070404.15