F.H.W.A. REGION NO.	STATE	FED. AID PROJ. NO.	SHEET NO.	TOTAL SHEETS
3	MD.			

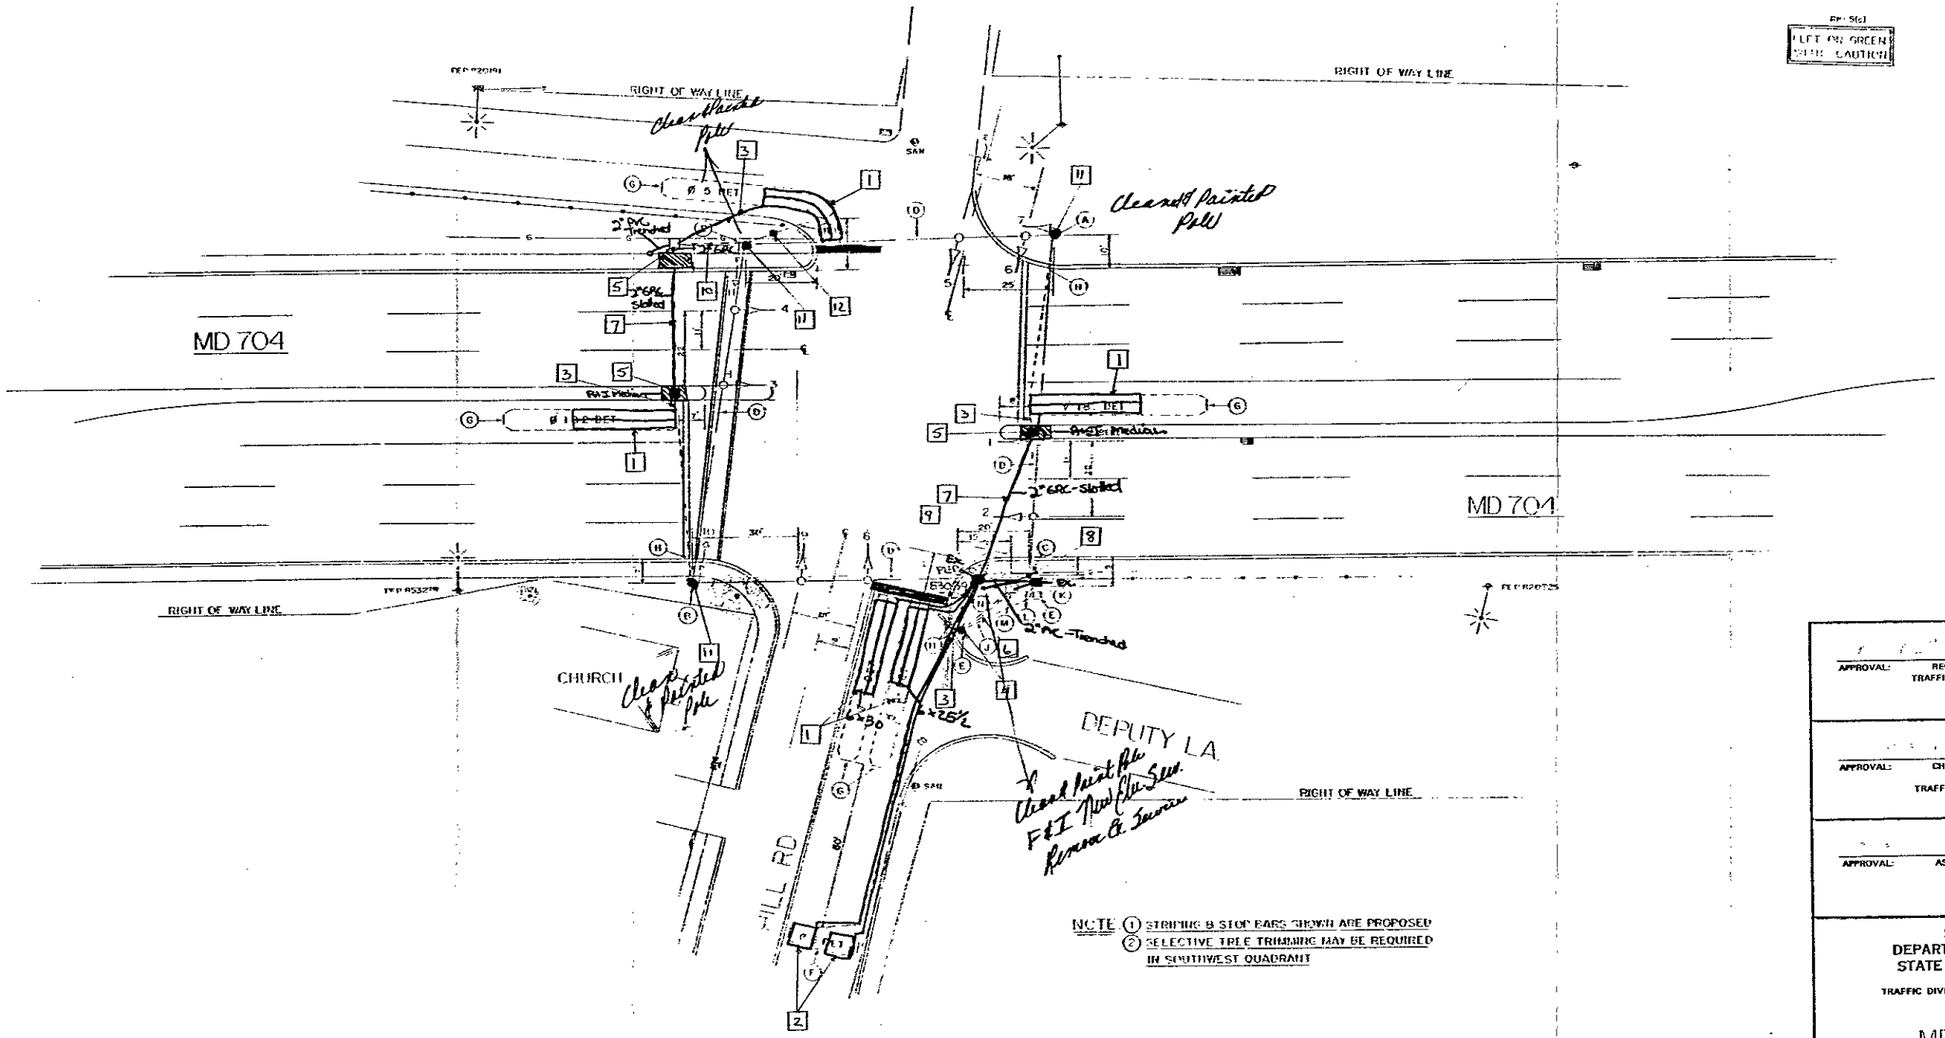

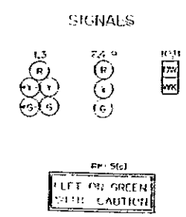

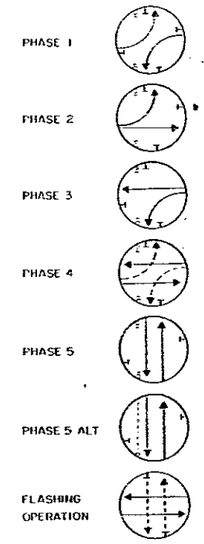

APPROVAL: REGIONAL TRAFFIC ENGINEER

APPROVAL: CHIEF-BUREAU OF TRAFFIC ENGINEERING

APPROVAL: ASST. CHIEF ENGINEER TRAFFIC

REVISIONS

STATE OF MARYLAND
DEPARTMENT OF TRANSPORTATION
STATE HIGHWAY ADMINISTRATION

TRAFFIC DIVISION – BUREAU OF TRAFFIC ENGINEERING

MD 704 & HILL RD

SCALE 1" = 20' DATE 5-19-75 CONTRACT NO. P454X-000-385

DRAWN BY: J. GORDON COUNTY: PRINCE GEORGES

DESIGNED BY: SIGNAL NO.:

CHECKED BY:

DRAWING NO. TS-908

16 090 491.39