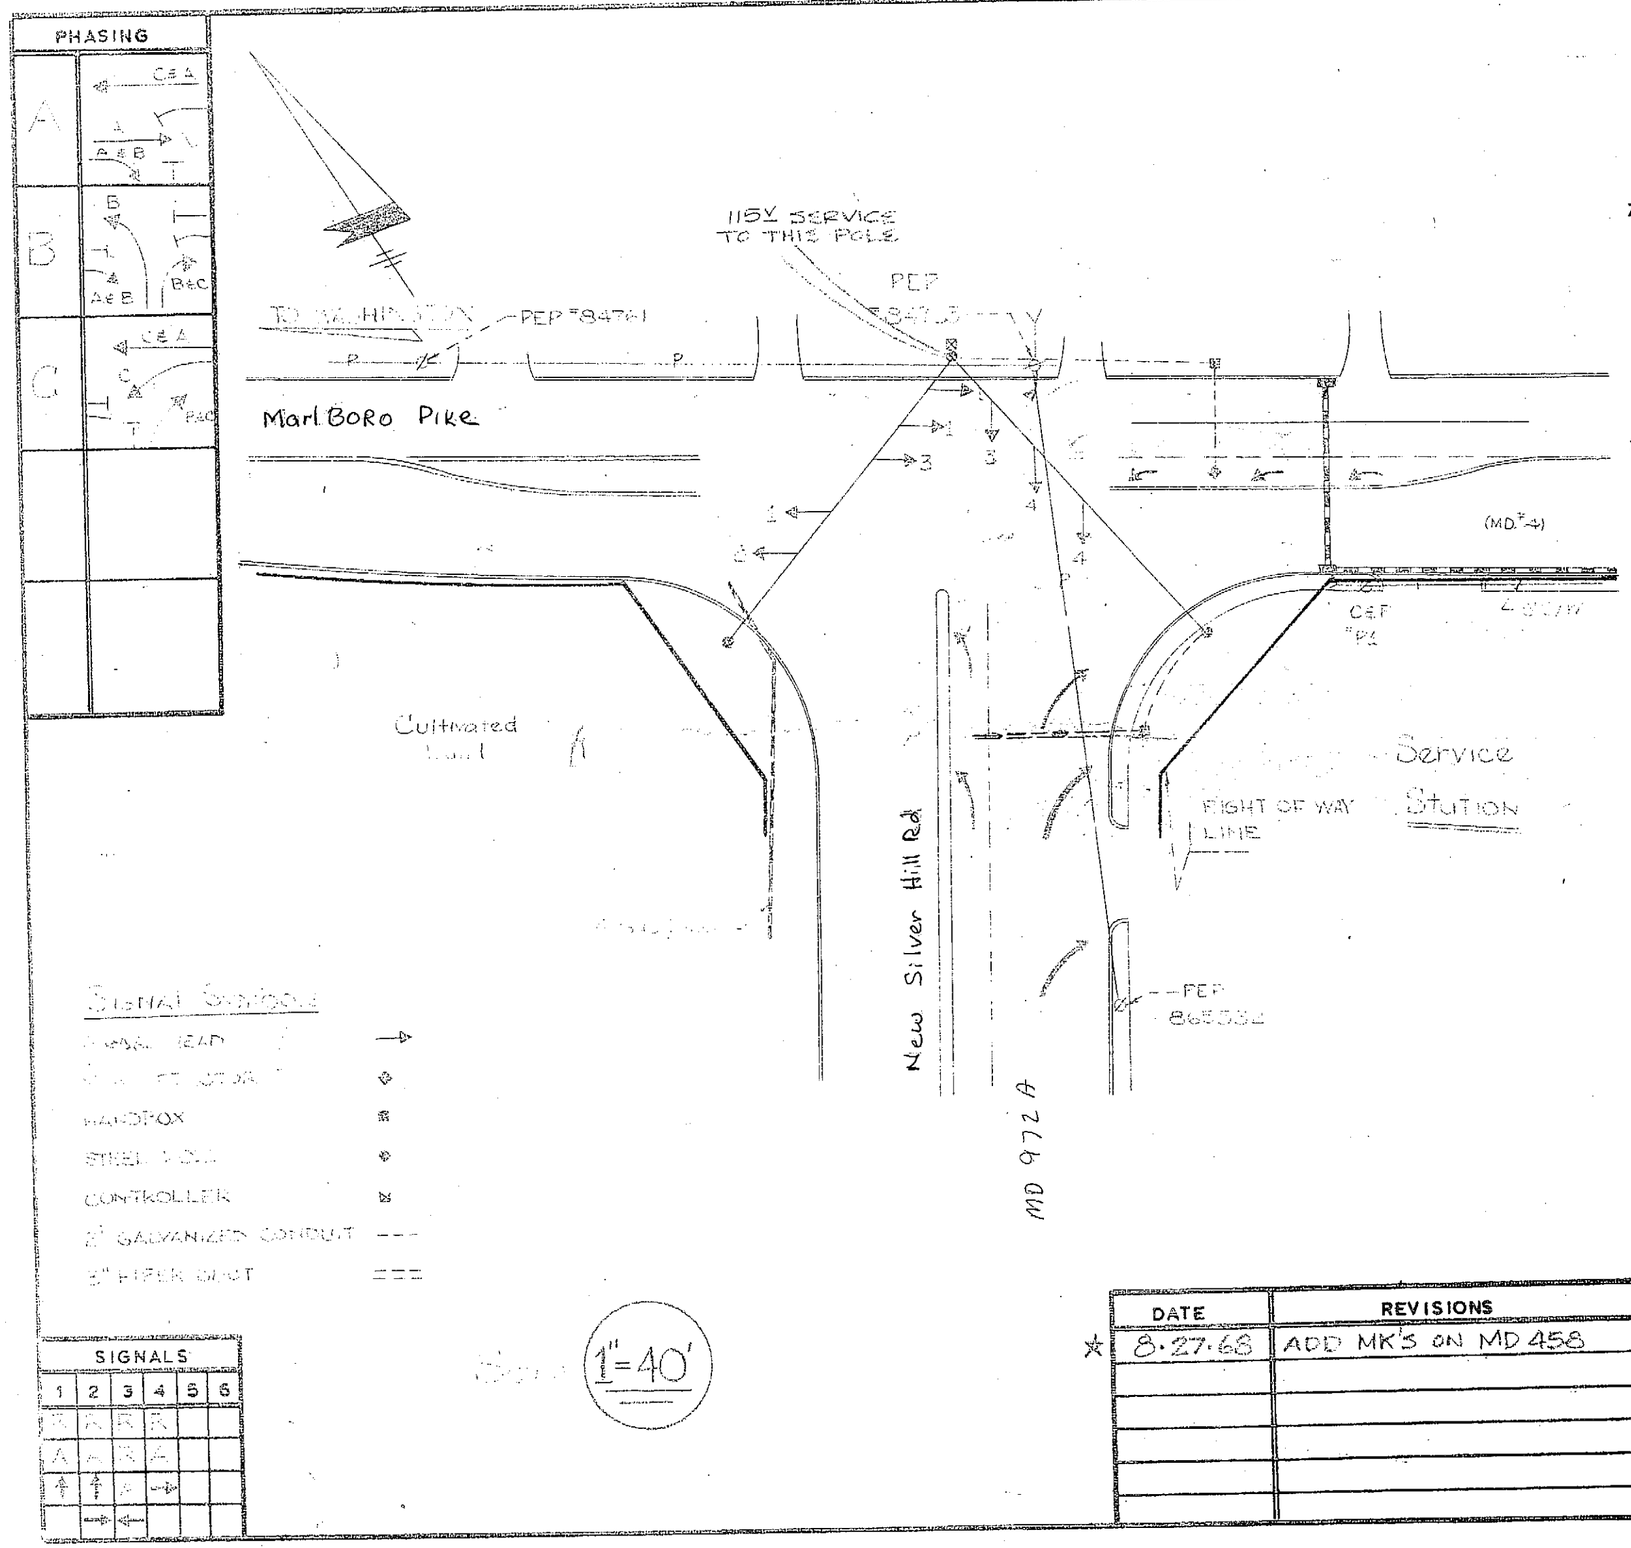

MATERIAL TO BE FURNISHED BY S.R.C.

UNITS	DESCRIPTION
1	1866N CONTROL & CABINET (COMPLETE)
8	AR-4 RELAYS (EXTRA)
3	12"X26' (AOE) STEEL POLES
★ 1	MAGNETIC DETECTORS (MKA)
2	HANDBOXES (FRAME & COVER)
1	GALLON GREEN PAINT
3	1W38 SIGNAL (12" RED-THRU ARROW)
1	1W48 SIGNAL (12" RED-THRU & RIGHT TURN ARROW)
2	1W48 SIGNALS (LEFT TURN ARROW)
2	1W38 SIGNALS (RIGHT TURN ARROW)
★ 2	MAGNETIC DETECTORS (MK)
★ 2	AMPLIFIERS FOR MAGNETIC DETECTORS (MK-10)

SILVER HILL

DATE	REVISIONS
★ 8-27-68	ADD MK'S ON MD 458

MARYLAND STATE ROADS COMMISSION
Bureau of Traffic
ORIGINAL Traffic Signal Installation

Contract No. P-125x-375
Location MARLBORO PIKE AT MD 4 & NEW SILVER HILL ROAD (MD 458)
County PRINCE GEORGE
S.S.No. 2868 TS# 11003
Date JULY 9 1968 Scale 1"=40'