F H WA REGION NO	STATE	FED. AID PROJ. NO	SHEET NO.	TOTAL SHEETS
3	MD.	HES251-1(18)	10	16

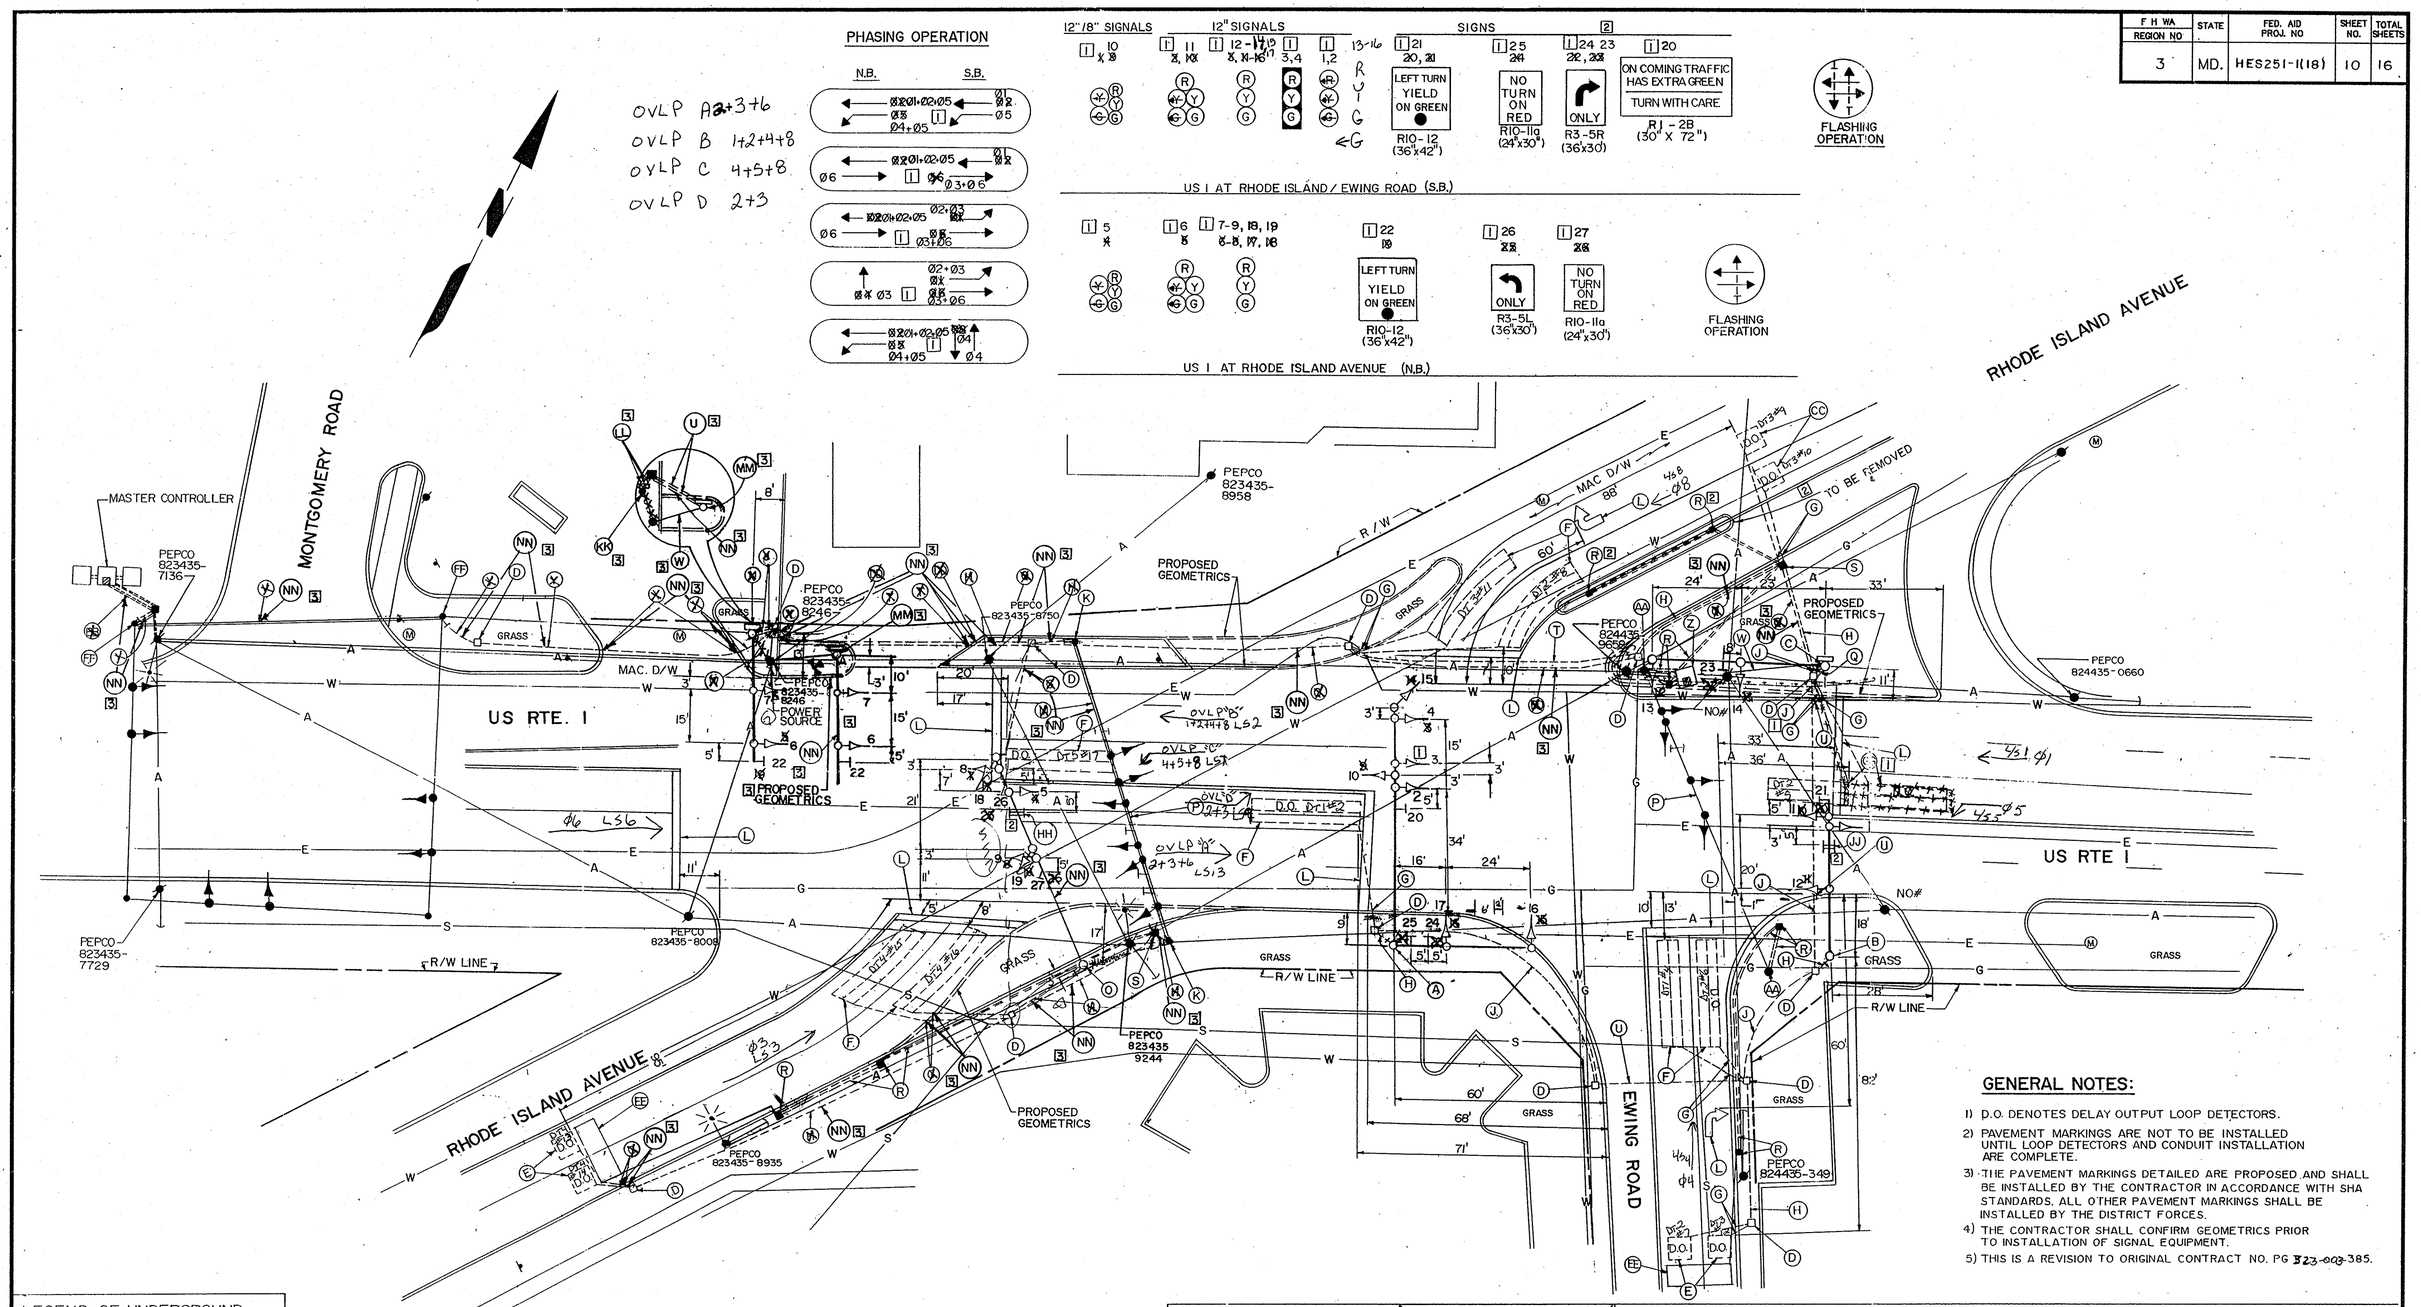

GENERAL NOTES:

1) D.O. DENOTES DELAY OUTPUT LOOP DETECTORS.
2) PAVEMENT MARKINGS ARE NOT TO BE INSTALLED UNTIL LOOP DETECTORS AND CONDUIT INSTALLATION ARE COMPLETE.
3) THE PAVEMENT MARKINGS DETAILED ARE PROPOSED AND SHALL BE INSTALLED BY THE CONTRACTOR IN ACCORDANCE WITH SHA STANDARDS. ALL OTHER PAVEMENT MARKINGS SHALL BE INSTALLED BY THE DISTRICT FORCES.
4) THE CONTRACTOR SHALL CONFIRM GEOMETRICS PRIOR TO INSTALLATION OF SIGNAL EQUIPMENT.
5) THIS IS A REVISION TO ORIGINAL CONTRACT NO. PG 323-003-385.

LEGEND OF UNDERGROUND AND OVERHEAD UTILITIES

AERIAL CABLE — A — A — A — A
ELECTRIC — E — E — E — E
TELEPHONE — T — T — T — T
GAS — G — G — G — G
SEWER — S — S — S — S
WATER — W — W — W — W
CABLE TV — TV — TV — TV — TV

JOHNSON, MIRMIRAN & THOMPSON, P.A.
72 LOVETON CIRCLE
SPARKS, MARYLAND

REVISIONS

P961-501-385 5/27/92
3 REVISION #3
RELOCATED POLE
TS/EMM 5/27/92 TH 6/16

P961-501-385 11/19/91
2 REVISION #2
REVISE SIGNS
EMM

P-961-501-385 10/11/91
1 REVISION #1 EWING L.T. PHASE CHANGED
JMT 12-30-90 EOP REV.

A CONTRACT NO. P-961-501-385/HES251-1(18) SIGNAL MODIFICATION DUE TO H.S. INTERSECTION IMPROVEMENTS.

TMS/MCE 6/16

APPROVALS

CHIEF, SIGNAL DESIGN SECTION
ASST. DISTRICT ENGINEER, TRAFFIC
CHIEF, TRAFFIC ENGINEERING DIVISION
DEPUTY CHIEF ENGINEER, TRAFFIC

THIS IS A REVISION TO ORIGINAL CONTRACT

MDOT – STATE HIGHWAY ADMINISTRATION

Office of Traffic

TRAFFIC ENGINEERING DIVISION

ORIGINAL INFORMATION

DRAWN BY: R.RILEY
DES. BY: R.RILEY
CHK. BY:

US RTE I AT RHODE ISLAND AVE. AND EWING RD.
AND INTERCONNECTION TO US RTE I AT MONTGOMERY ROAD
SIGNAL NO. 16000107.46
COUNTY: PRINCE GEORGE'S

DATE: 10-21-73
SCALE: 1" = 20'
F.A.P. NO. U-902-1 (22)
S.H.A. NO. P-323-003-385
TS/STD. NO. 1057A
SHEET NO. ___ OF ___