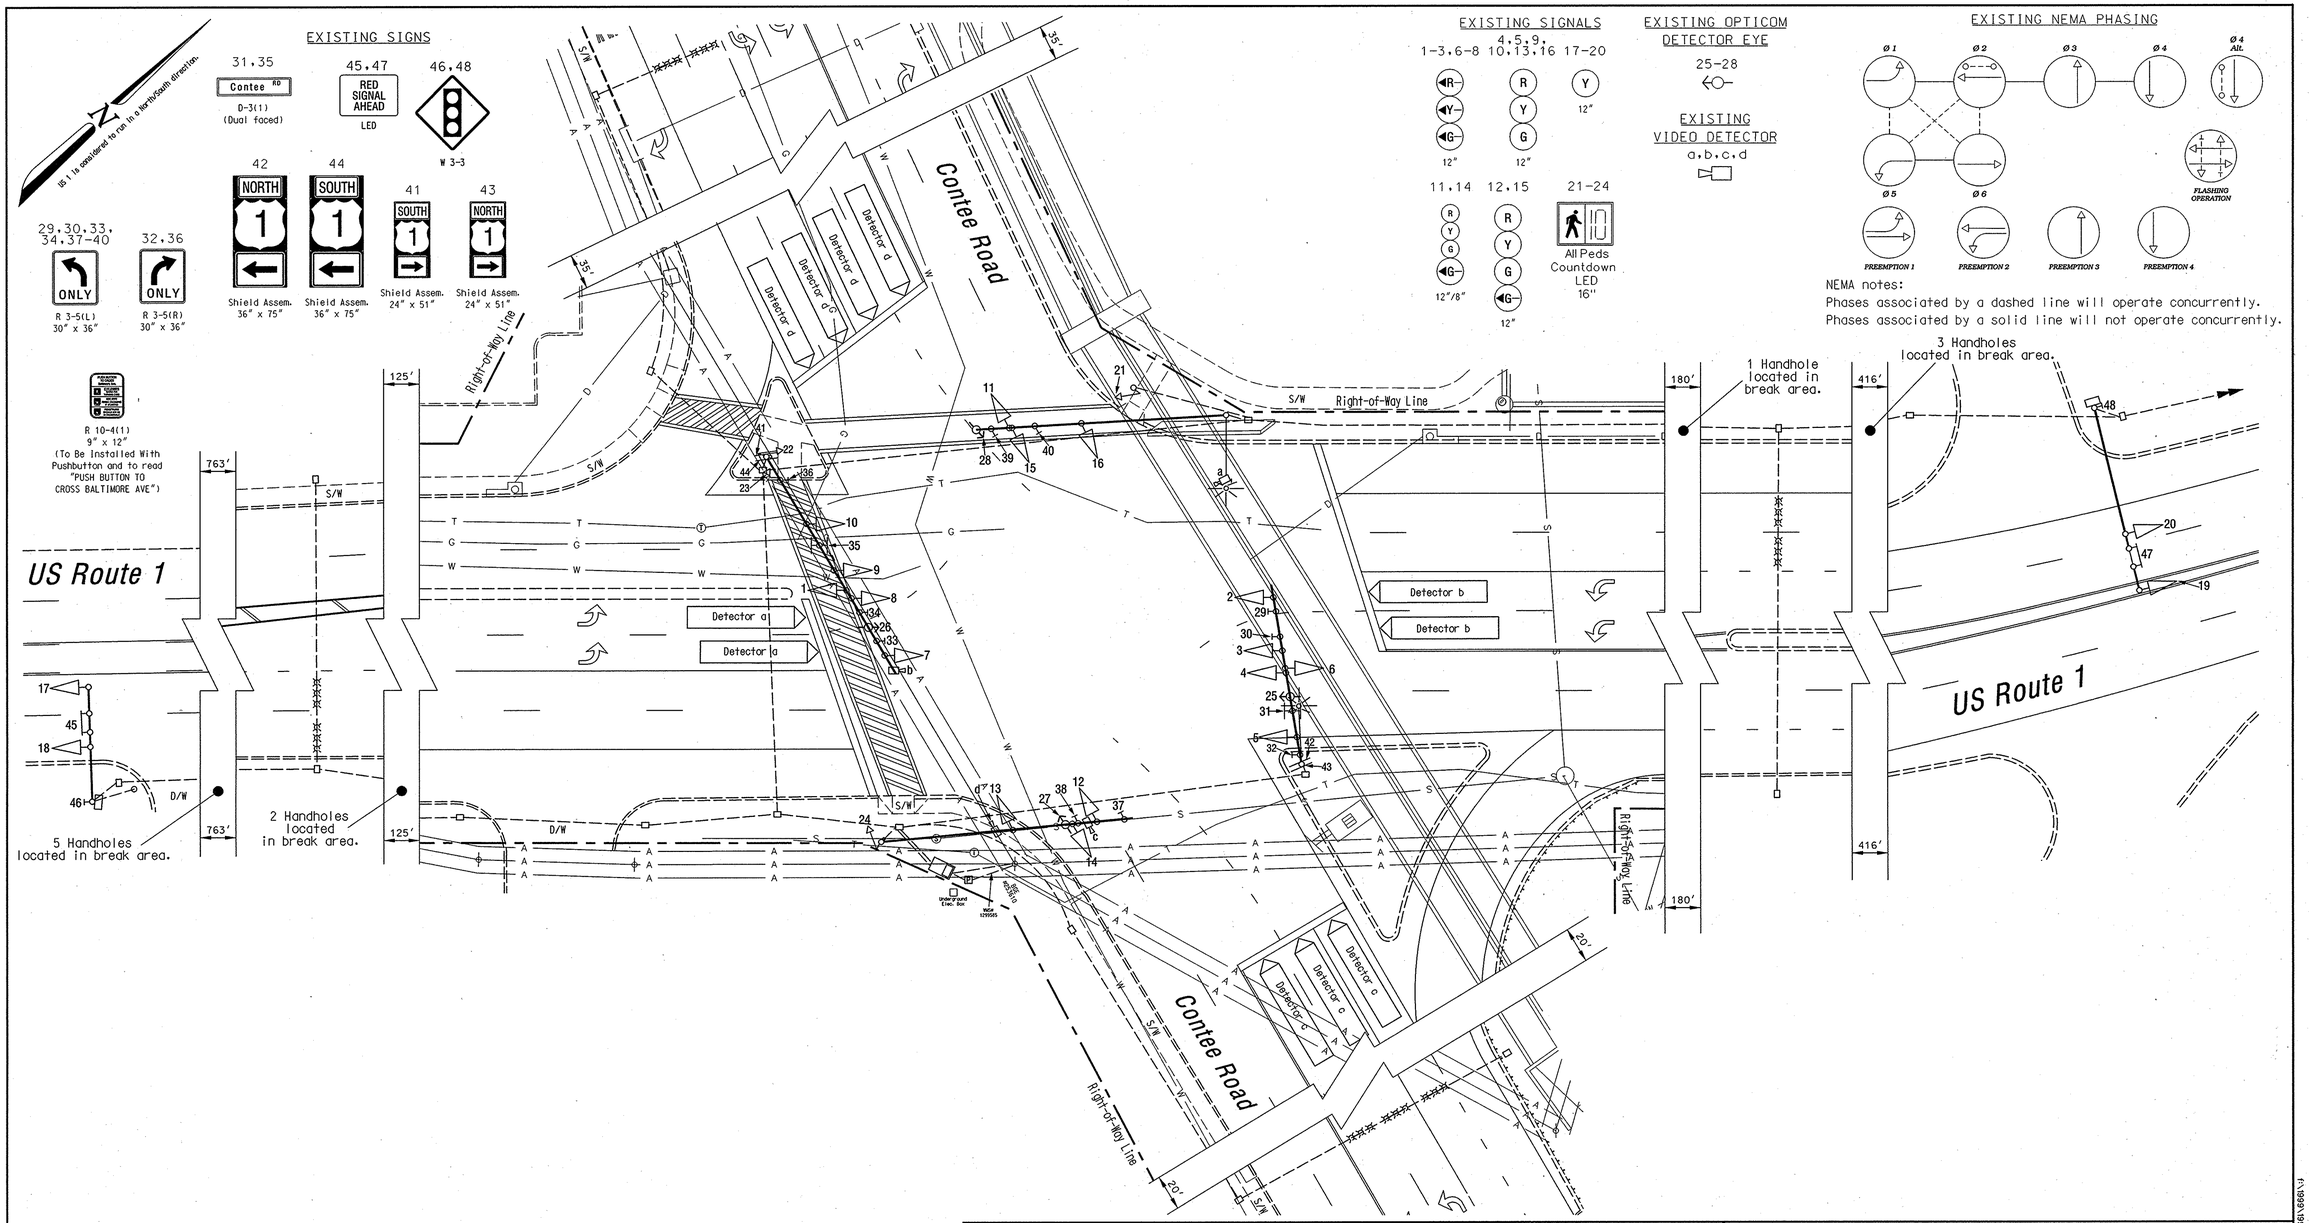

GEOMETRIC LEGEND

EXISTING GEOMETRICS

PROPOSED GEOMETRICS

UTILITY LEGEND

G	GAS MAIN
W	WATER MAIN
S	SEWER MAIN
E	ELECTRIC CABLES
D	STORM DRAIN
A	AERIAL CABLES
T	TELEPHONE CABLES

As-Built

The Traffic Group

The Traffic Group, Inc.
410-931-6600
Fax 410-931-6601

REVISIONS

E	Install Opticom Detector Eye NB and SB US 1.	2/00
MR		
F	Install Opticom Detector Eye EB and WB Contee Road.	11/15/04
DJD		
G	Reconstruct Traffic Signal due to Geometric Widening. BW936M82	5/20/05
JES		
H	As-Built	8/03/06
SED		

APPROVALS

ORIGINAL ON FILE

TEAM LEADER, TRAFFIC ENGINEERING DESIGN DIVISION

ASST. CHIEF TRAFFIC ENGINEERING DESIGN DIVISION

CHIEF, TRAFFIC ENGINEERING DESIGN DIVISION

DIRECTOR, TRAFFIC & SAFETY

MARYLAND DOT - STATE HIGHWAY ADMINISTRATION

Office of Traffic & Safety

TRAFFIC ENGINEERING DESIGN DIVISION

(Traffic Signal Plan)

US Route 1 at Contee Road

DRAWN BY:	F.A.P. NO. N/A	TS NO. 1536G	SHEET NO.
CHECKED BY:	S.H.A. NO. XX1005185		
SCALE: 1" = 20'	COUNTY: Prince George's	T.I.M.S. NO. F-750	1 OF 1
DATE:	LOG MILE: 16000111.49		

f:\1999\1999-0913A\dea\48-signlan-final.dgn 8/7/2006