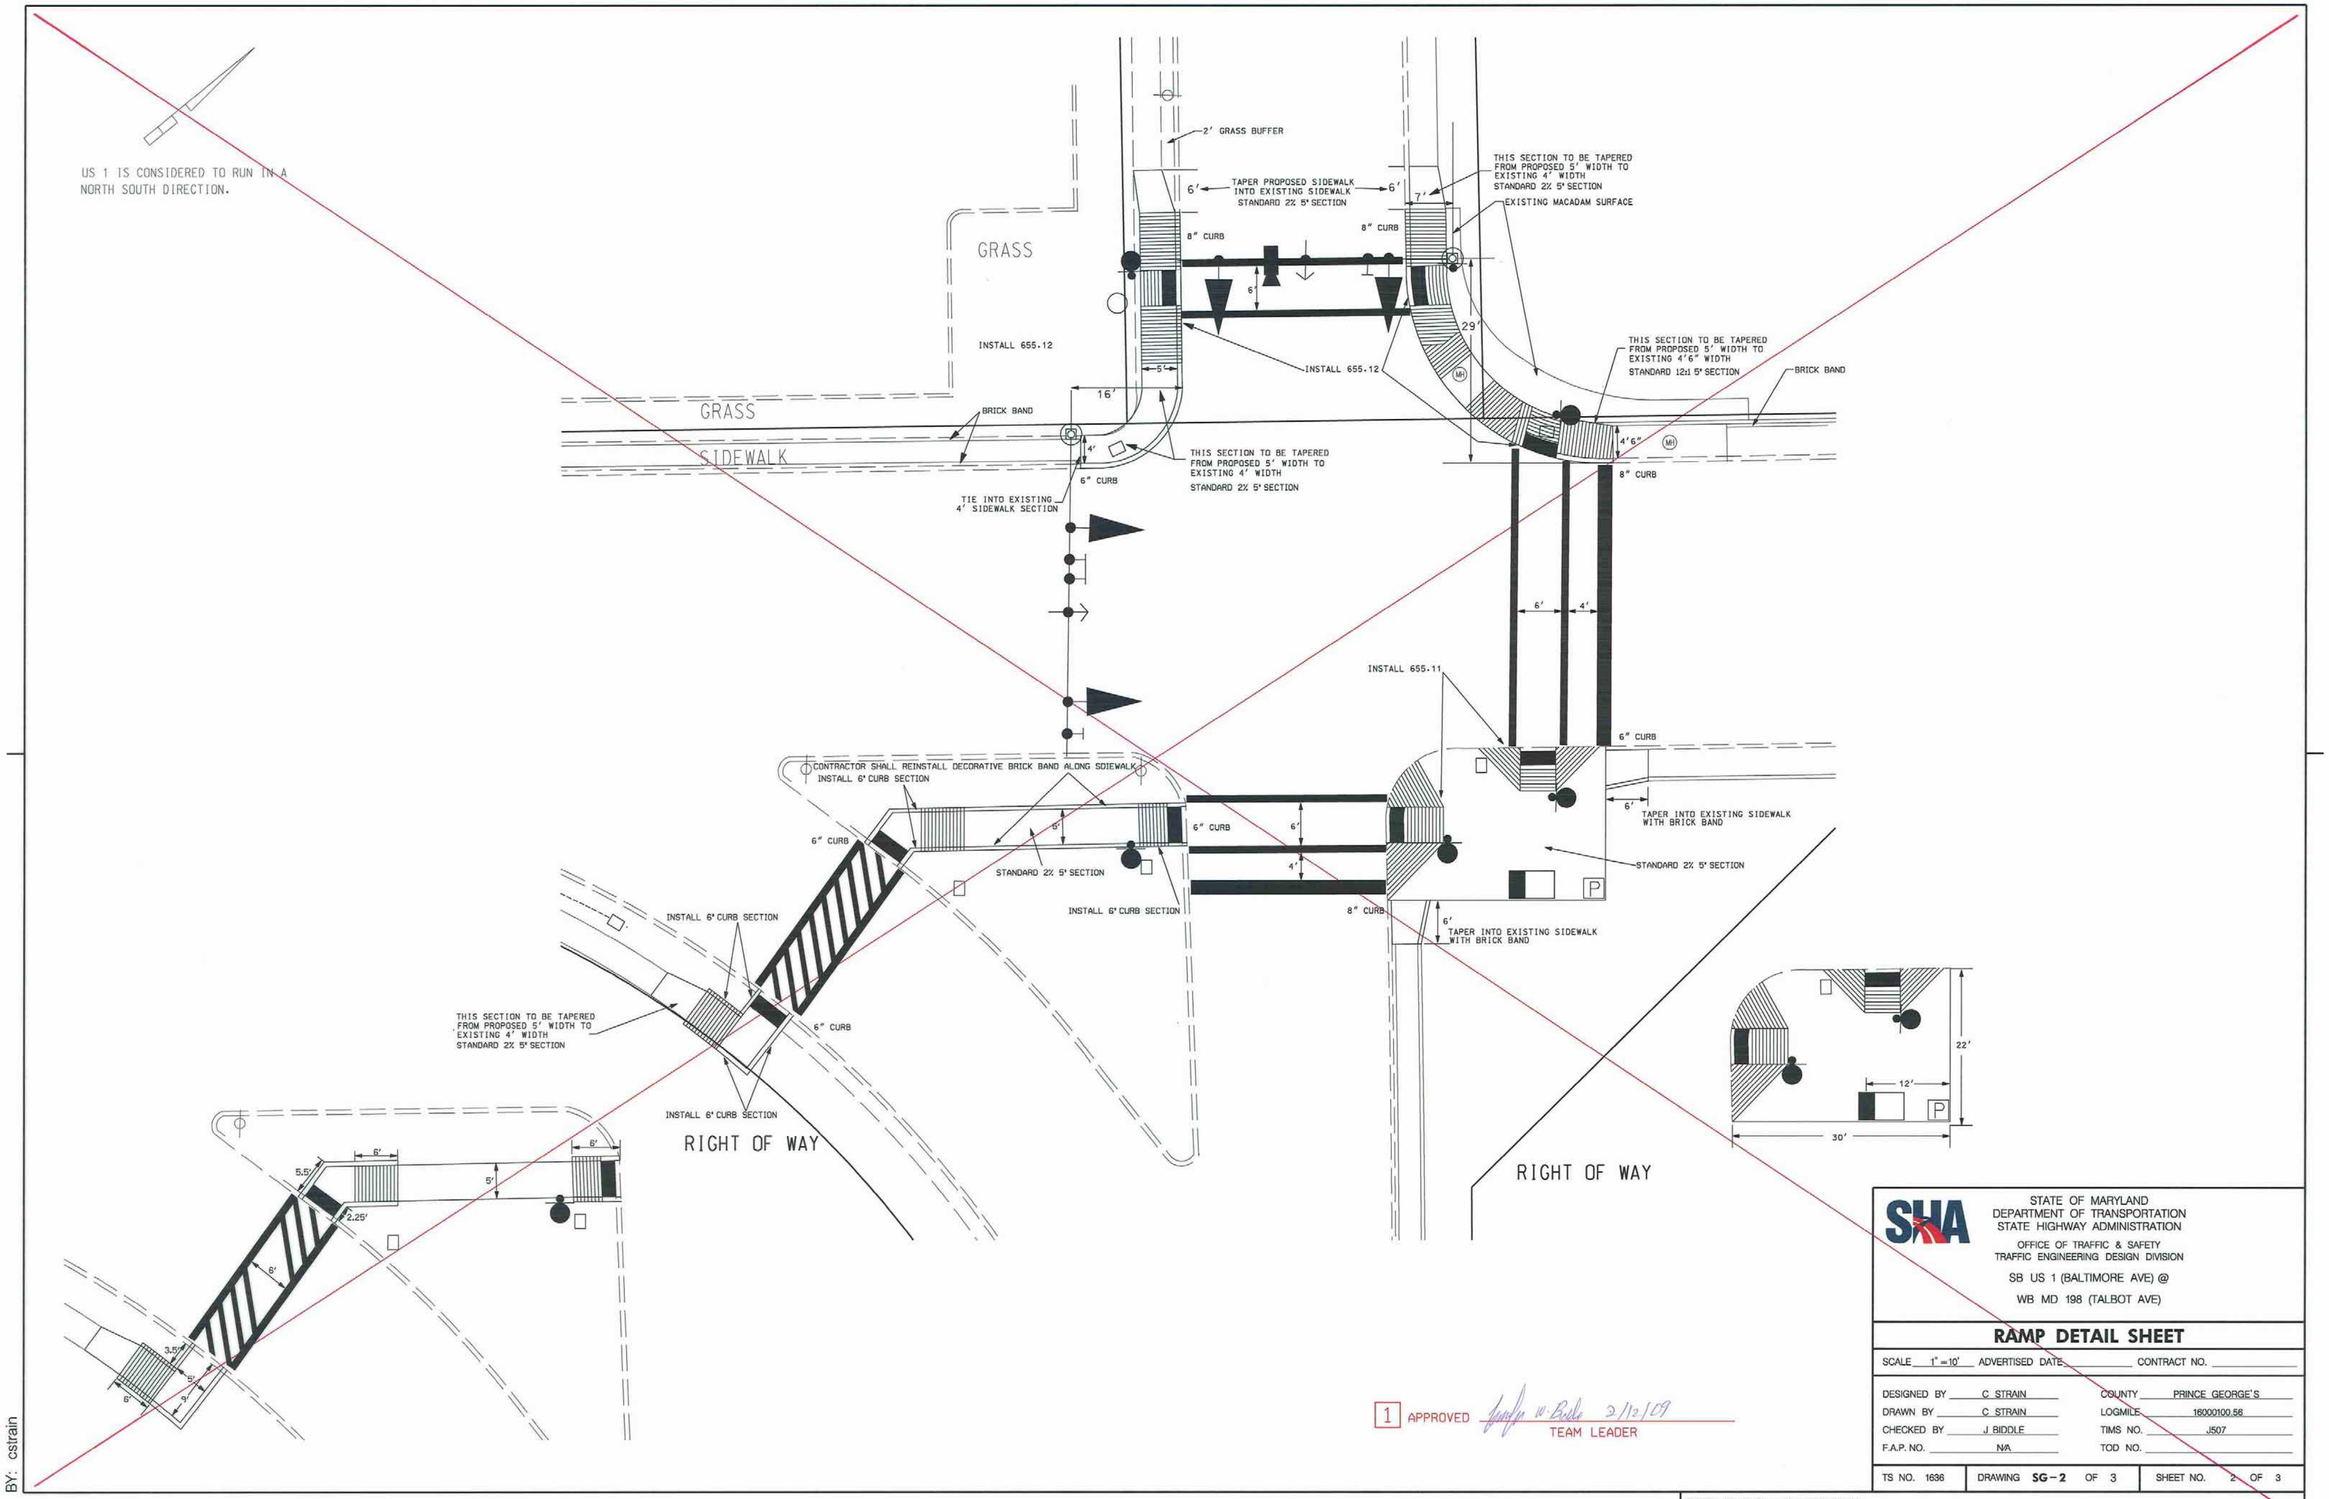

STATE OF MARYLAND
DEPARTMENT OF TRANSPORTATION
STATE HIGHWAY ADMINISTRATION

OFFICE OF TRAFFIC & SAFETY
TRAFFIC ENGINEERING DESIGN DIVISION

SB US 1 (BALTIMORE AVE) @

WB MD 198 (TALBOT AVE)

RAMP DETAIL SHEET

SCALE 1" = 10' ADVERTISED DATE _____ CONTRACT NO. _____

DESIGNED BY	C. STRAIN	COUNTY	PRINCE GEORGE'S
DRAWN BY	C. STRAIN	LOGMILE	16000100.56
CHECKED BY	J. BIDDLE	TIMS NO.	J507
F.A.P. NO.	N/A	TOD NO.	

TS NO. 1636	DRAWING SG-2 OF 3	SHEET NO. 2 OF 3

1 APPROVED Jeffrey W. Biddle 2/12/09
TEAM LEADER

PLOTTED: Thursday, February 12, 2009 AT 02:03 PM
FILE: M:\Designs\District 3\SB US 1 @ WB MD 198-Pole Replace\US 1 @ Talbott Backup Working-Redline.dgn

BY: cstrain