K&E BALTIMORE 17 0153 PHOENIX 10-75 MC 4186

F.H.W.A. REGION NO.	STATE	FED. AID PROJ. NO.	SHEET NO.	TOTAL SHEETS
3	MD.	TQF U251 1(7)	12	24

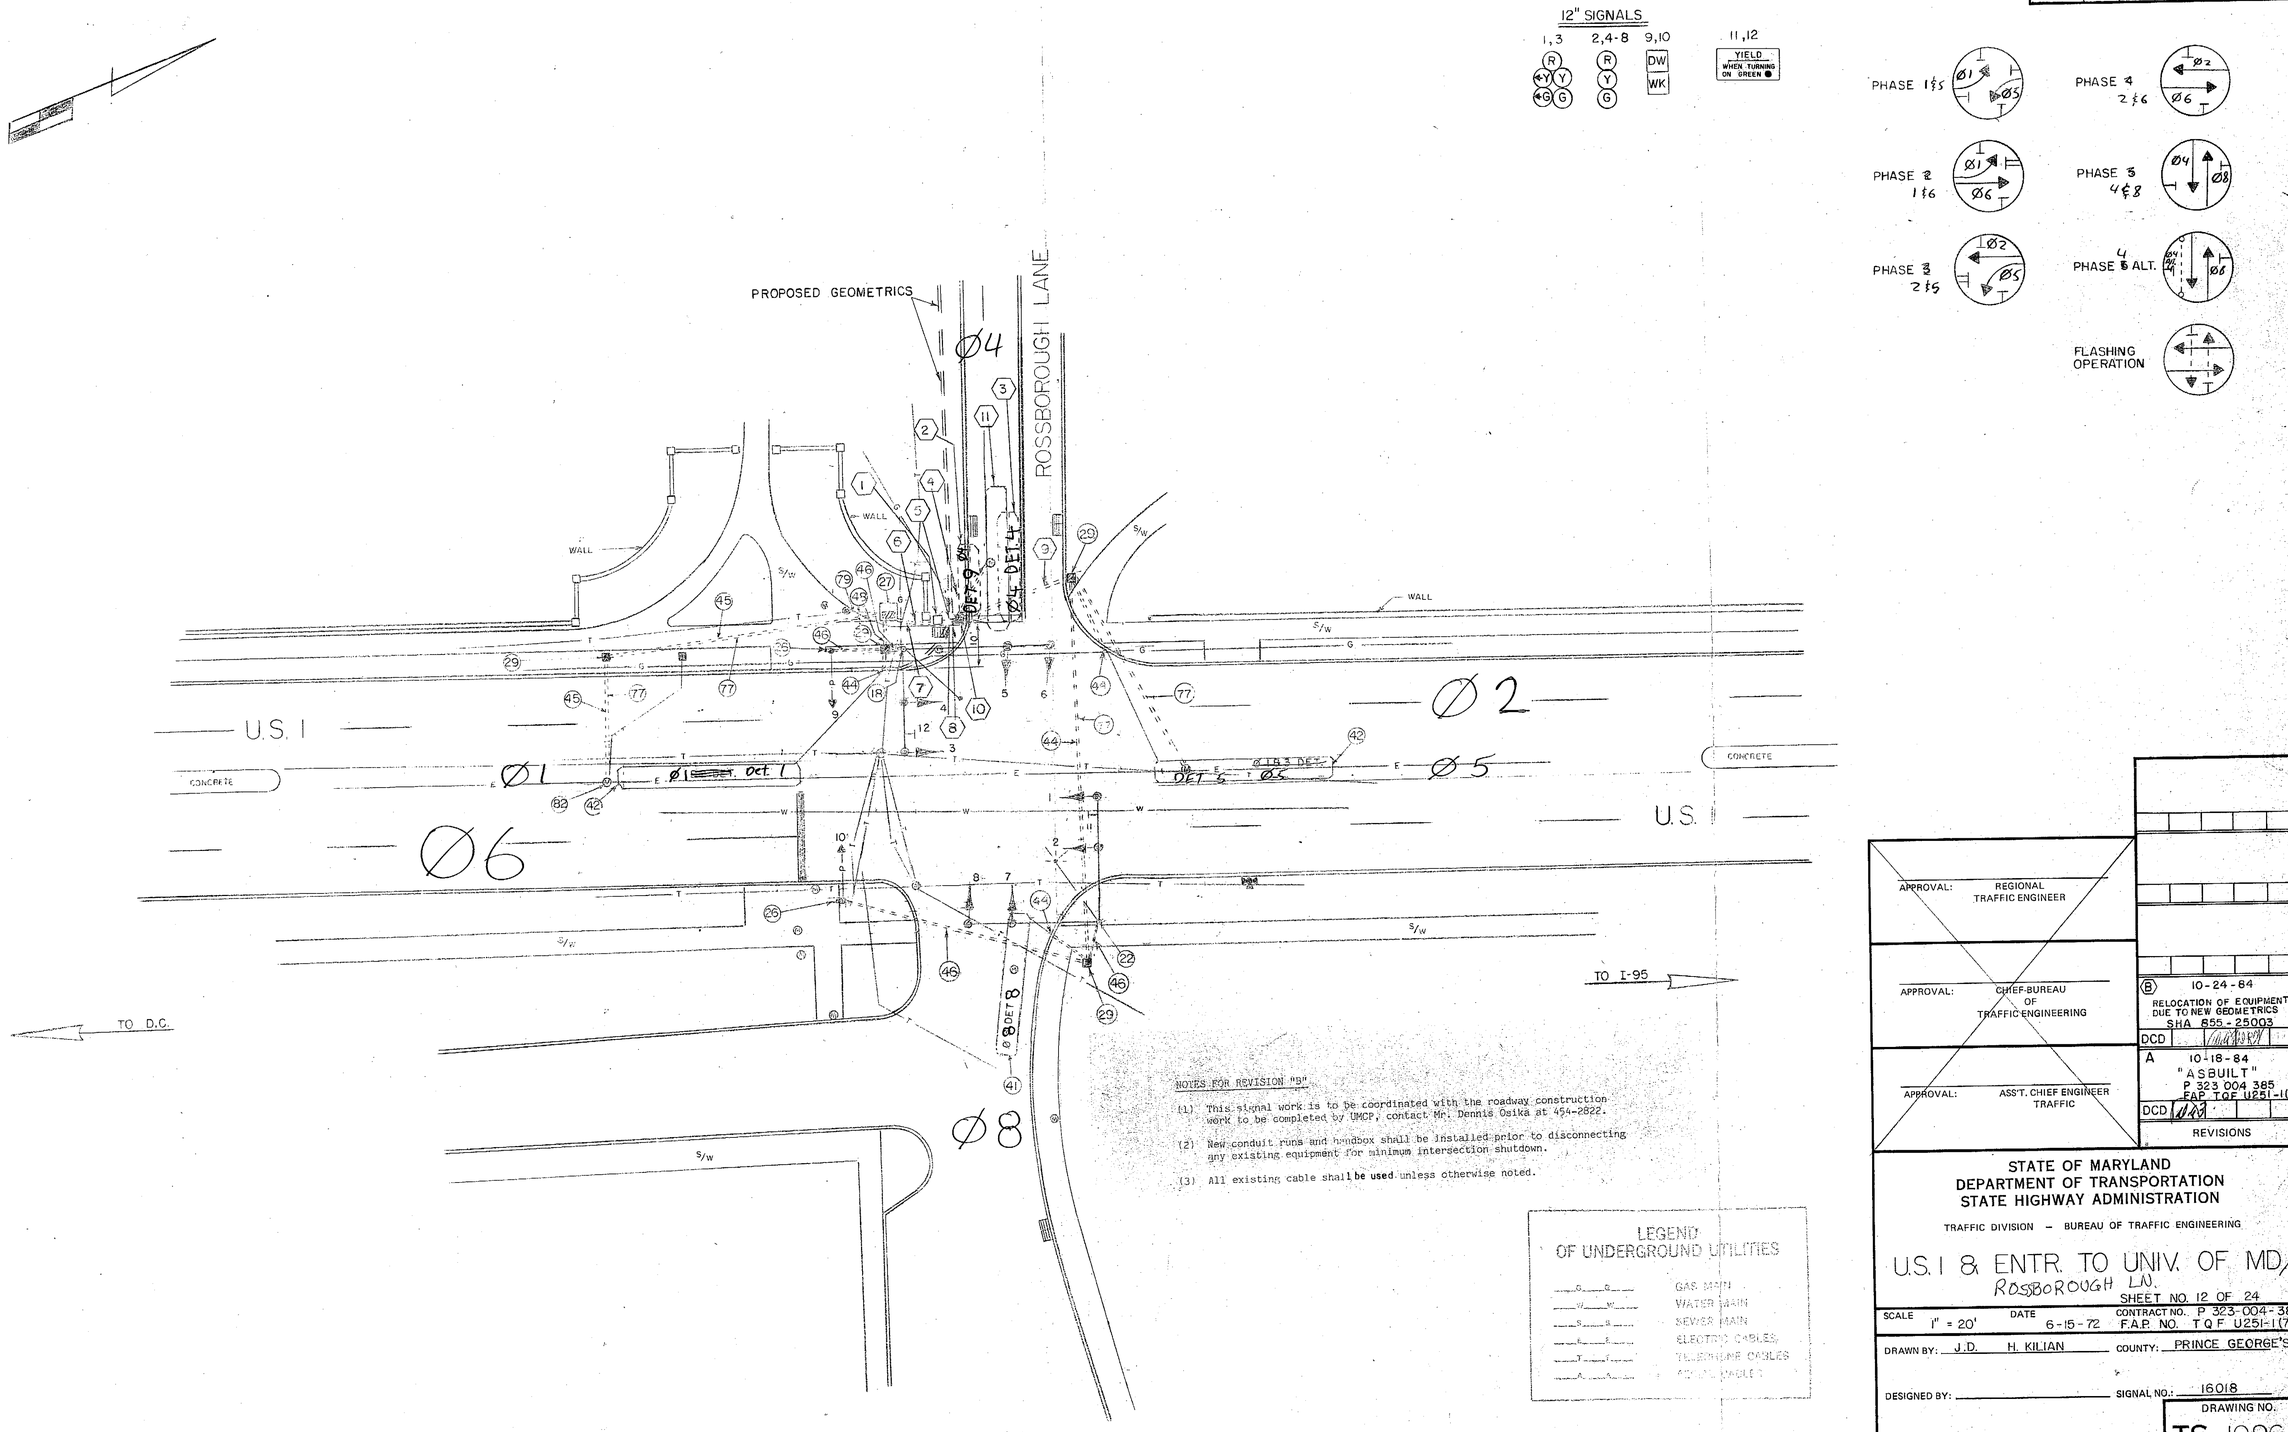

APPROVAL: REGIONAL TRAFFIC ENGINEER

APPROVAL: CHIEF BUREAU OF TRAFFIC ENGINEERING

APPROVAL: ASS'T. CHIEF ENGINEER TRAFFIC

REVISIONS	
B	10-24-84 RELOCATION OF EQUIPMENT DUE TO NEW GEOMETRICS SHA 855-25003
DCD	
A	10-18-84 "ASBUILT" P 323 004 385 FAP TQF U251-1(7)
DCD	

STATE OF MARYLAND
DEPARTMENT OF TRANSPORTATION
STATE HIGHWAY ADMINISTRATION

TRAFFIC DIVISION – BUREAU OF TRAFFIC ENGINEERING

U.S. 1 & ENTR. TO UNIV. OF MD/ ROSSBOROUGH LN.

SHEET NO. 12 OF 24

SCALE 1" = 20' | DATE 6-15-72 | CONTRACT NO. P 323-004-385 | F.A.P. NO. T Q F U251-1(7)

DRAWN BY: J.D. H. KILIAN | COUNTY: PRINCE GEORGE'S

DESIGNED BY: | SIGNAL NO.: 16018

CHECKED BY:

DRAWING NO. TS-1096