F.H.W.A. REGION NO.	STATE	FED. AID PROJ. NO.	SHEET NO.	TOTAL SHEETS
3	MD.	F-144-1-(6)	4	4

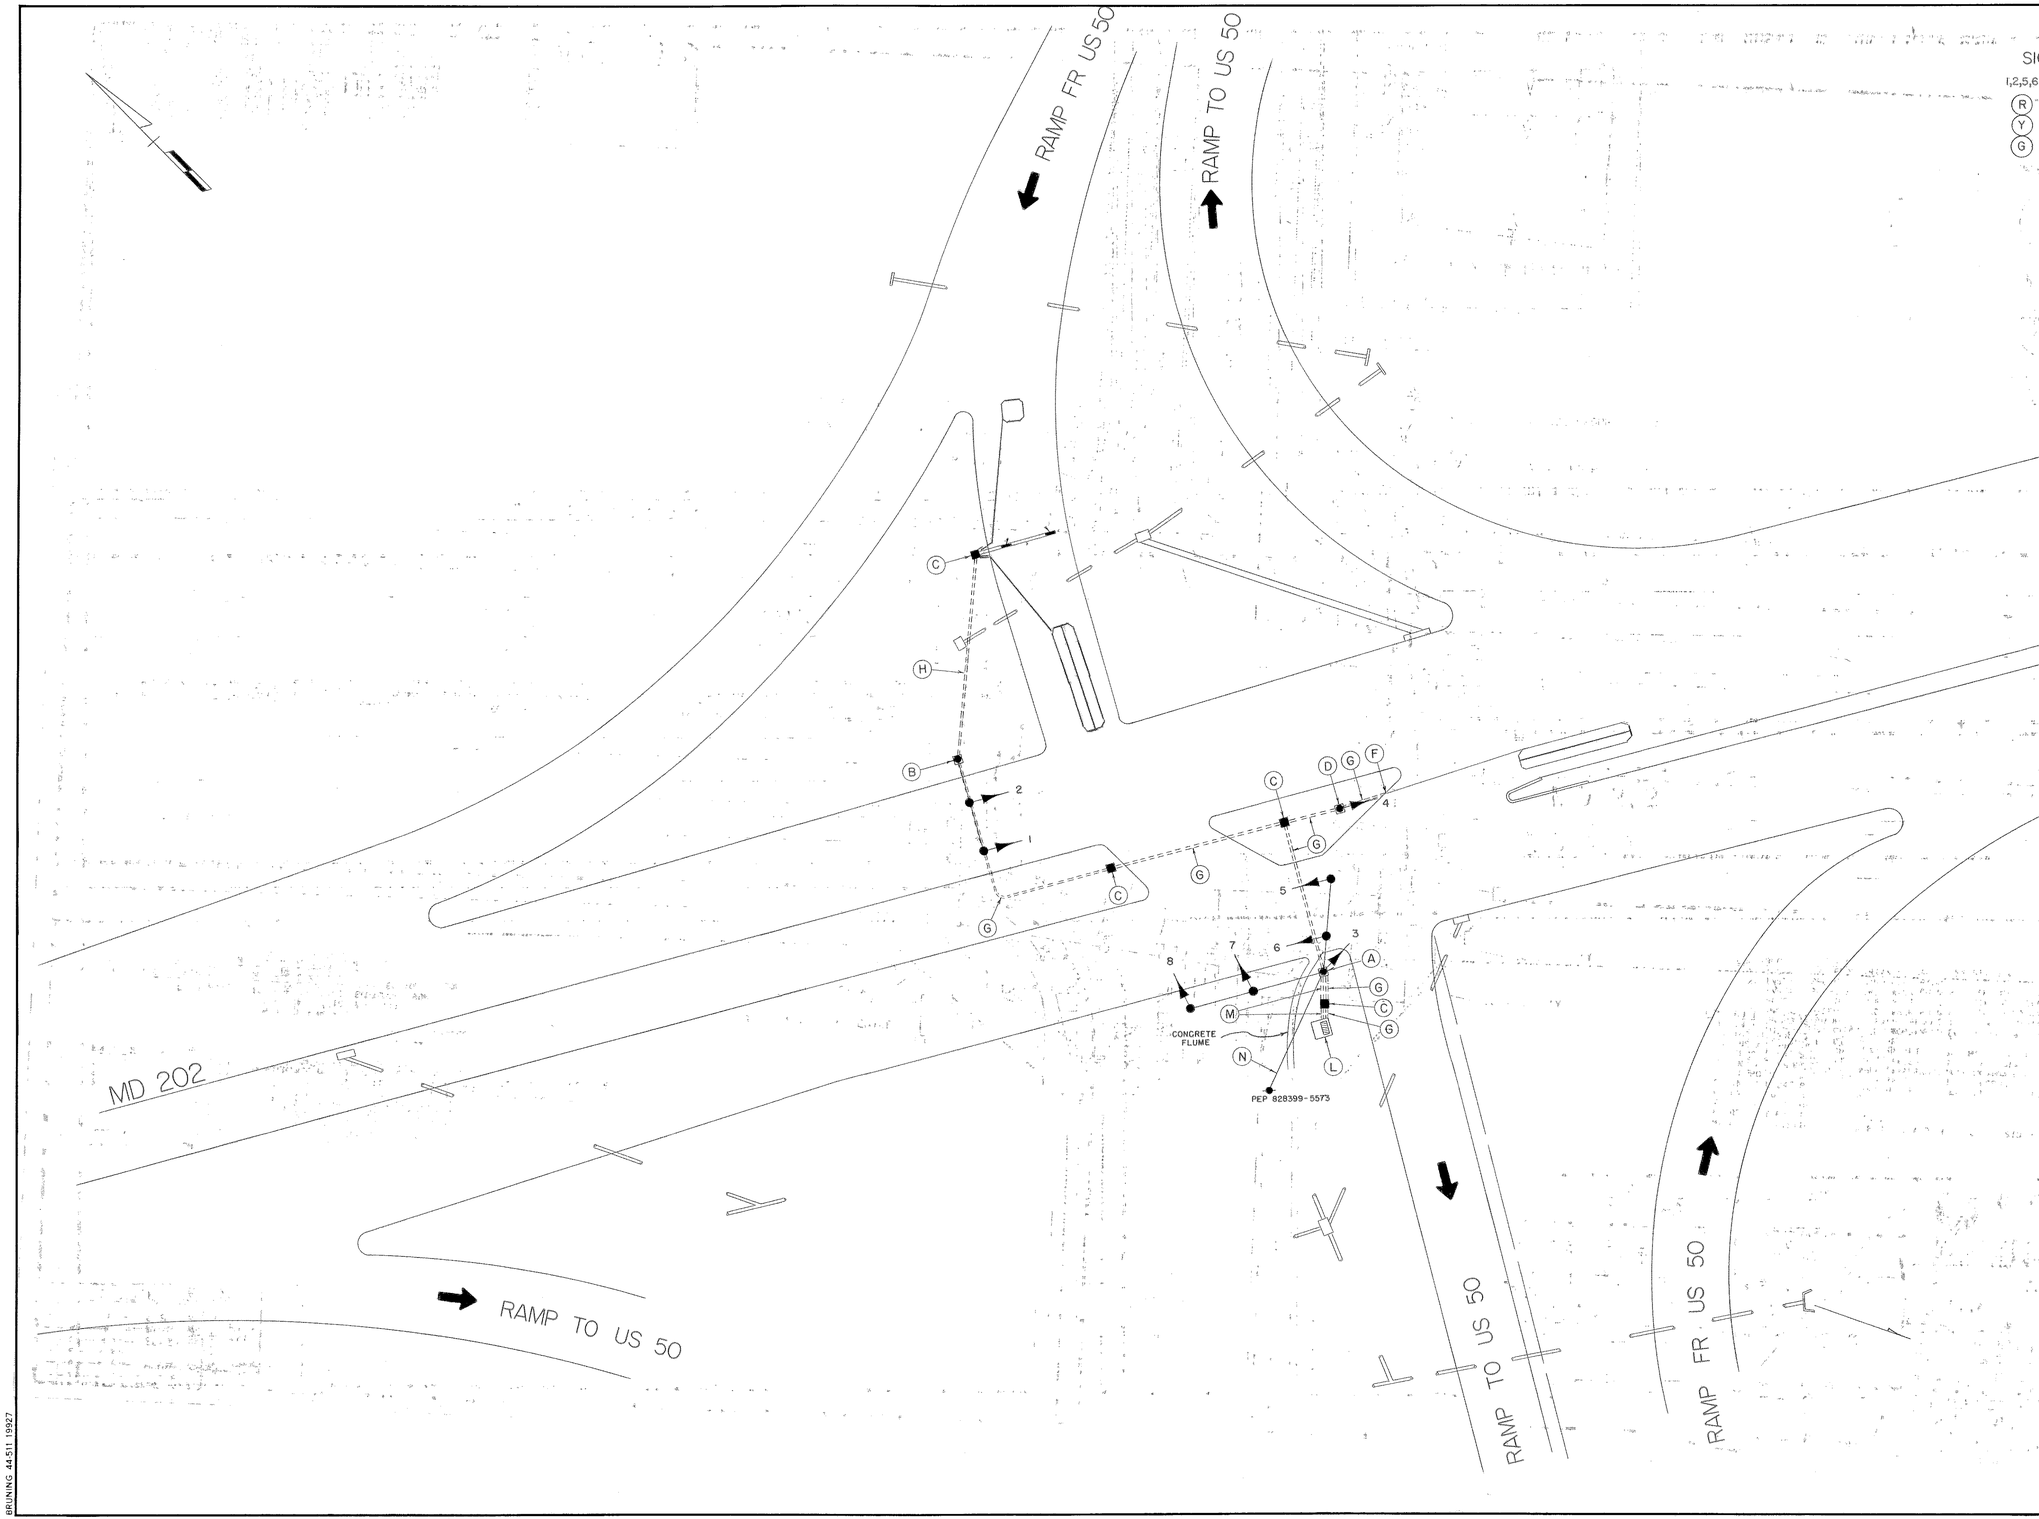

SIGNALS

1,2,5,6 7,8 3,4

PHASE A

PHASE B

PHASE C

FLASHING OPERATION

APPROVAL: REGIONAL TRAFFIC ENGINEER

APPROVAL: CHIEF-BUREAU OF TRAFFIC ENGINEERING

APPROVAL: ASS'T. CHIEF ENGINEER TRAFFIC

C - 10/4/74
ASBUILT
REDRAWN

REVISIONS

STATE OF MARYLAND
DEPARTMENT OF TRANSPORTATION
STATE HIGHWAY ADMINISTRATION

TRAFFIC DIVISION — BUREAU OF TRAFFIC ENGINEERING

MD 202 &
RAMPS TO & FR US 50

SCALE 1"=20' | DATE 10/4/74 | CONTRACT NO. P-225-1-376

DRAWN BY: R BRITTON | COUNTY: PRINCE GEORGES

DESIGNED BY: | SIGNAL NO.: 16313

CHECKED BY:

DRAWING NO. TS-522 C

BRUNING 44 511 19927